


CERTIFICATE of SURVEY

F. J. ARMSTRONG
Civil Engineer and Surveyor
ST. PAUL, MINN.

SIXTH ST.

ST.

DIVISION

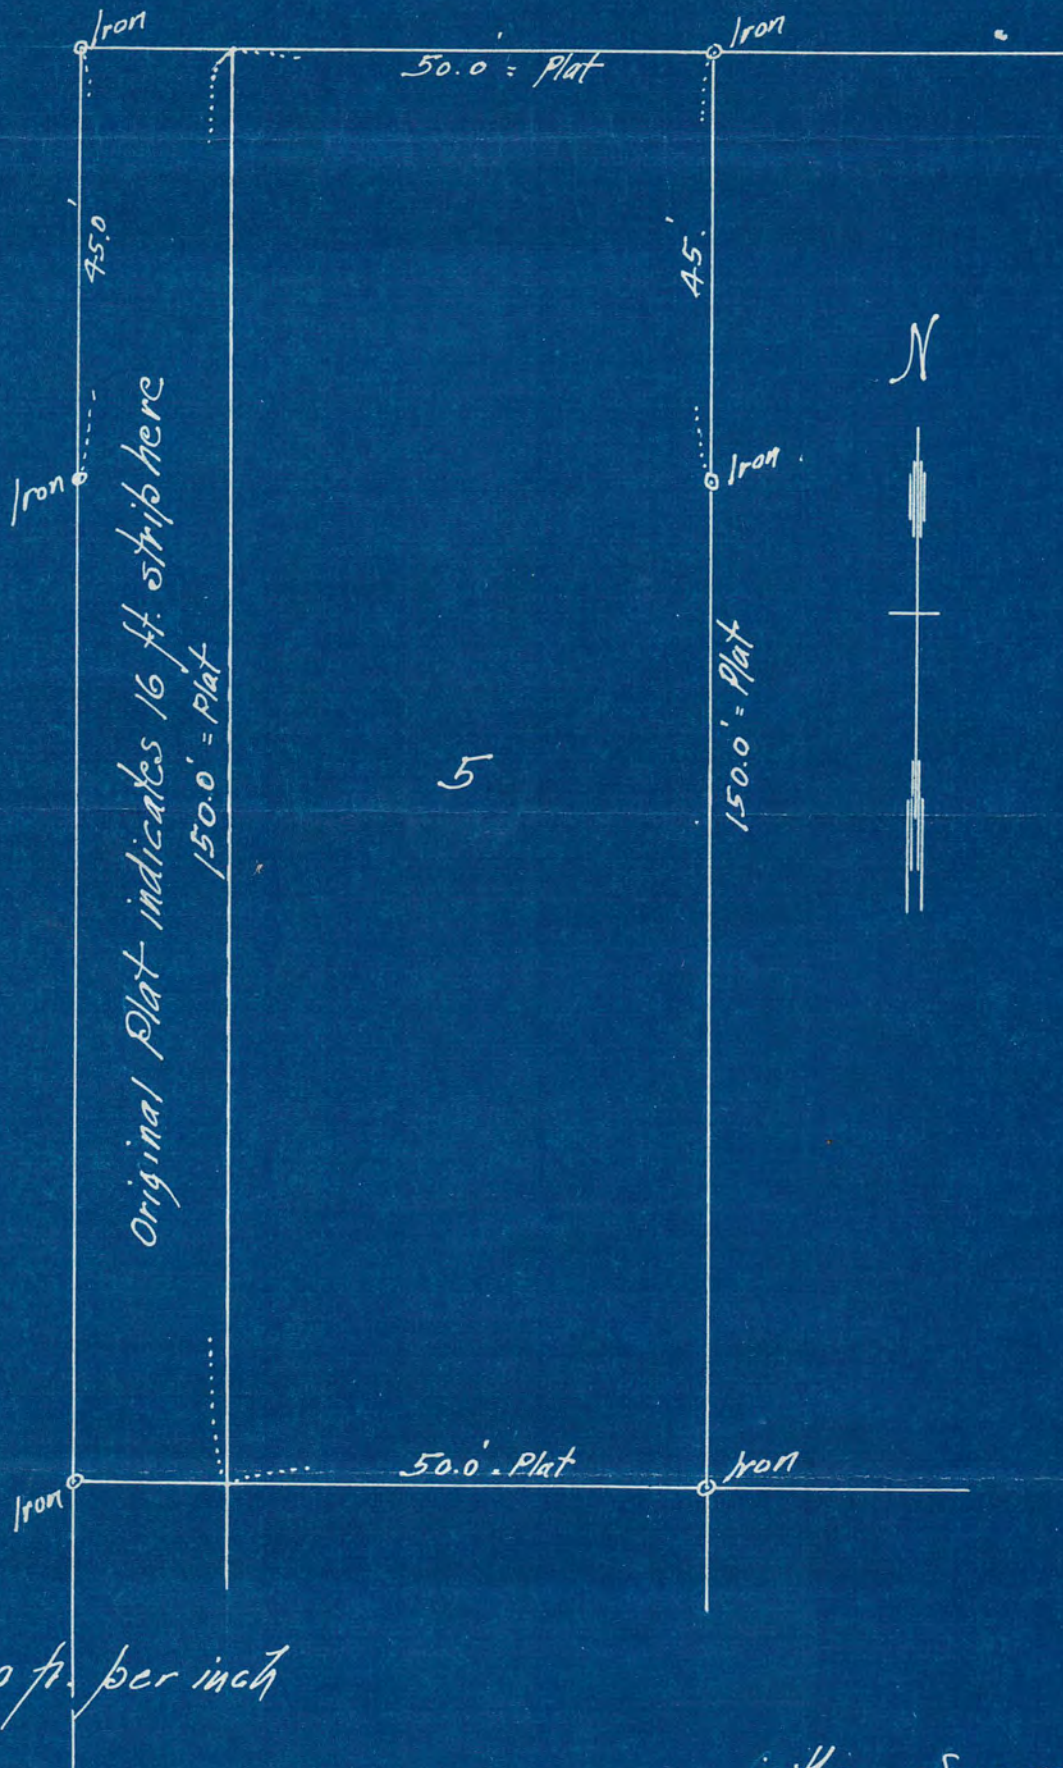

Scale 20 ft. per inch

7160

I HEREBY CERTIFY that on the in the day of Summer of, A. D. 1946,
I made a survey of the following described property, to-wit: Lot 5 Block 40
White Bear Ramsey Co. Minn

Subscribed and sworn to before me this
5th day of June, 1951
Arvid B. Bost
Notary Public.

and the map hereon shown is a true and correct map of said survey and that the improvements thereon
indicated are correctly shown.

My Commission Expires 10-29-56

F. J. Armstrong
Civil Engineer.