SURVEY OF

The West 660 ft. of that part of the S.W. 1/4 of Sec. 21, T. 29 N., R. 22 W. lying between Hyacinth and Orange Aves., excepting those parts taken for Mendota St. and Arcade St.

APRIL 12, 1944.

R. A. Wolfgram
REGISTERED SURVEYOR.
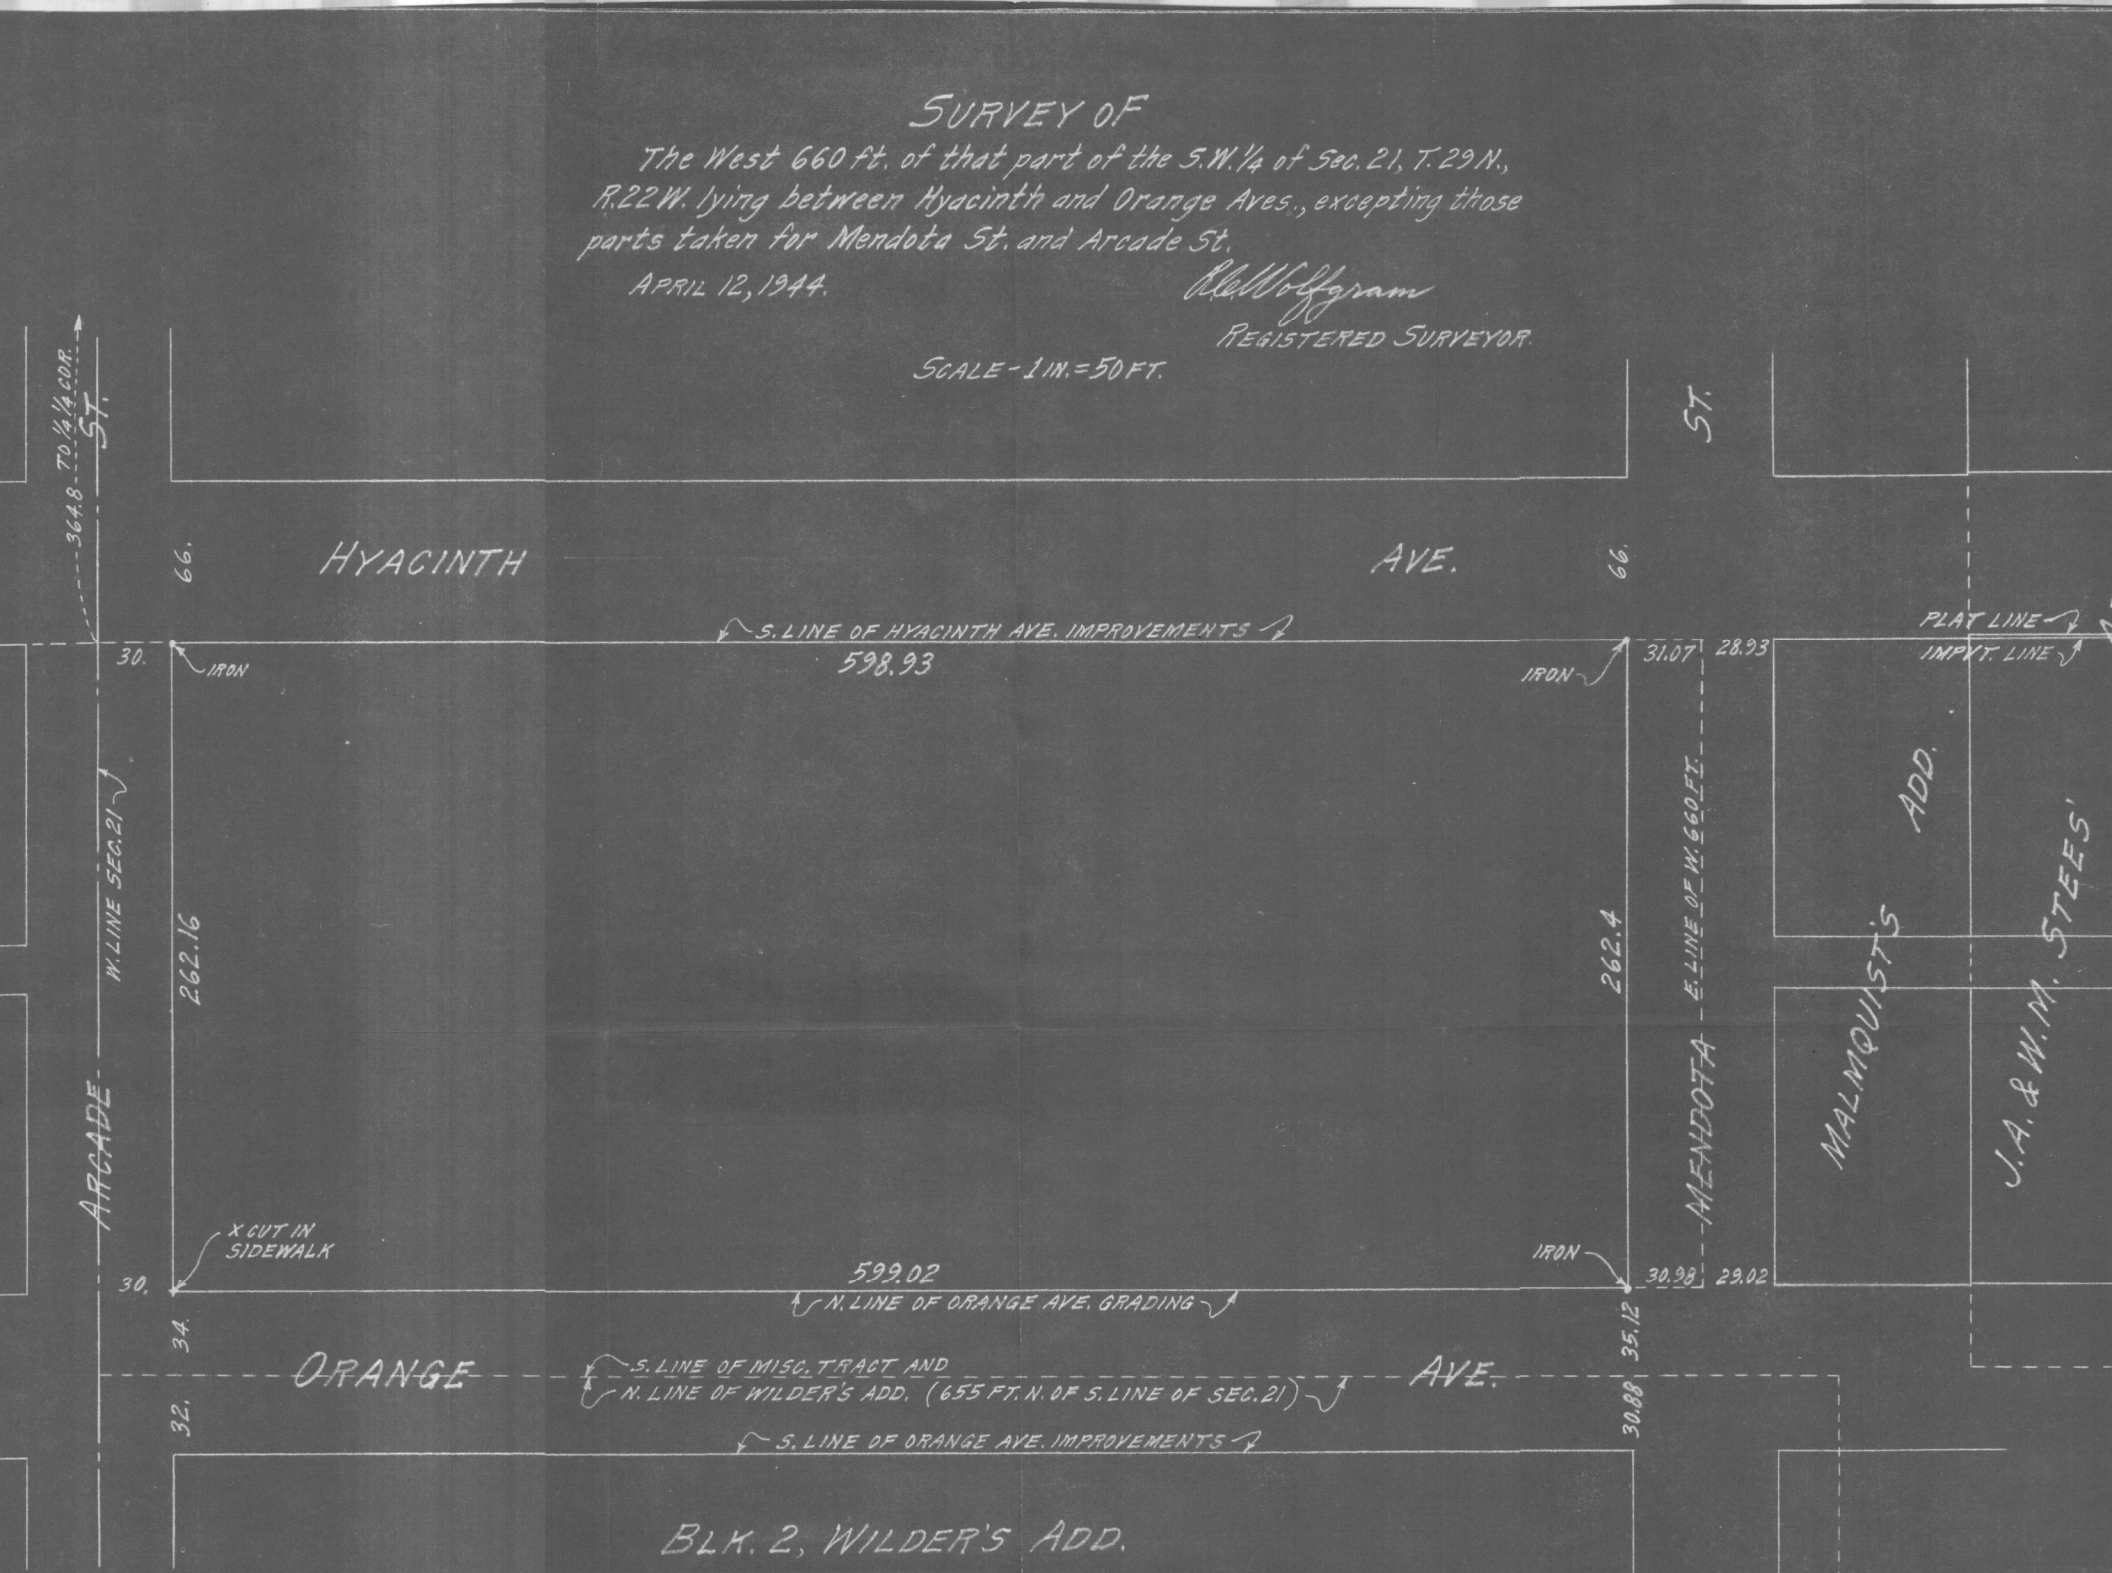
SCALE - 1 IN. = 50 FT.