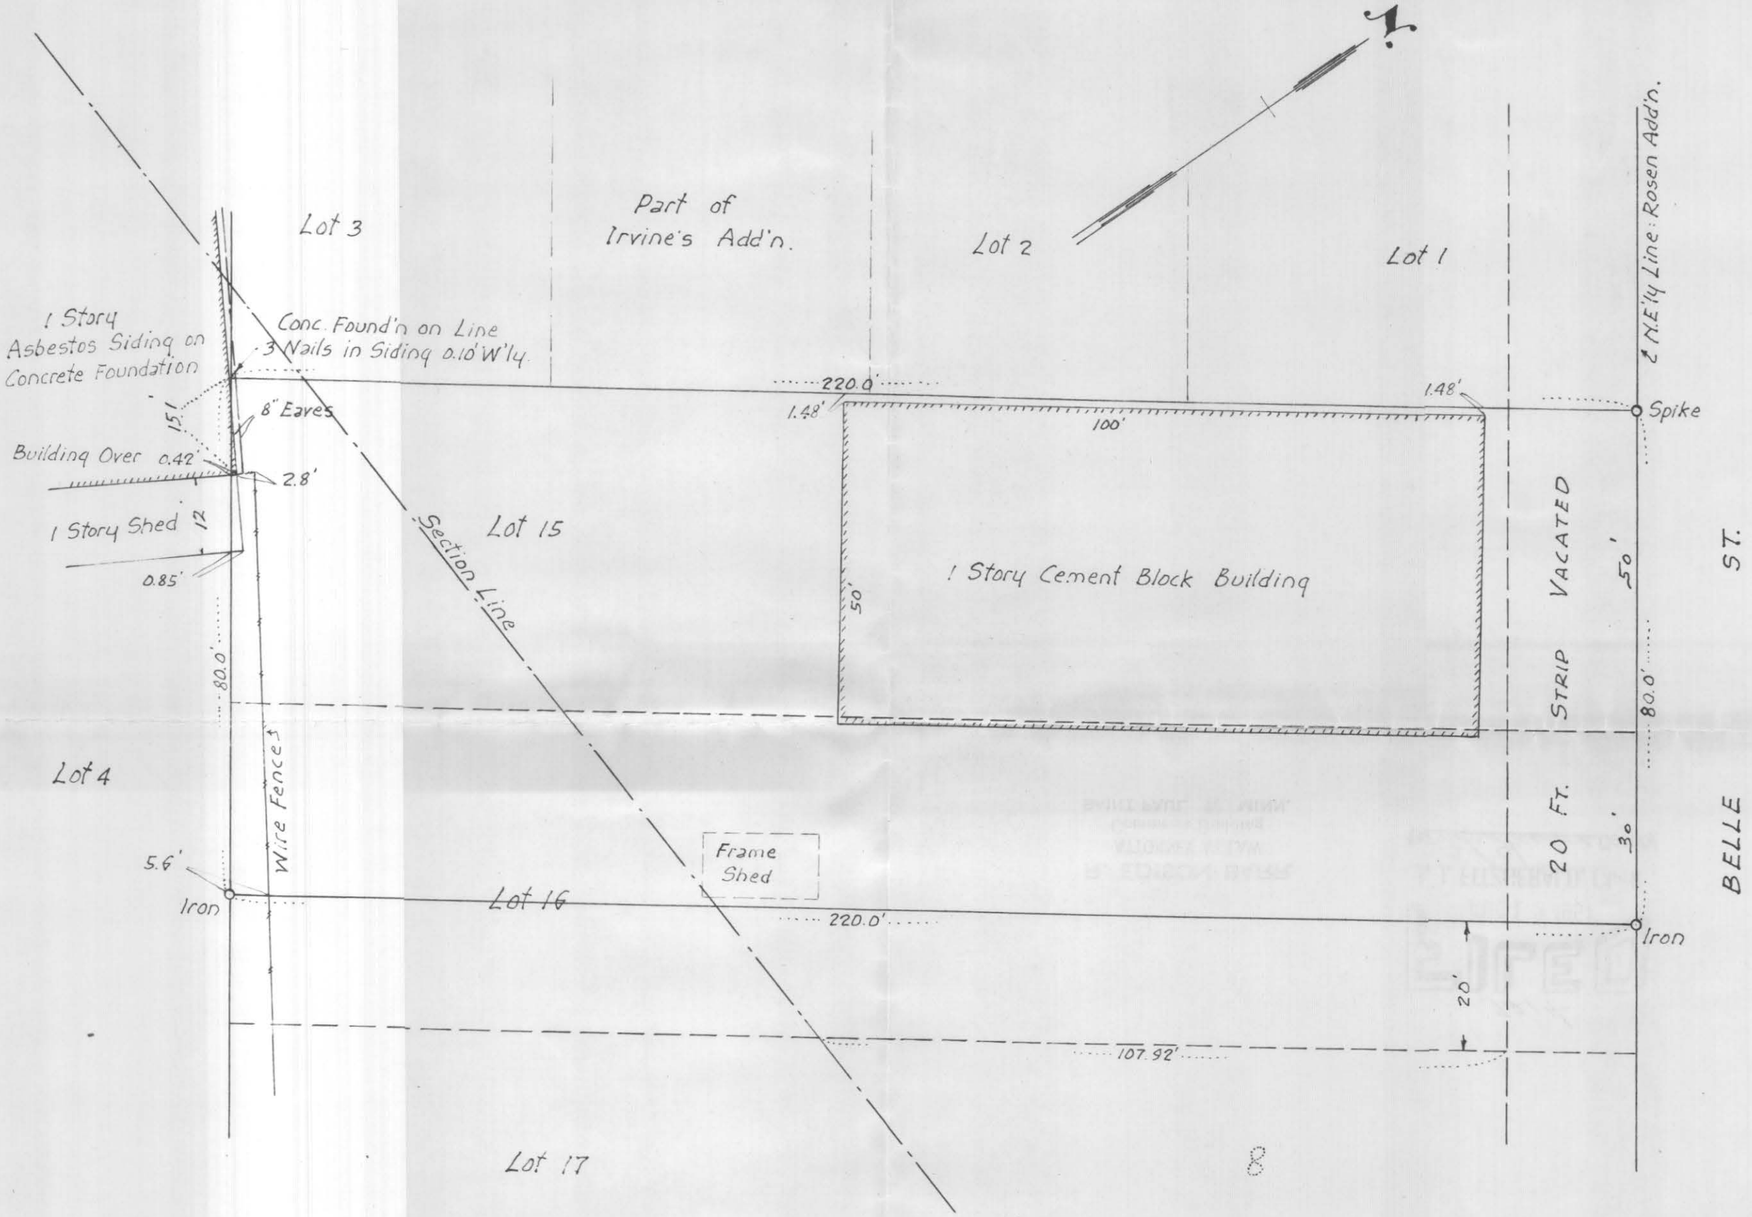

Subscribed and sworn to before
me this 6th day of August
1951.

Lorena C. Back
Notary Public. Ramsey Co., Minn.

My Commission Expires Oct 29, 1956

PLAT OF SURVEY OF

Lot 15 and, excepting the Southeasterly
20 feet thereof, Lot 16 of Rosen Add'n
St. Paul, Minn.

August 6, 1951 Scale: 1" = 20'

I hereby certify that this is a true and correct plat of the above described property as surveyed by me this 6th day of August, 1951, and that there are no encroachments except as indicated.

H. Armstrong
Civil Engineer and Surveyor

#7214