

File 7258

THE E. B. McDONOUGH CO.
1953 UNIVERSITY AVE., SAINT PAUL 4
400 NATIONAL BUILDING, MINNEAPOLIS 2


TELEPHONES { MI 3201
GE 9441
EM 5072

SCALE: 1 INCH 20 FEET

PLAT OF SURVEY

OF PROPERTY OF Robert J. Garrity, 517 Carroll Ave., St. Paul, Minn.

DESCRIBED AS FOLLOWS Lot 3, Block 2, except the alley, Auditor's Subdivision
No. 31, St. Paul, Minn.

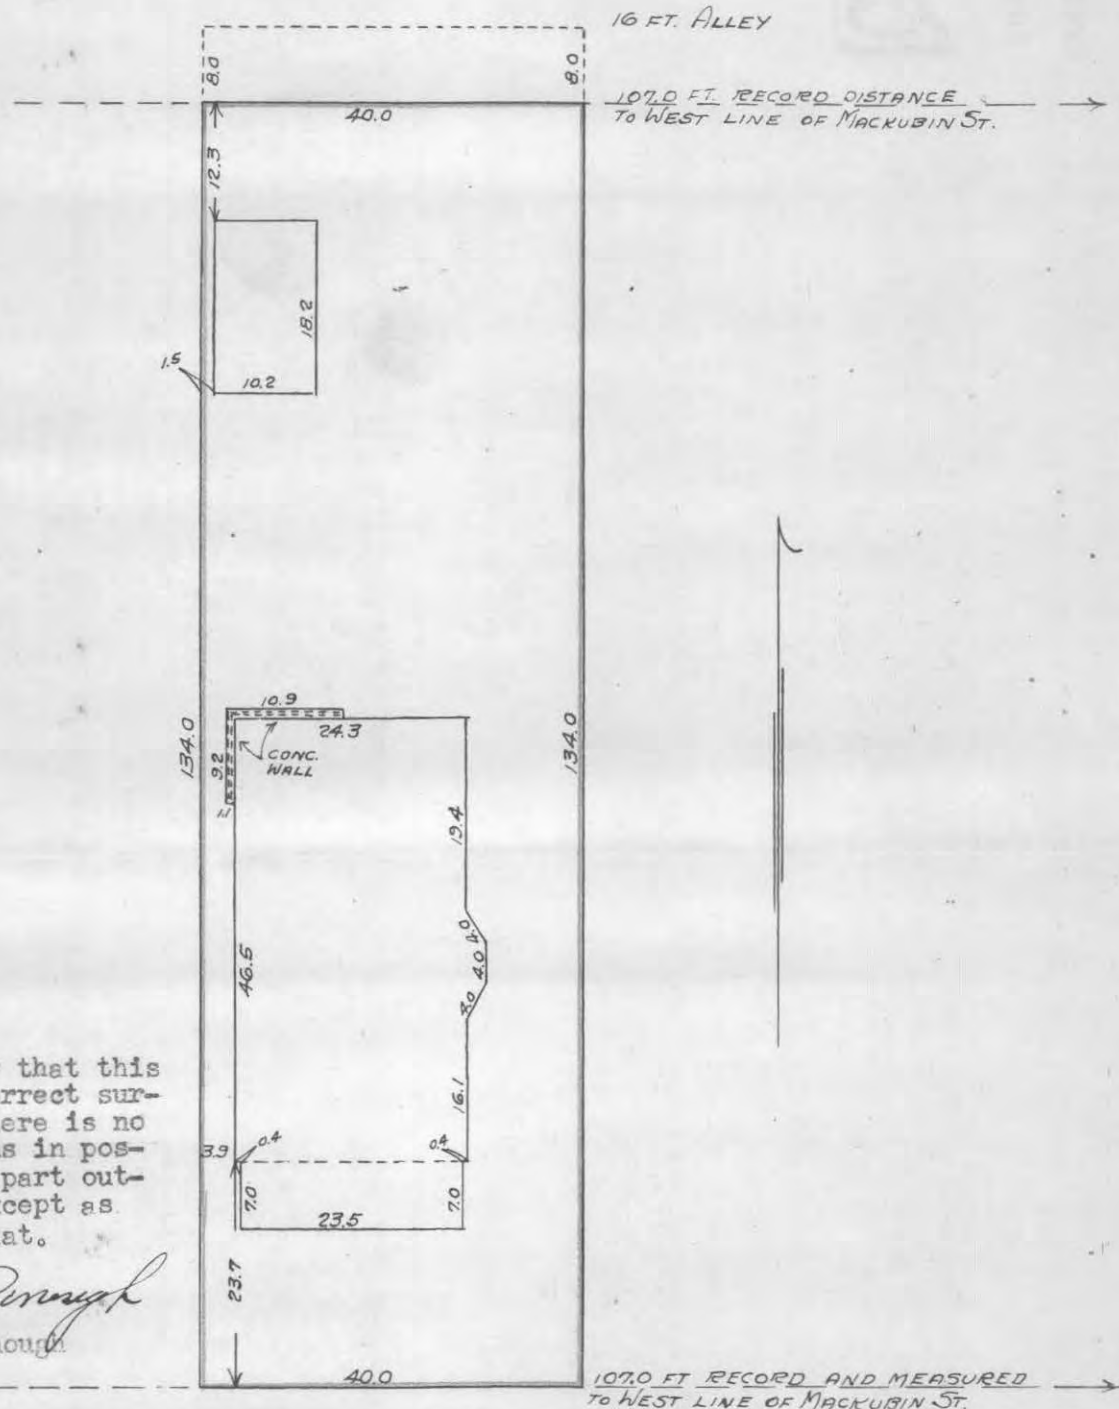

I hereby certify that this is a true and correct survey, and that there is no person or persons in possession of that part outlined in red, except as shown on this plat.

E. B. McDonough
E. B. McDonough

CARROLL AVENUE

CERTIFICATE OF LOCATION OF BUILDING

I hereby certify that on 11-20 1951
I made a survey of the location of the building(s) on the above described property and that the location of said building(s) is correctly shown on the above plat.

E. B. McDonough

CERTIFICATE OF SURVEY

I hereby certify that on _____ 19____
I surveyed the property described above and that the above plat is a correct representation of said survey.

E. B. McDONOUGH, REGISTERED SURVEYOR, NO. 1990
DONALD O. WEBER, REGISTERED SURVEYOR, NO. 665

#7258