


CERTIFICATE of SURVEY

F. J. ARMSTRONG
Civil Engineer and Surveyor
ST. PAUL, MINN.

N

FAIRFIELD AVE.

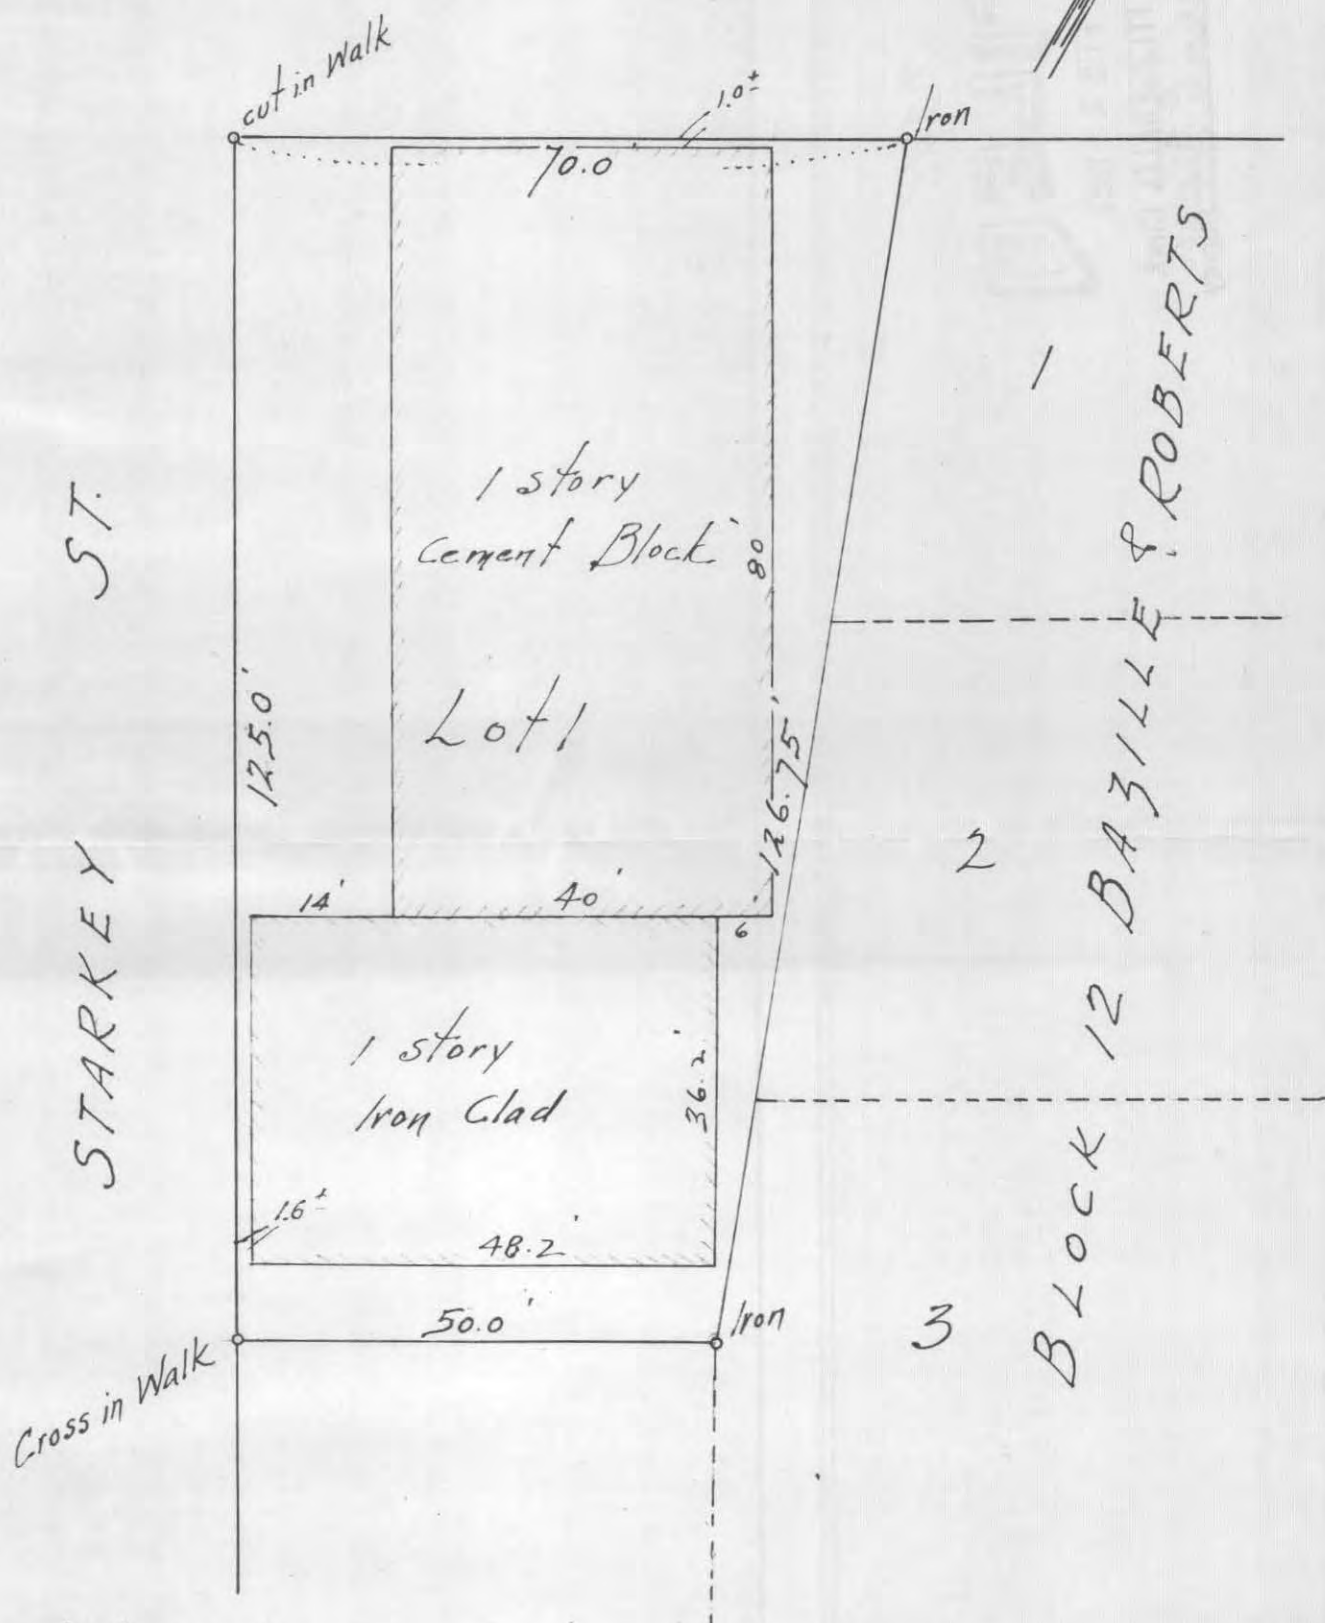

Scale 20 ft. per inch

I HEREBY CERTIFY that on the 5th day of February, A. D. 1952.

I made a survey of the following described property, to-wit: Lot 1 in Block 173
Robertson's Addn to W. St. Paul
St. Paul, Minn.

Subscribed and sworn to before me this
5 day of Feb, 1952
Helen O. Anderson
Notary Public.

and the map hereon shown is a true and correct map of said survey and that the improvements thereon indicated are correctly shown and there are no encroachments thereon

My Commission Expires HELEN O. ANDERSON
Notary Public, Ramsey County, Minn.
My Commission expires Sept. 20, 1953

F. J. Armstrong Civil Engineer.

4-81 #17346