7347

PLAT OF SURVEY OF PART OF MANN'S REA. OF PART OF BLOCK 5 LEECH'S ADDITION TO THE CITY OF ST. PAUL DESCRIBED AS: LOTS 8 & 9, AND THAT PART OF LOTS 3-4-5-6 & 7 LYING WEST OF A LINE 59 FT. WEST OF AND PARALLEL WITH THE EAST LINE OF SAID REARRANGEMENT.

Nov. 12th 1951

F. J. Armstrong
Civil Engr

Scale 10 ft. per inch

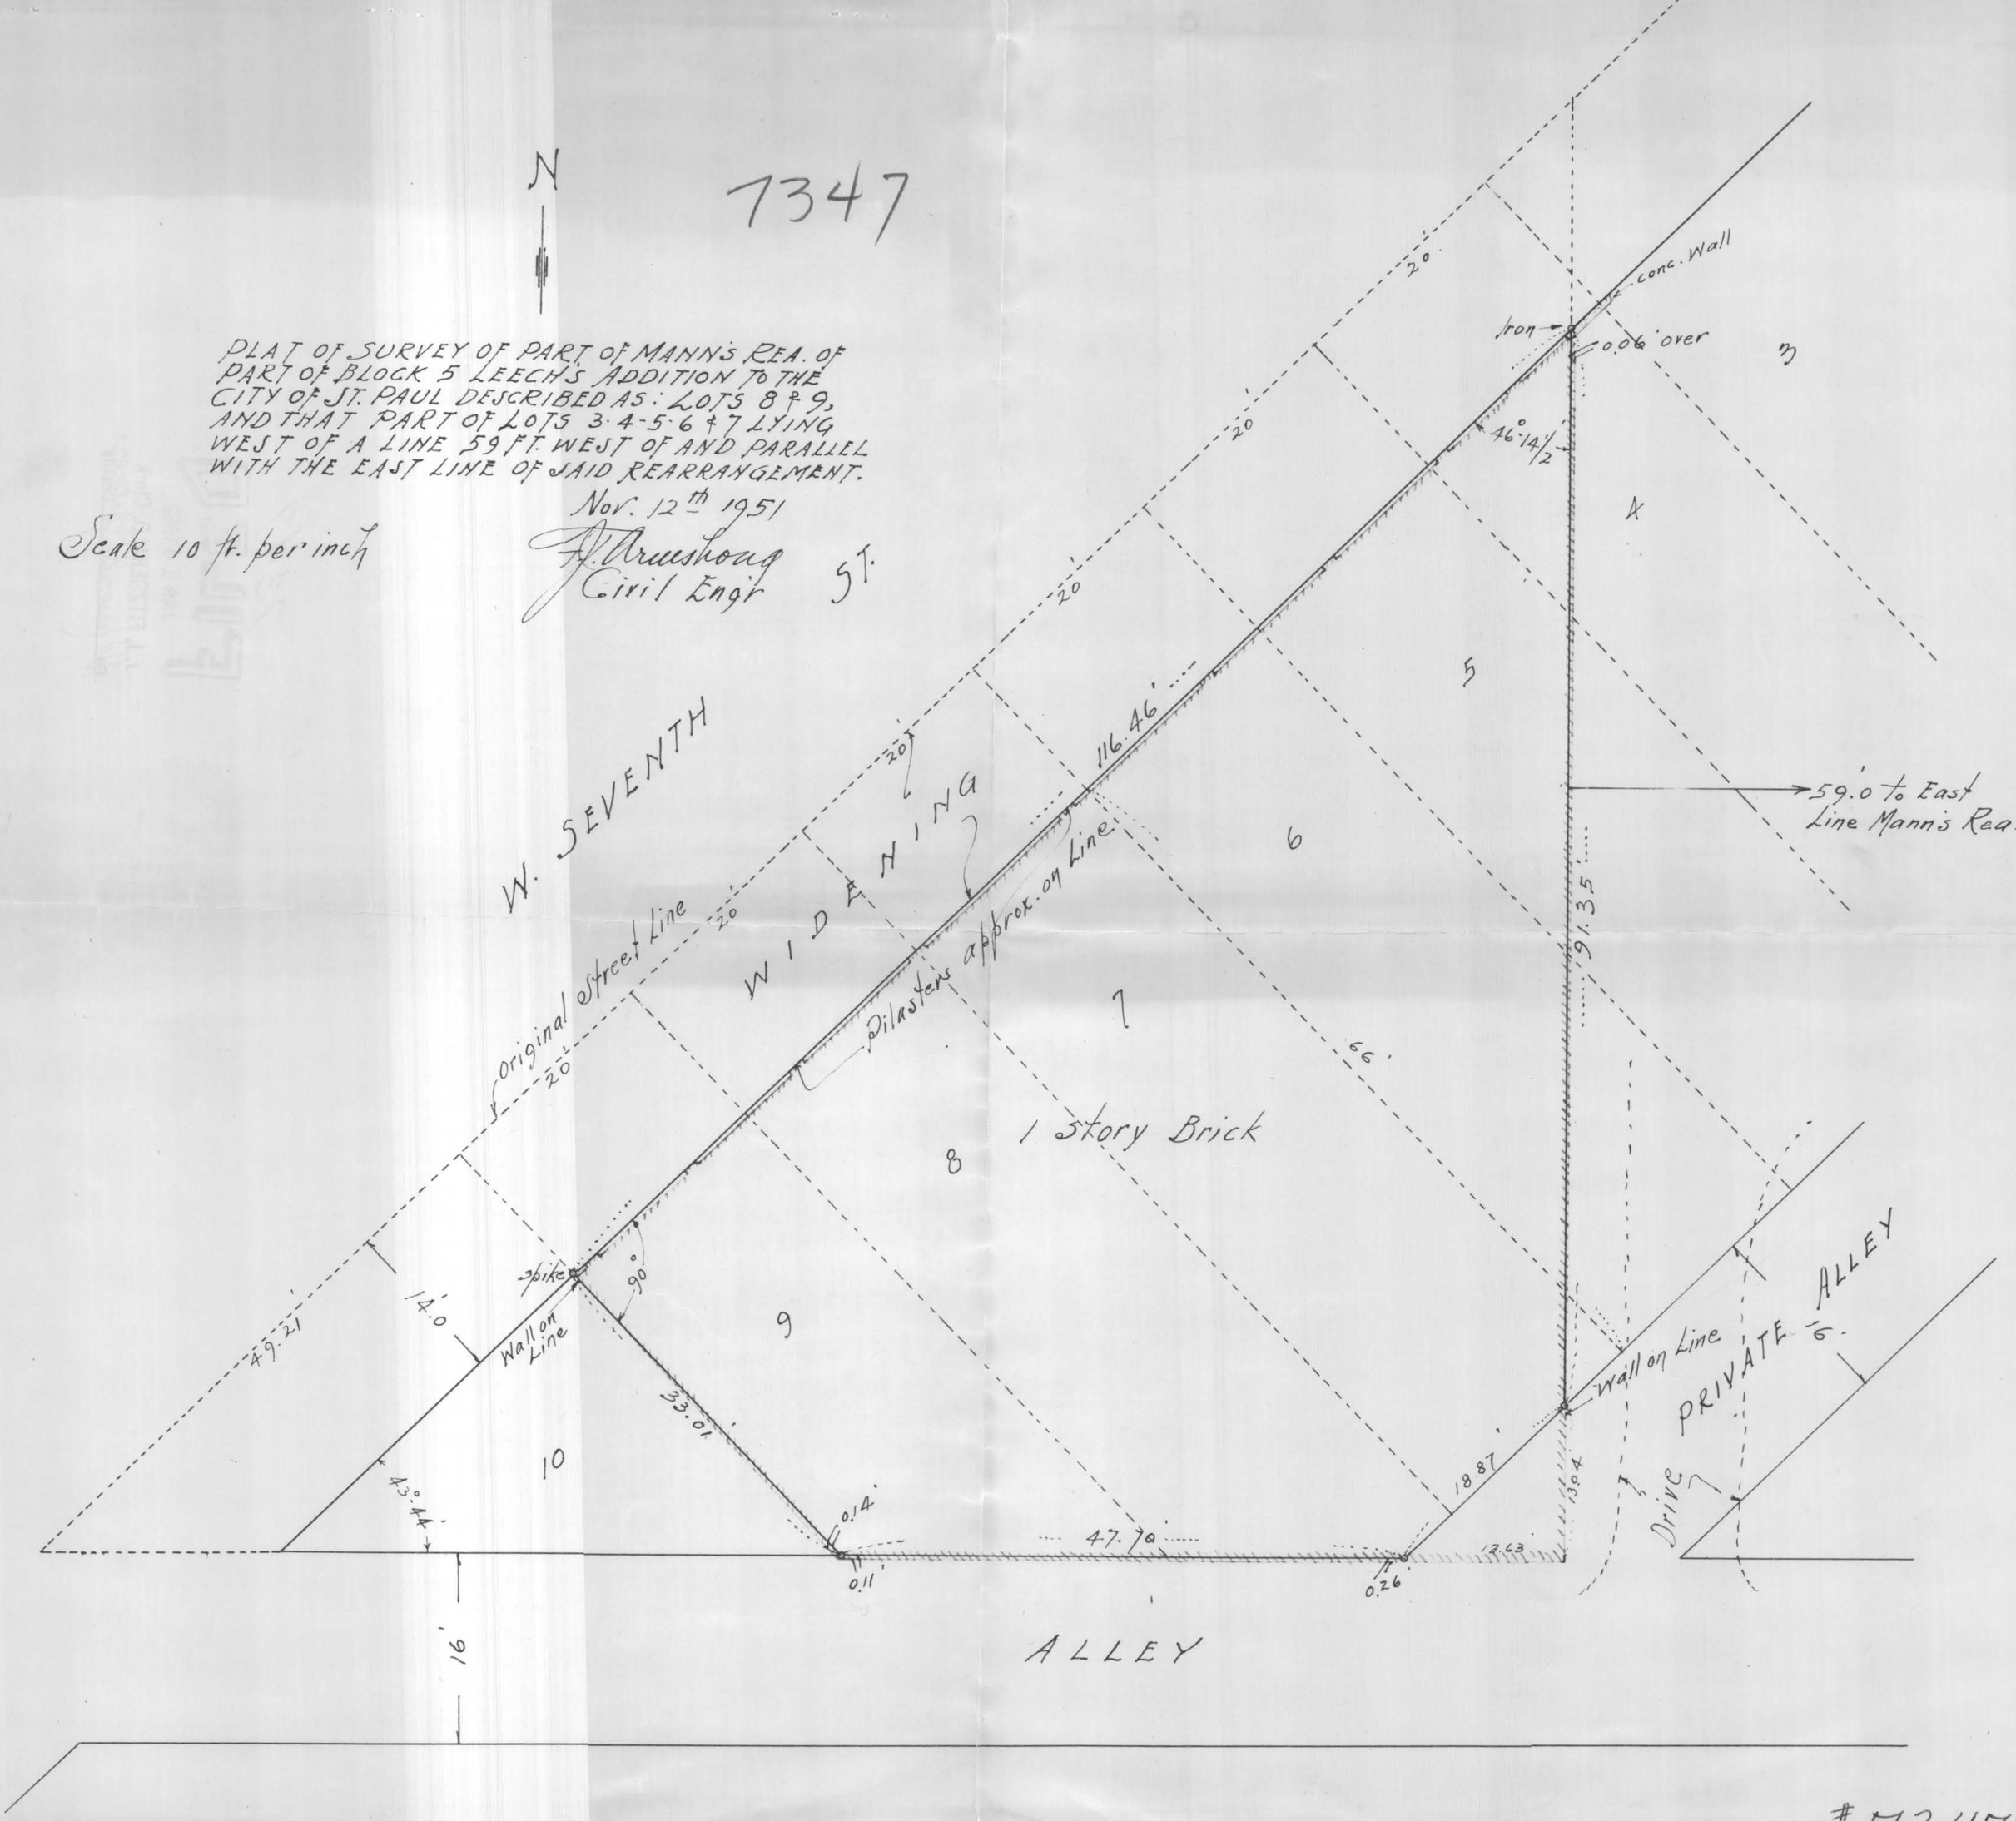

#7347