


PLAT OF SURVEY

OF PROPERTY OF _____

DESCRIBED AS FOLLOWS *North 74 feet of West 100 feet of Lot 6, Block 3,
Furness' Garden Lots*

SCALE: 1 INCH *50* FEET
o Indicates Iron.

T. J. WELCH, REGISTERED SURVEYOR
738 SURREY AVENUE, ST. PAUL, MINN.

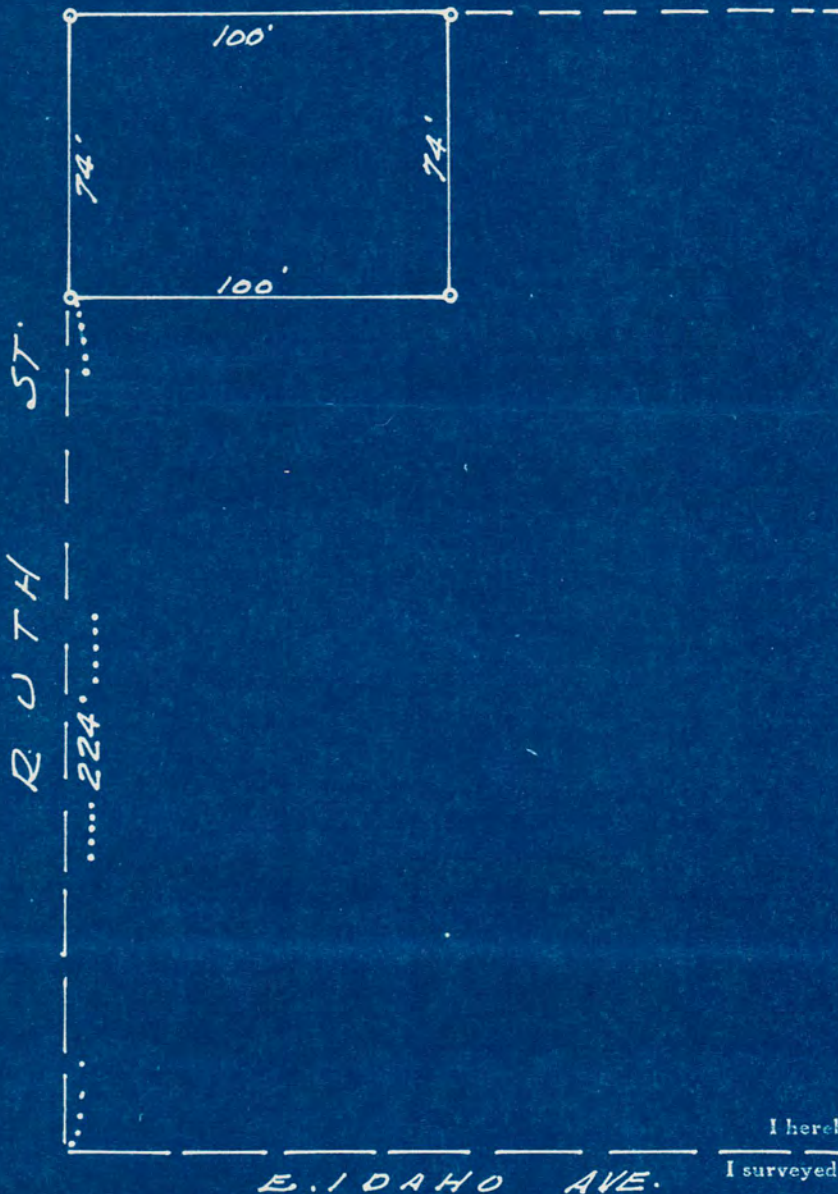

NORTH

CERTIFICATE OF SURVEY

I hereby certify that on *6-19* 19*47*.

I surveyed the property described above and that the above plat is a correct representation of said survey.

J. J. Welch

7394


PLAT OF SURVEY

OF PROPERTY OF _____

DESCRIBED AS FOLLOWS *South 50 feet of North 174 feet of West 100 feet of Lot 6, Block 3, Furness Garden Lots.*

SCALE: 1 INCH *50* FEET
o *Indicates Iron.*

T. J. WELCH, REGISTERED SURVEYOR
738 SURREY AVENUE, ST. PAUL, MINN.

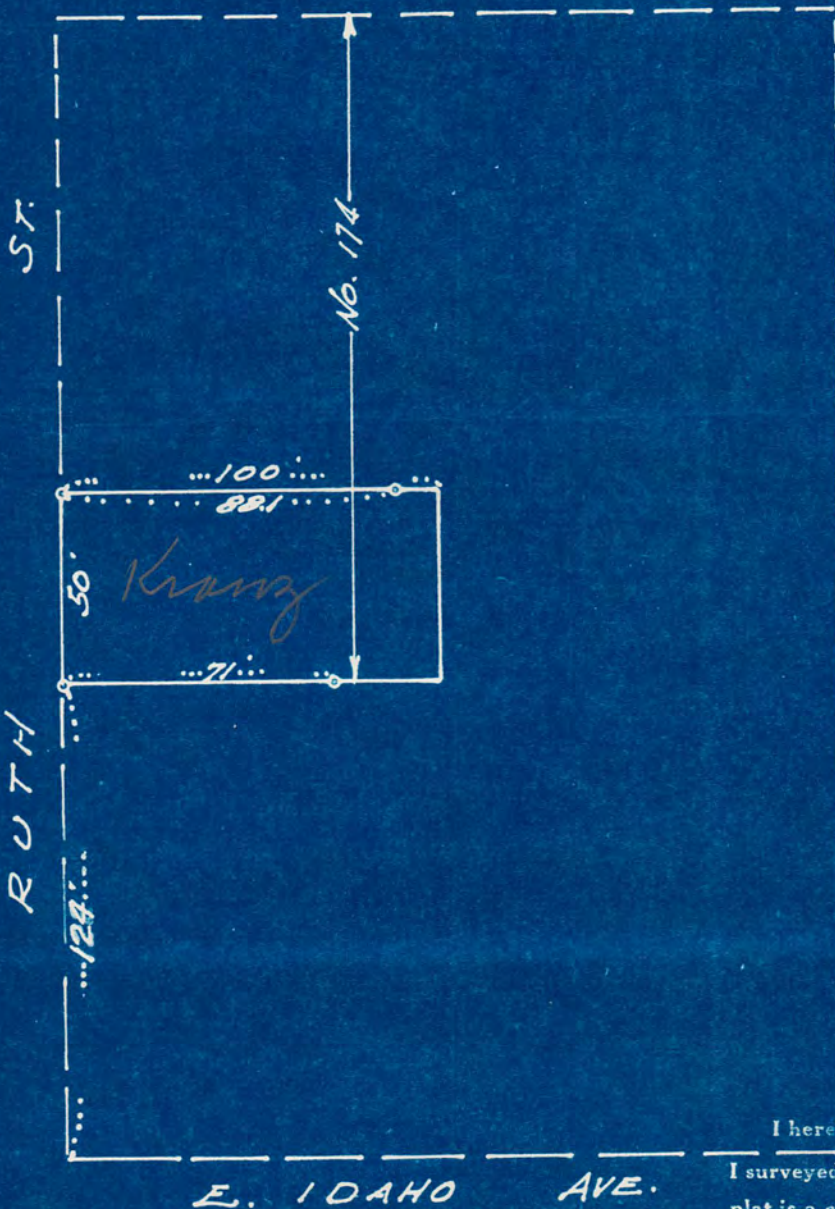

NORTH

CERTIFICATE OF SURVEY

I hereby certify that on *6-19* 19 *47*.

I surveyed the property described above and that the above plat is a correct representation of said survey.

T. J. Welch

7394

PLAT OF SURVEY

OF PROPERTY OF _____

DESCRIBED AS FOLLOWS *South 50 feet of North 124 feet of West 100 feet of Lot 6.
Block 3, Furness' Garden Lots.*

SCALE: 1 INCH 50 FEET
o Indicates Iron.

T. J. WELCH, REGISTERED SURVEYOR
738 SURREY AVENUE, ST. PAUL, MINN.



NORTH

CERTIFICATE OF SURVEY

I hereby certify that on 6-19 1947.

I surveyed the property described above and that the above plat is a correct representation of said survey.

J. J. Welch.

7394