


7534

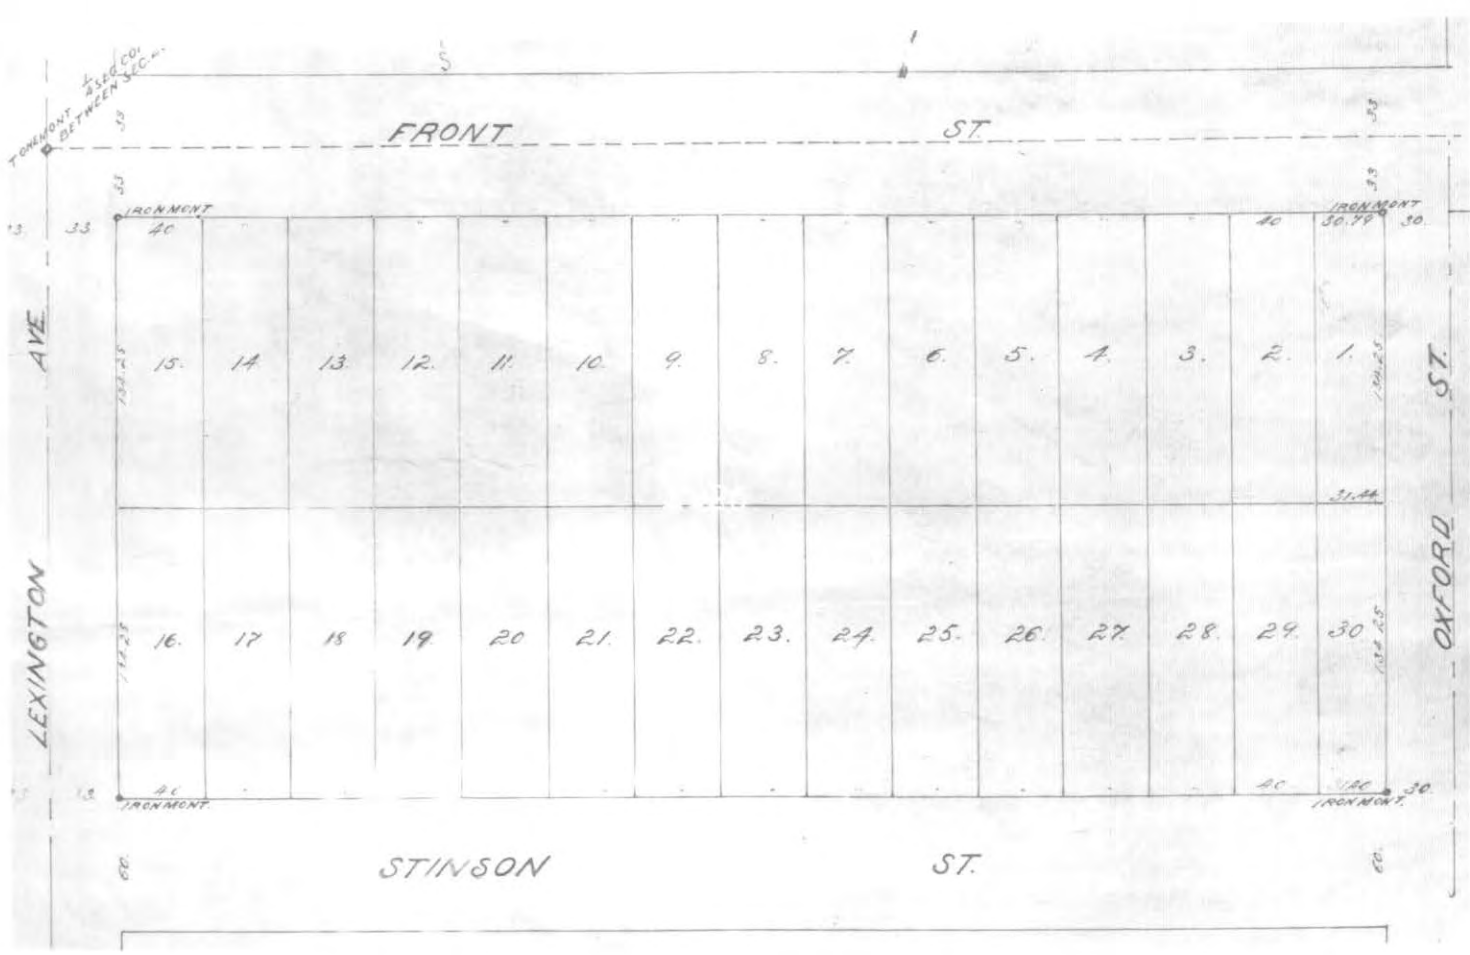

#7534