


CERTIFICATE of SURVEY

F. J. ARMSTRONG
Civil Engineer and Surveyor
ST. PAUL, MINN.

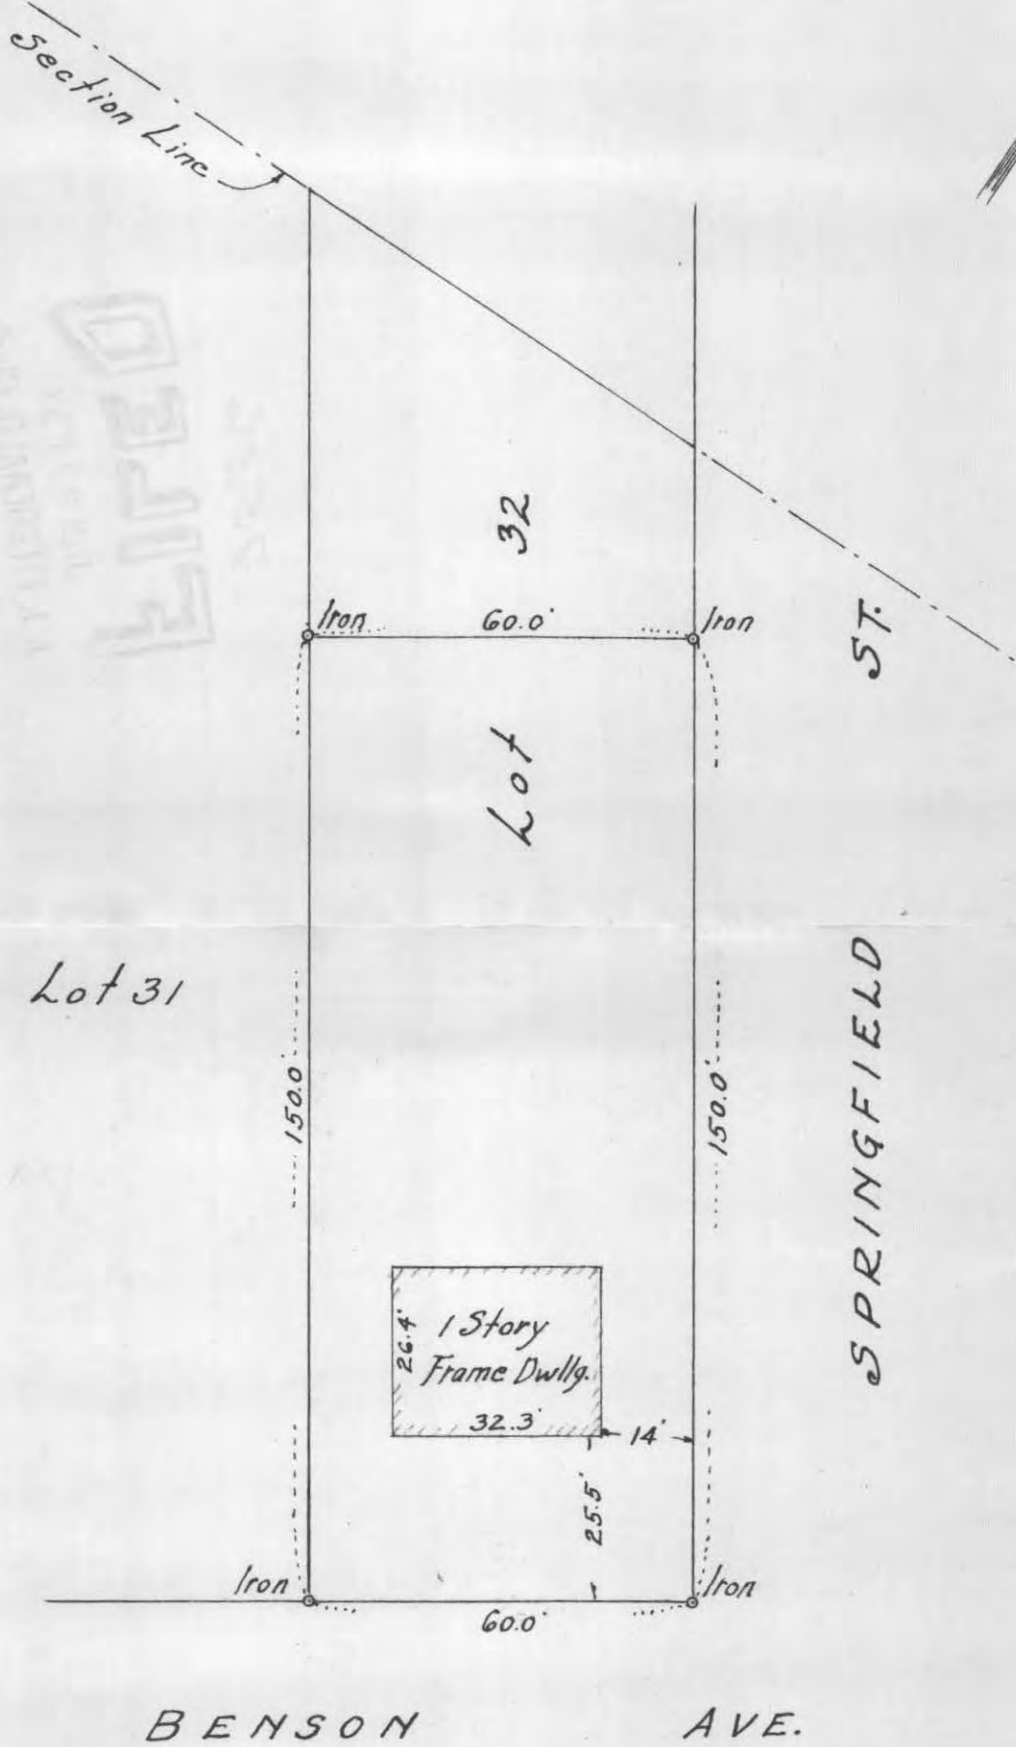

Scale: 30 ft. per inch

I HEREBY CERTIFY that on the 31st day of December, A. D. 1952
I made a survey of the following described property, to-wit: The Southeasterly 150 feet
of Lot 32 Block 3 Palisade Addition to St Paul

and the above map is a true and correct map of said survey, and the improvements shown thereon are correctly indicated and there are no encroachments unto said property

Subscribed and sworn to before me this 31st day of December, 1952

Helmer O. Anderson
Notary Public.

My Commission Expires Sept 20-1958

F. J. Armstrong Civil Engineer

#7536