

# IRVINES ENLARGEMENT.

SURVEY OF

LOT 4 EXCEPT NLY 8 FT AND SLY 25 FT. BL 63

NOV. 7-1908

JENS PEDERSEN

SCALE 20' = 1"

SURV.


ST. PAUL NOV 7-1908

I HEREBY CERTIFY TO HAVING SURVEYED  
LOT 4 EXCEPT NLY 8 FT AND SLY 25 FT OF SAID LOT  
4. BL 63 IRVINES ENLARGEMENT AND HAVE  
PLACED STAKES AT THE CORNERS AND MADE  
LOCATIONS AS INDICATED ON THIS MAP.  
AND THE SAME IS CORRECT

Jens Pedersen  
SURVEYOR.

758

60' W. THIRD ST. 60'

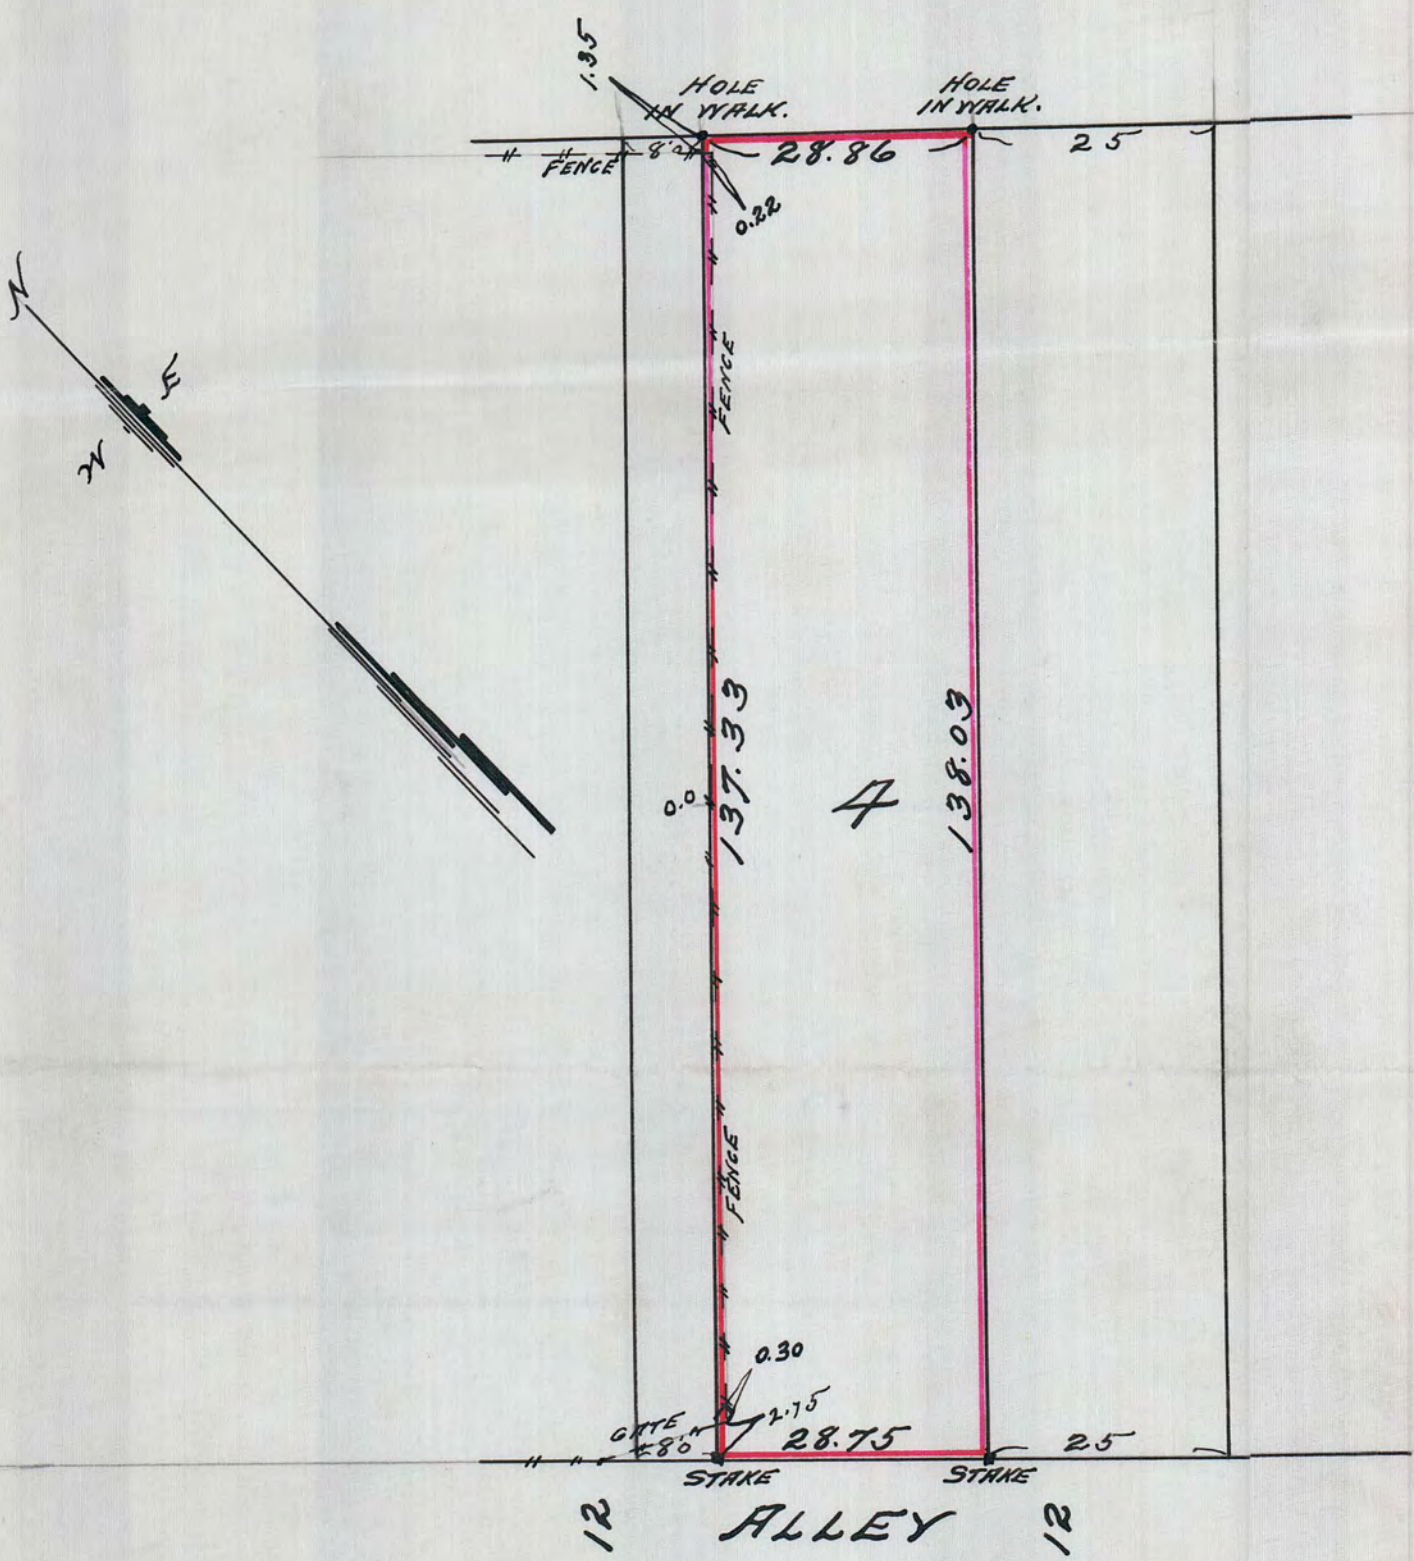

# 758