


CERTIFICATE of SURVEY

F. J. ARMSTRONG
Civil Engineer and Surveyor
ST. PAUL, MINN.

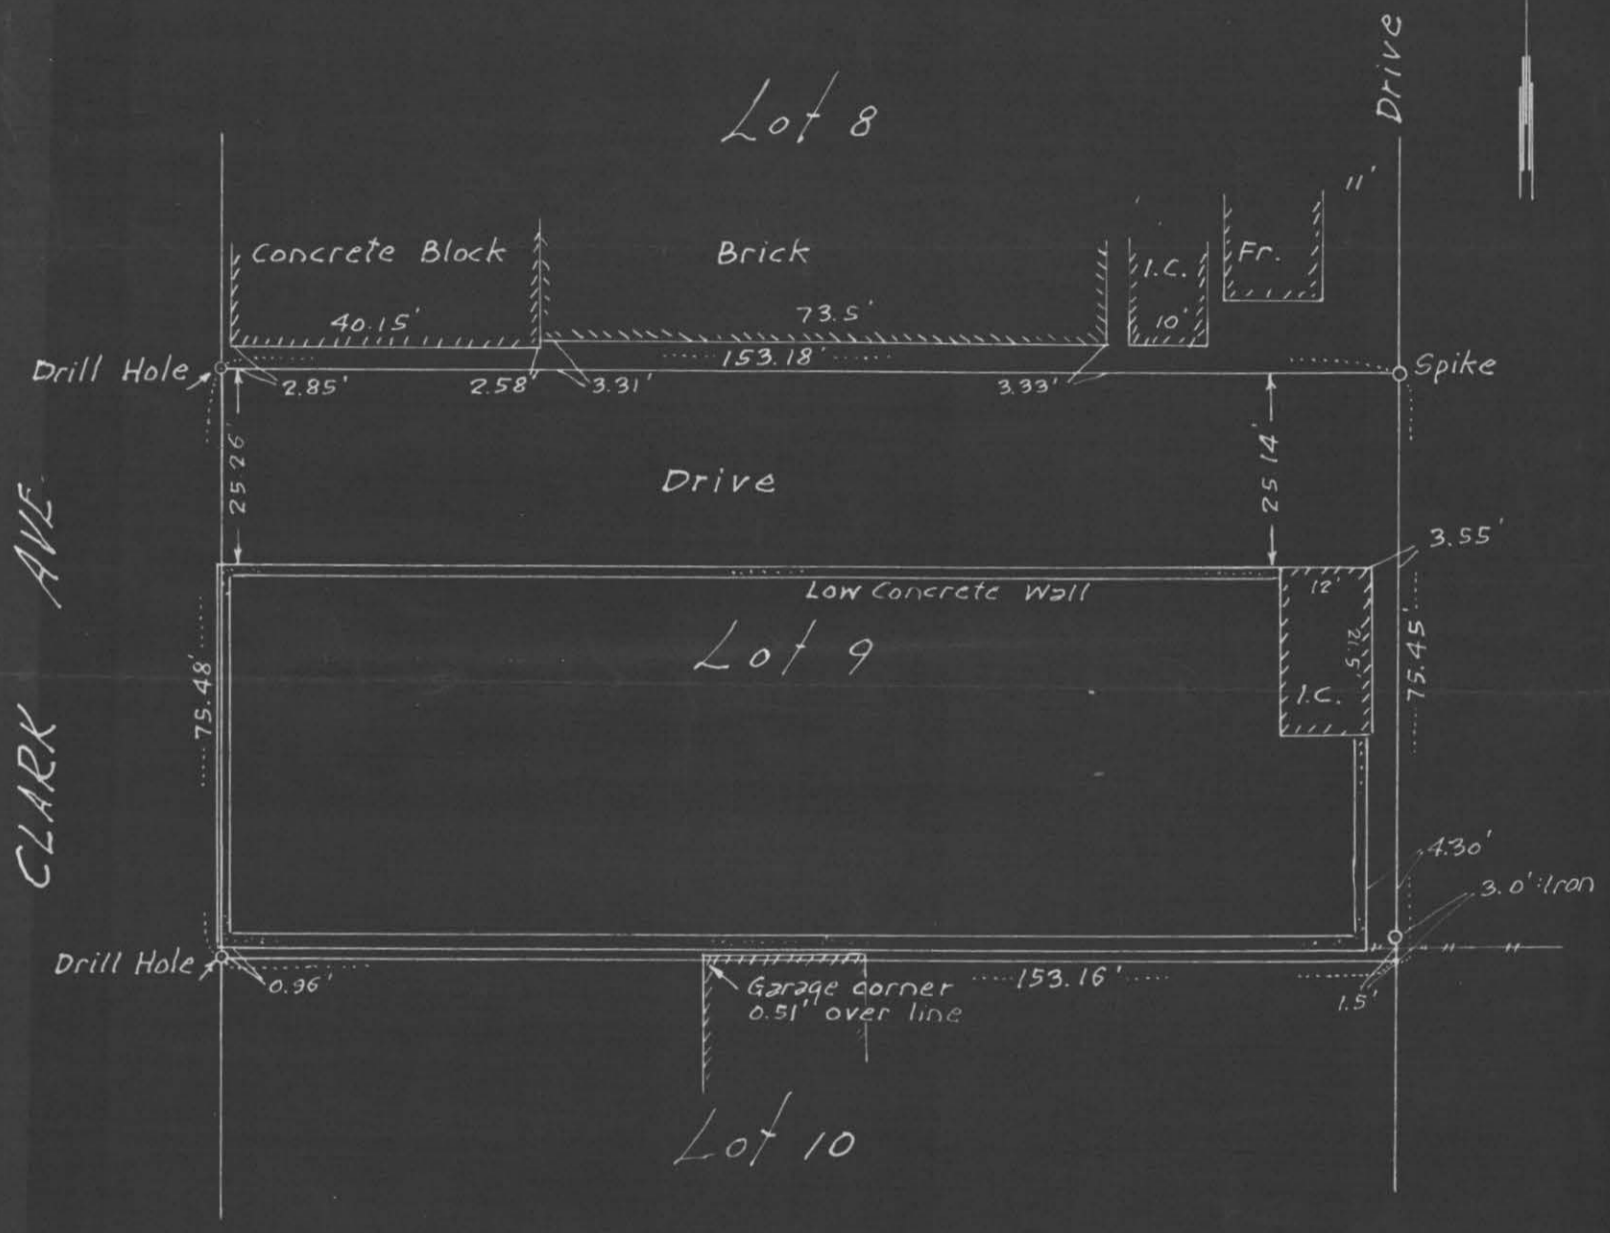

Scale: 1" = 25'

I HEREBY CERTIFY that on the 28th day of July A. D. 1952

I made a survey of the following described property, to-wit: Lot 9 Block 60
White Bear Lake, Minn.

Subscribed and sworn to before me this
..... day of, 19.....

Notary Public.

and the above map is a true and correct map of said survey and the improvements shown thereon are correctly indicated

My Commission Expires

F. J. Armstrong
Civil Engineer

7588