17 x 17

Survey of Lot 4-5 & Lots 34-35
Blk 1 Cox's 2nd Add. Exc.
R.R. R/W and Lots 22-23
Cox's 1st Add & 7th St. Fan 1
Scale 1" = 50'
S. 14 - 32

E. C. Swenson
Reg. Surveyor

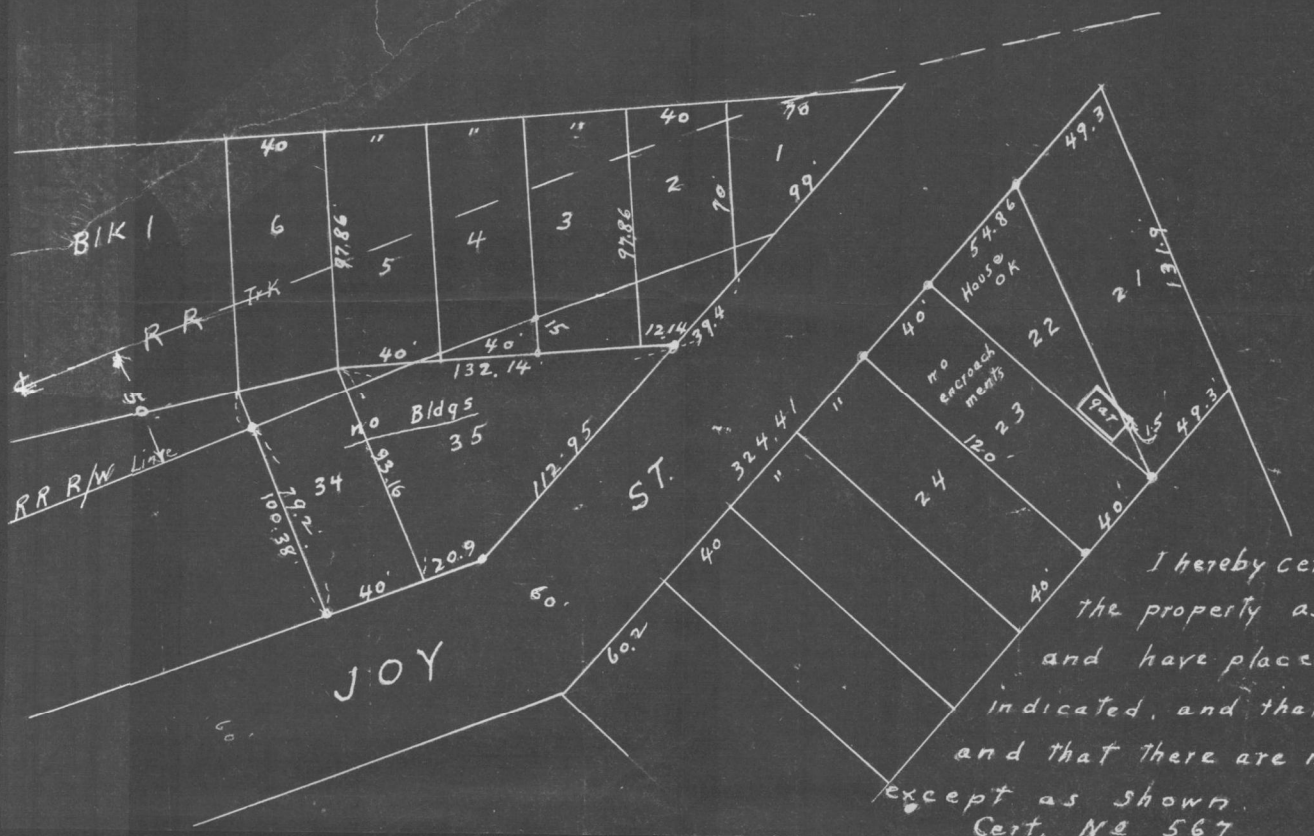

I hereby certify To having surveyed the property as shown on this plat and have placed iron stakes as indicated, and that the same is correct and that there are no encroachments except as shown.
Cert. No 567

Edgar C. Swenson
Reg. Surveyor

7615