


N

E. SEVENTH ST.


ST.

WACOUTA

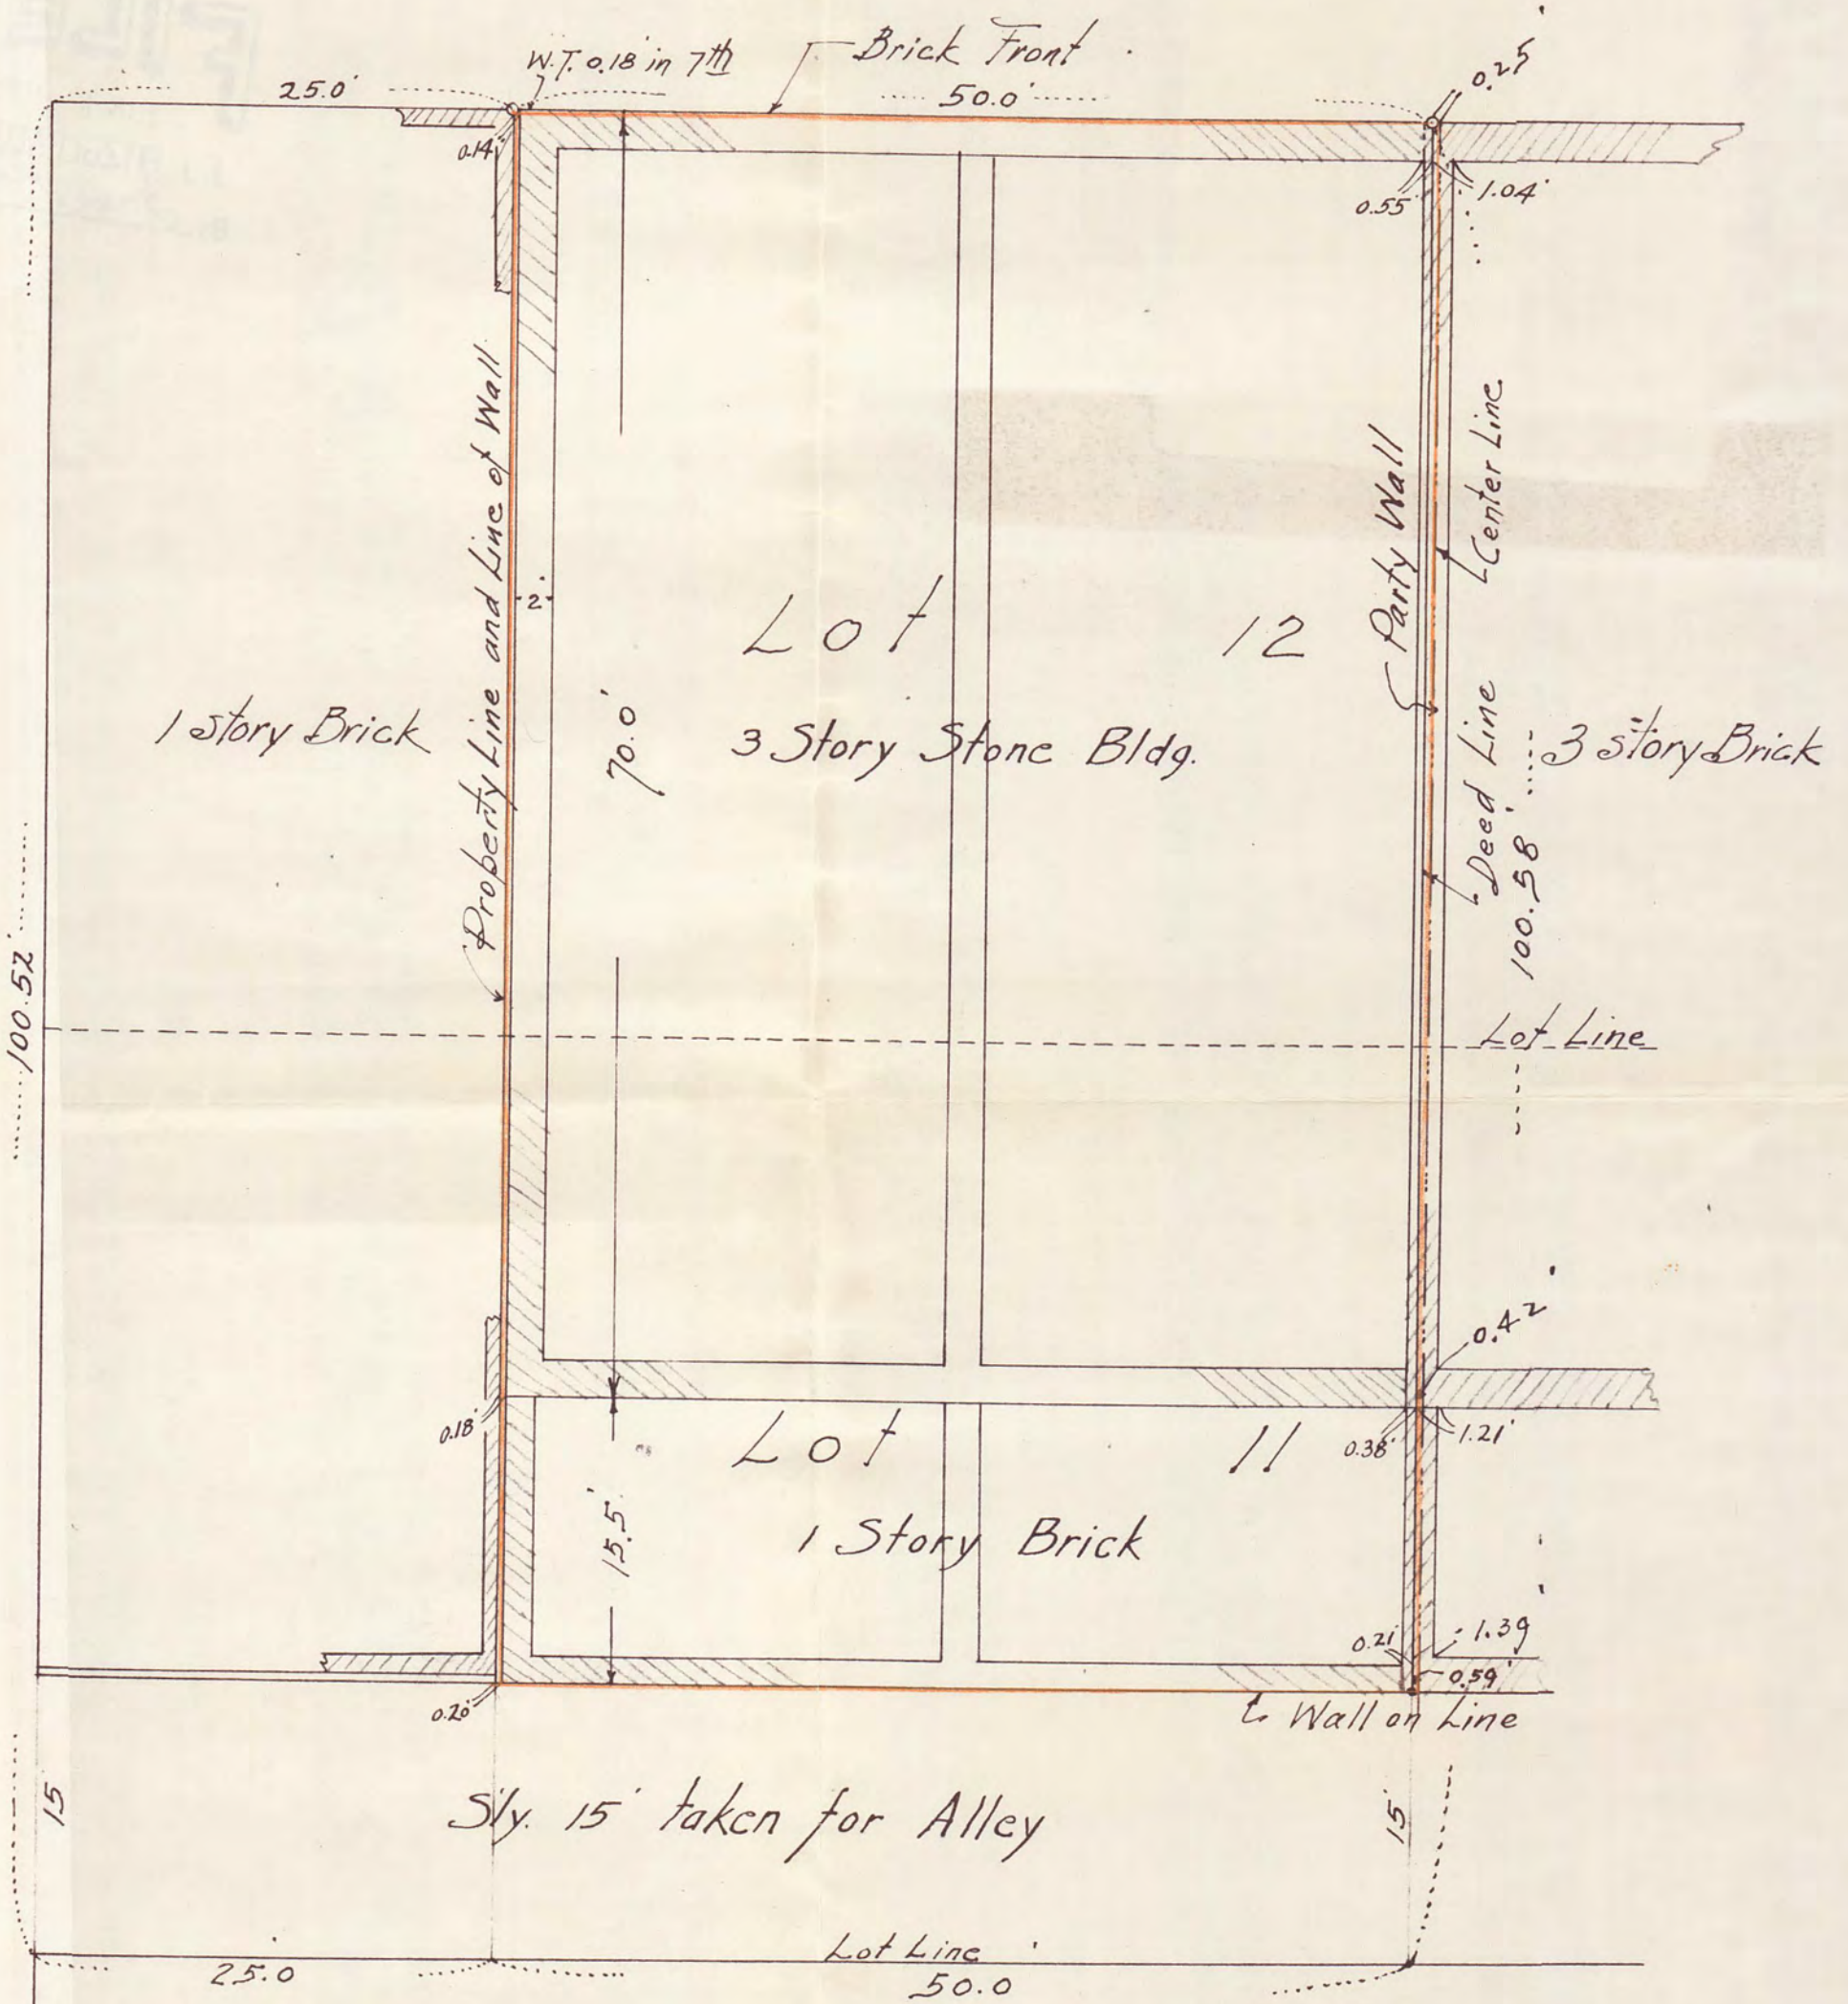

I hereby certify that this map correctly represents the following described property to wit: The Easterly 50 feet of the westerly 75 feet of Lots 11 & 12 in Block 6 Whitney and Smith's Addition to Saint Paul, except the southeasterly 15 feet thereof, as surveyed by me in April 1953, and there are no encroachments except as indicated.

Dated this 11th day of May 1953
 J. Brunsberg Civil Engr
 Scale 10 feet per inch

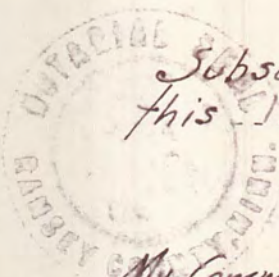

Subscribed and sworn to before me
 this 11th day of May 1953

Helen O. Anderson
 Notary Public Ramsey County, Minn

My Commission Expires - HELEN O. ANDERSON
 Notary Public, Ramsey County, Minn.
 My Commission expires Sept. 20, 1953

7700