

*part by Miller & Holmes registration
file - Auditor # 36*

SCALE: 1 INCH 30 FEET

THE E. B. McDONOUGH CO.
1953 UNIVERSITY AVE., SAINT PAUL 4
400 NATIONAL BUILDING, MINNEAPOLIS 2


TELEPHONES NE 6858
GE 3441
EM 5072

PLAT OF SURVEY

7706

OF PROPERTY OF Miller & Holmes, South Wabasha St. & Delos St., St. Paul, Minn.

DESCRIBED AS FOLLOWS (See attached for complete legal description)

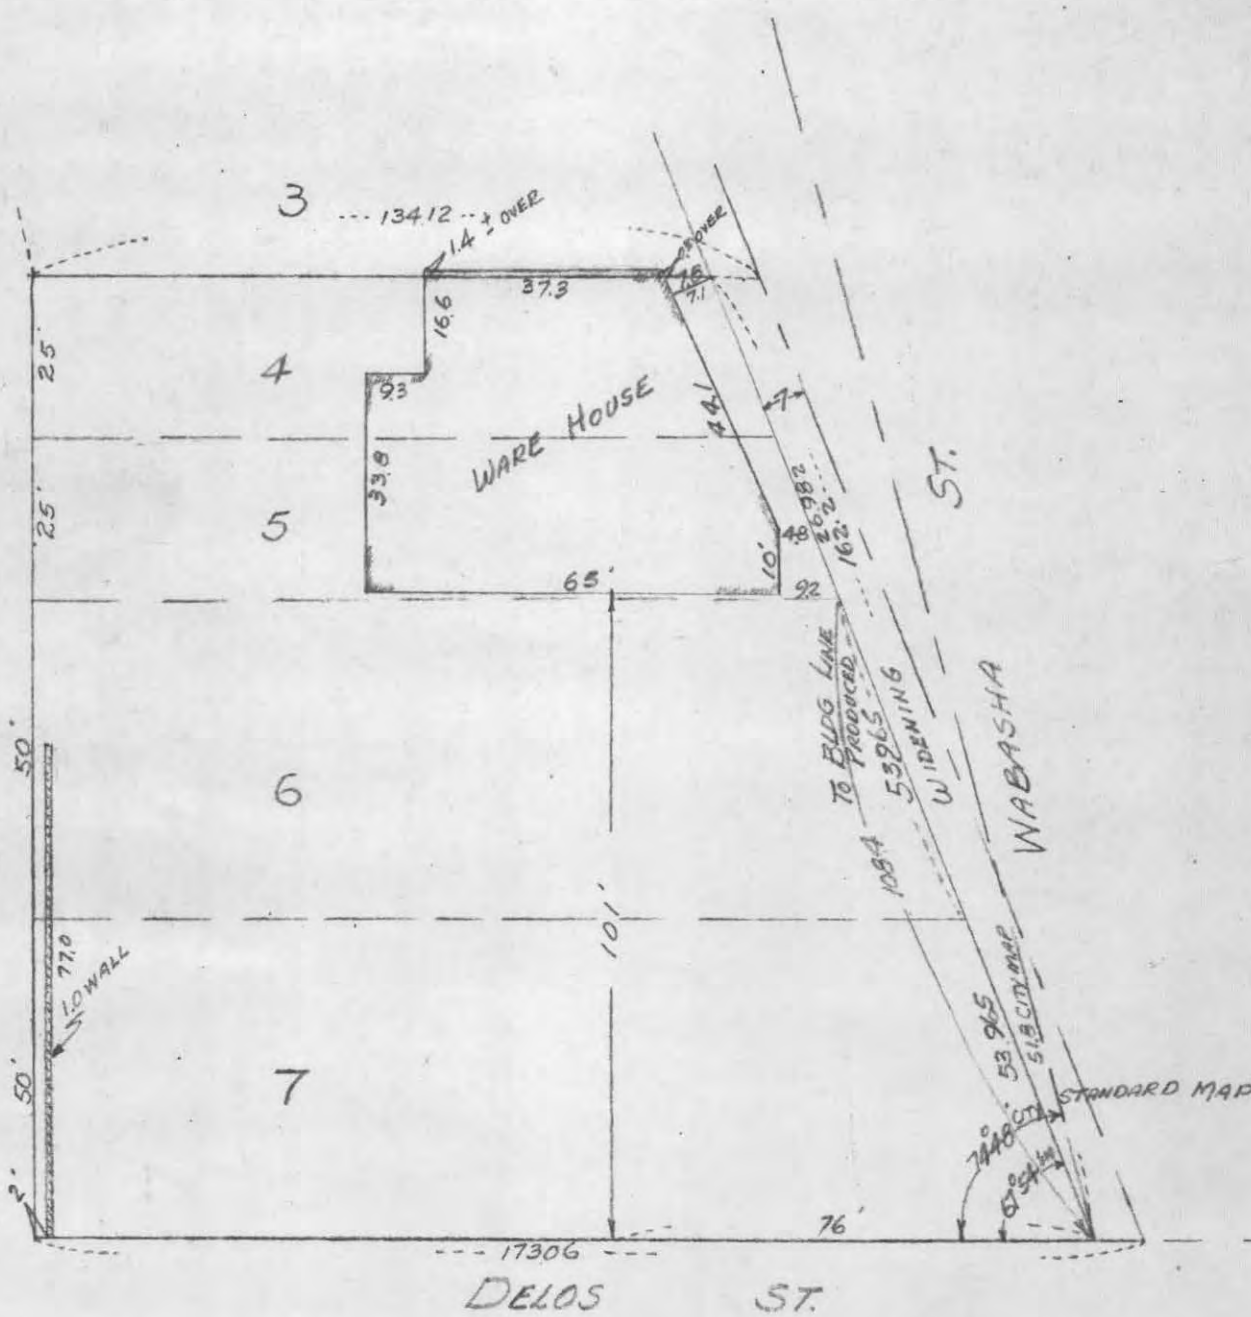

CERTIFICATE OF LOCATION OF BUILDING

I hereby certify that on 12-29 1954
I made a survey of the location of the building(s) on the
above described property and that the location of said
building(s) is correctly shown on the above plat.

E. B. McDonough

- E. B. McDONOUGH, REGISTERED SURVEYOR, No. 1990
- DONALD O. WEBER, " " No. 665
- PAUL J. CRANE, " " No. 4449
- JOHN J. RYAN, " " No. 4489

CERTIFICATE OF SURVEY

I hereby certify that on 12-29 1954
I surveyed the property described above and that the above
plat is a correct representation of said survey.

E. B. McDonough

7706