


CERTIFICATE of SURVEY

F. J. ARMSTRONG
Civil Engineer and Surveyor
ST. PAUL, MINN.

applied Sub. D

N
~~8045~~
8047

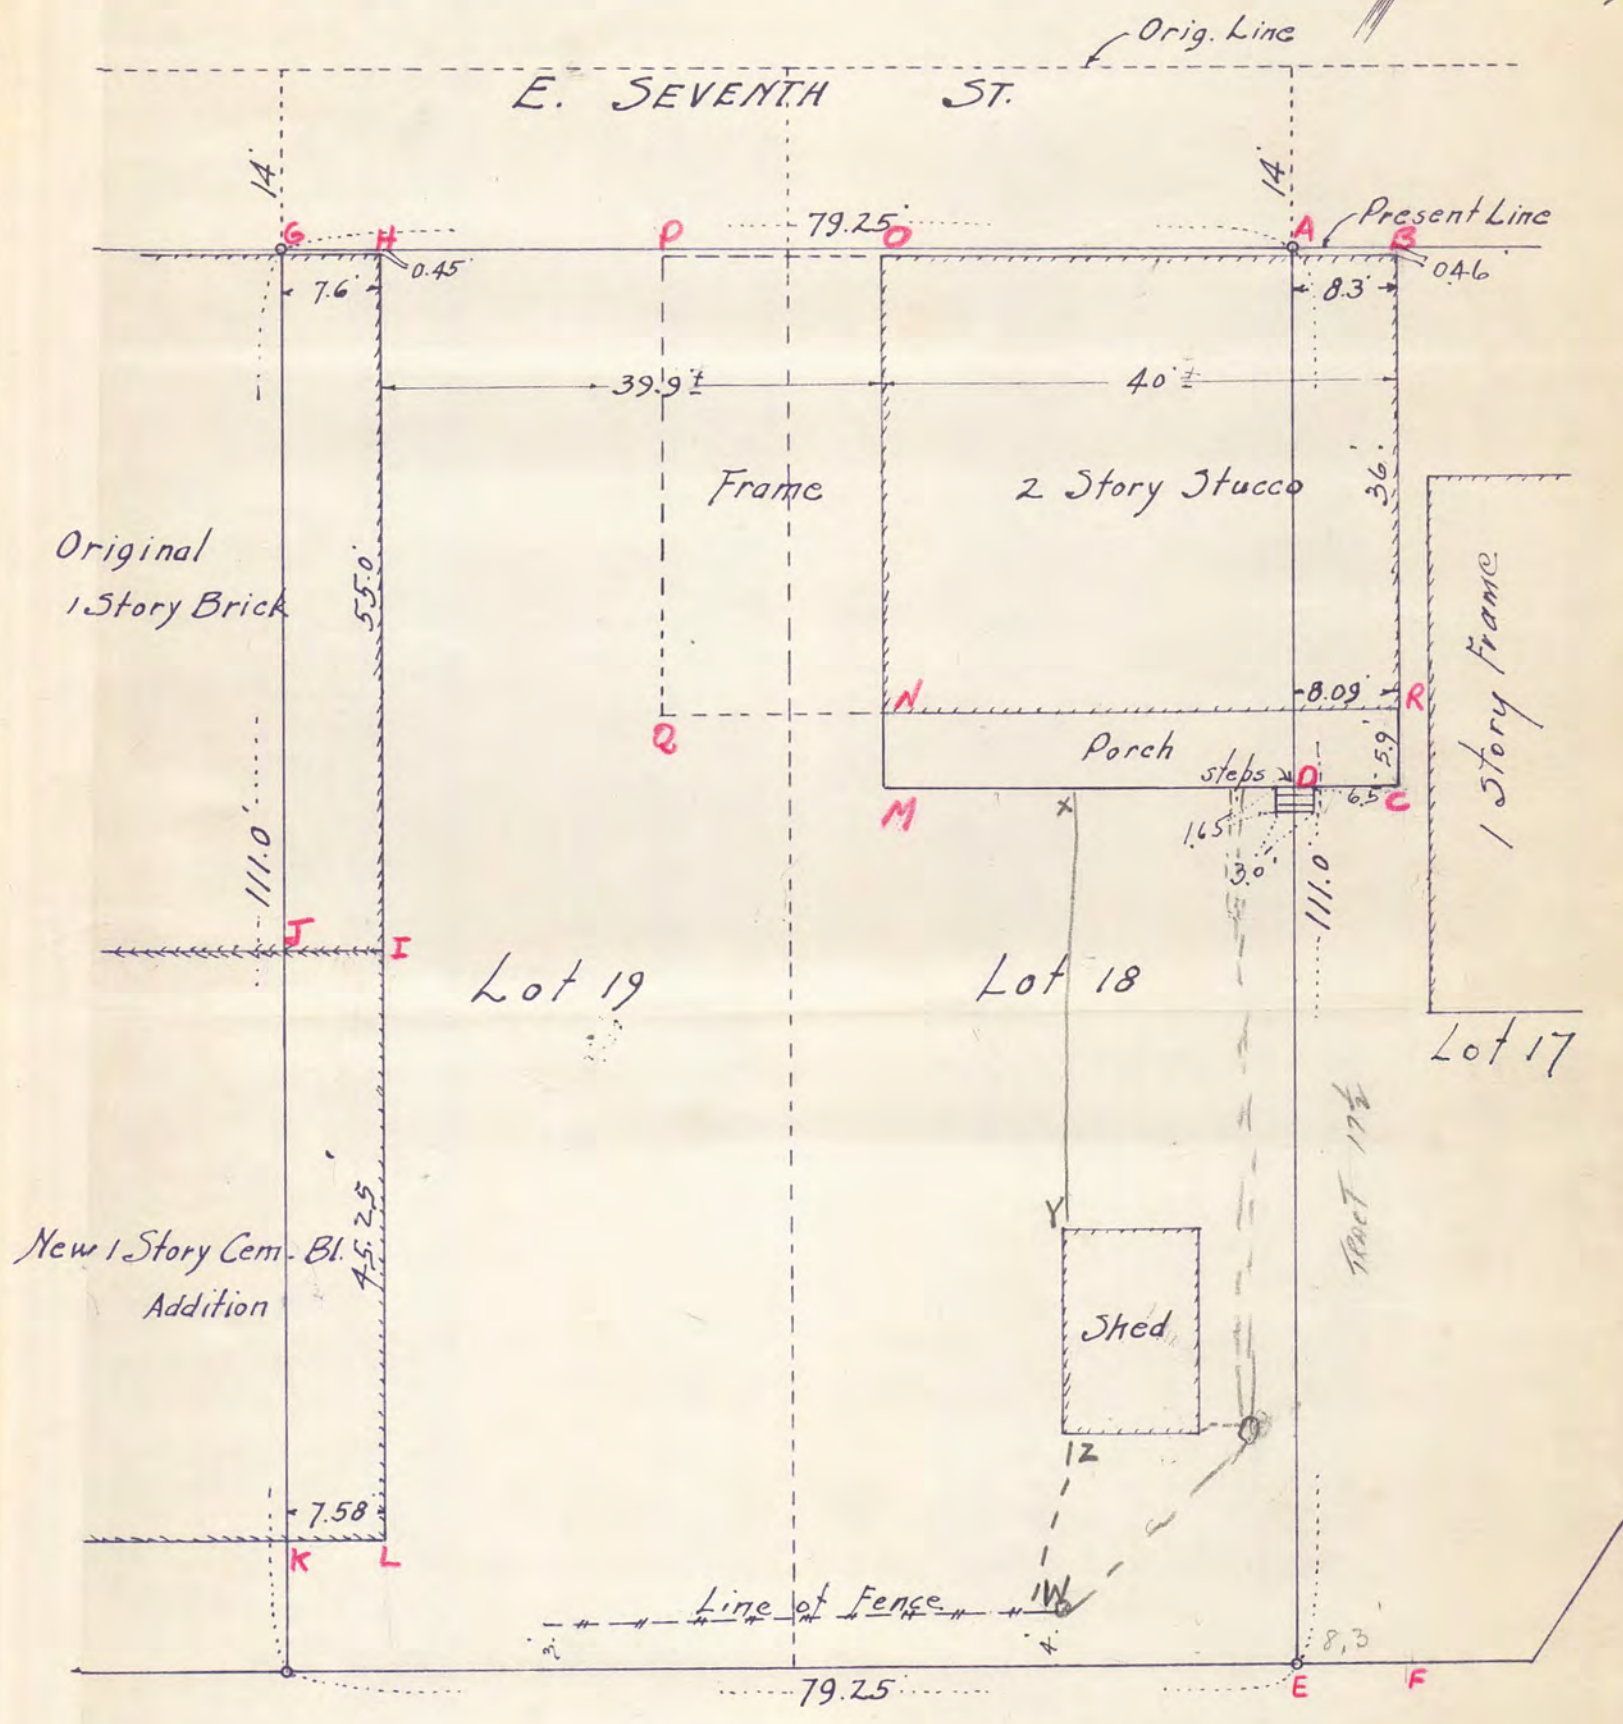

20 FT. ALLEY

Scale: 15 ft. per inch

I HEREBY CERTIFY that on the 26th day of May, A. D. 1953
 I made a survey of the following described property, to-wit: Lots 18 and 19
Johnstone's Subin. of Block 112 Lyman Dayton's Add.
St. Paul Minnesota
 and the above map is a true and correct map of said survey and the improvements shown thereon are correctly indicated

F. J. Armstrong Civil Engineer

Subscribed and sworn to before me this _____ day of _____, 19____

 Notary Public.
 My Commission Expires _____

8047