

805

DUNWELL AND SPENCER'S ADD TO BROOKLYN.

SURVEY OF

ALL THAT PART OF LOTS 5 & 6 BL 21
DUNWELL AND SPENCER'S ADD TO BROOKLYN DESCRIBED
AS FOLLOWS TO WIT. COMMENCING AT THE N.WLY COR LOT 6
THENCE SLY ALONG THE WLY LINE LOTS 5 AND 6 TO THE S.WLY
CORNER OF LOT 5 THENCE ELY ALONG THE SLY LINE OF LOT 5 36 FT
THENCE NLY PARALLEL TO THE WLY LINE TO THE NLY LINE OF
LOT 6 THENCE WLY ALONG THE NLY LINE LOT 6 36 FT TO PLACE
OF BEGINING

ST PAUL FEB 3-1909.


I HEREBY CERTIFY TO HAVING
SURVEYED THE ABOVE DESCRIBED PROPERTY
AND HAVE PLACED THE POINTS AS INDICATED
ON THIS MAP. AND DISTANCES AND LOCATIONS
AS HEREON SHOWN ARE CORRECT
SCALE 20' = 1"

FEB 3-1909

TEXAS

ST. Jens Pedersen
SURV.

60

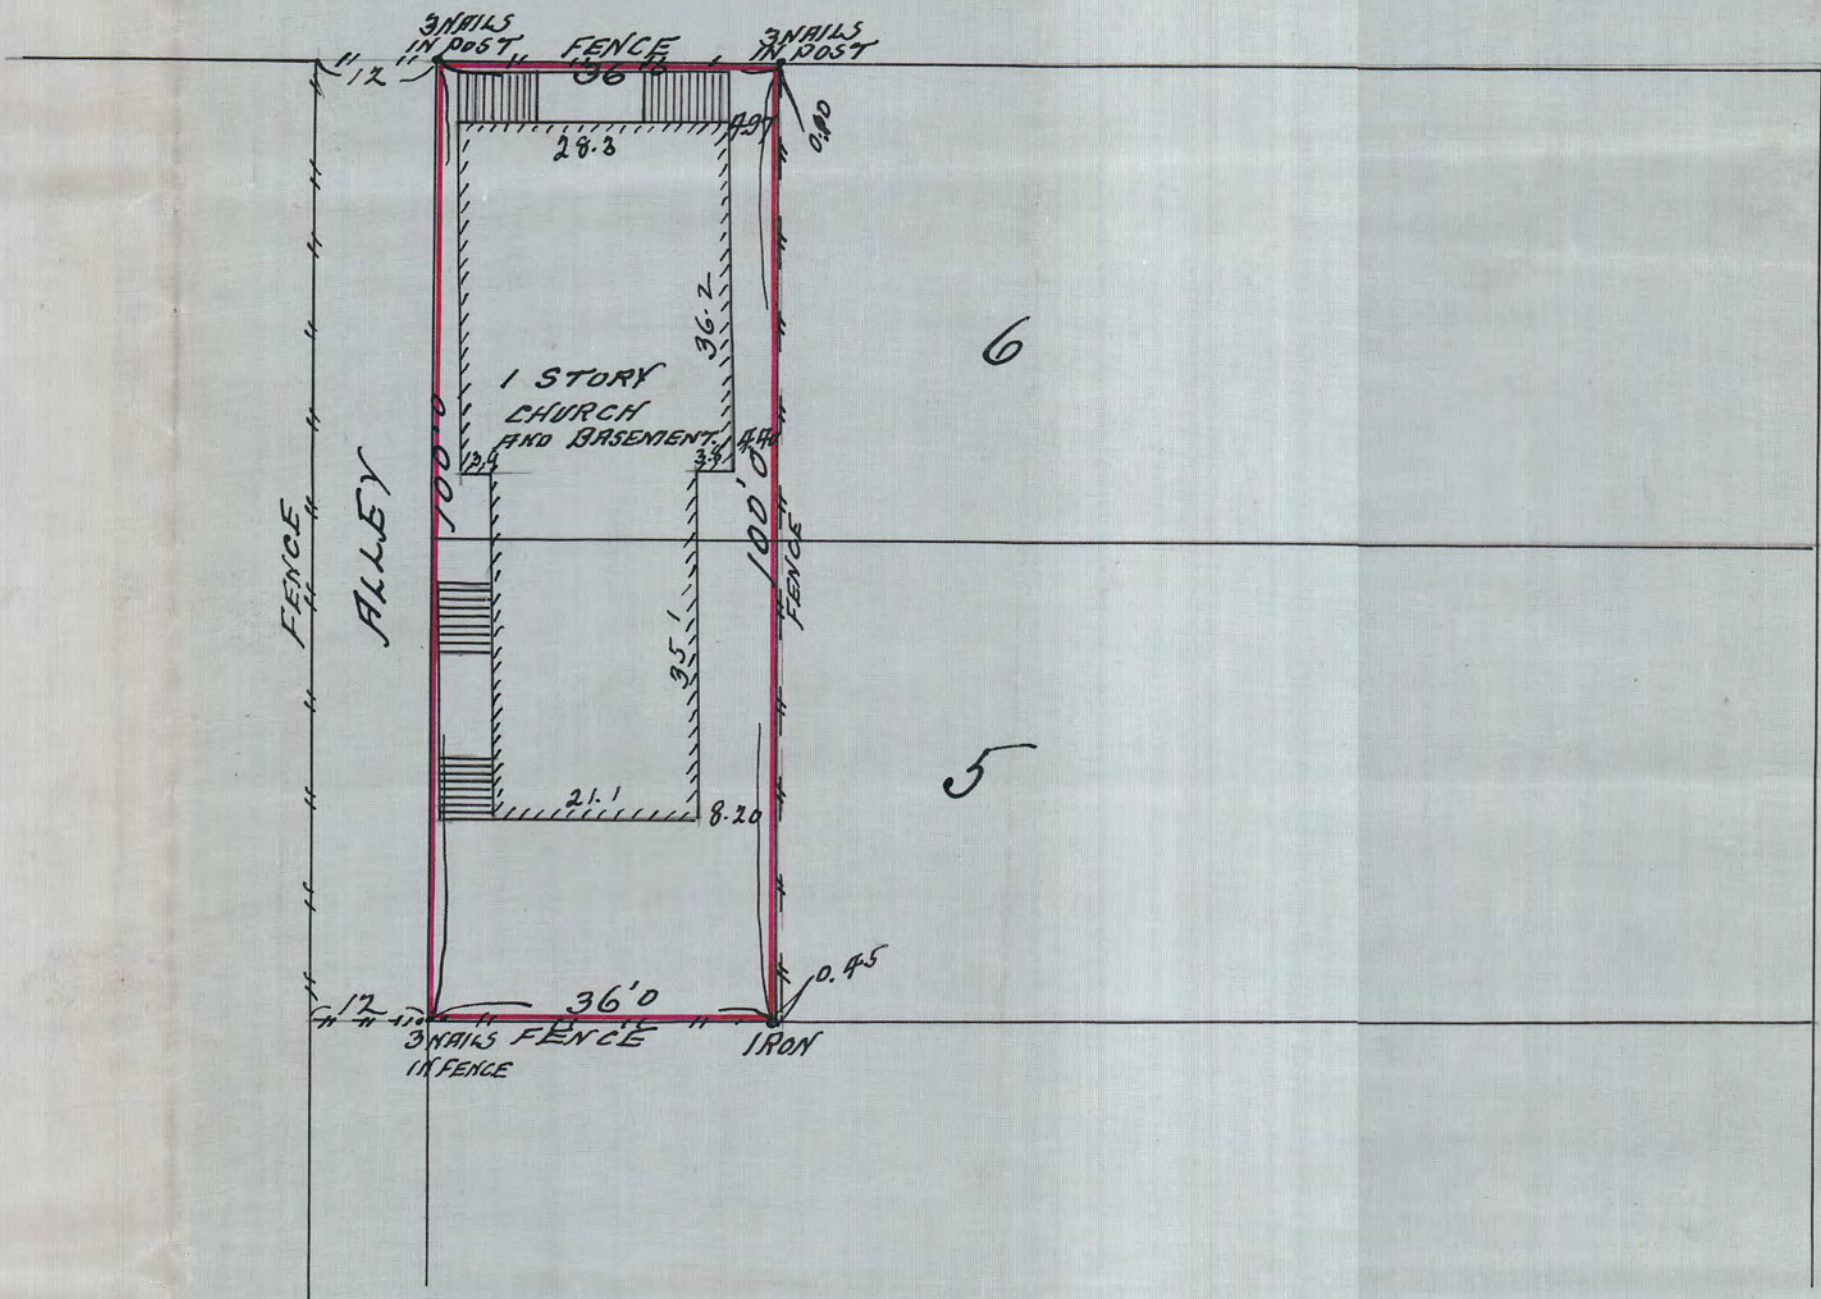

60
ST. 60
FENTON
60


805