

CERTIFICATE OF SURVEY

MILNER W. CARLEY
CIVIL ENGINEER & SURVEYOR

500 W. Hwy. 96

IV. 4-1266


I hereby certify that this survey, plan, or report was prepared by me or under my direct supervision and that I am a duly Registered Land Surveyor under the laws of the State of Minnesota.

Ronald O. Carley

Date Jan. 1965

Scale 1" = 200'

Date Jan. 12, 1955 Reg. No. 3527

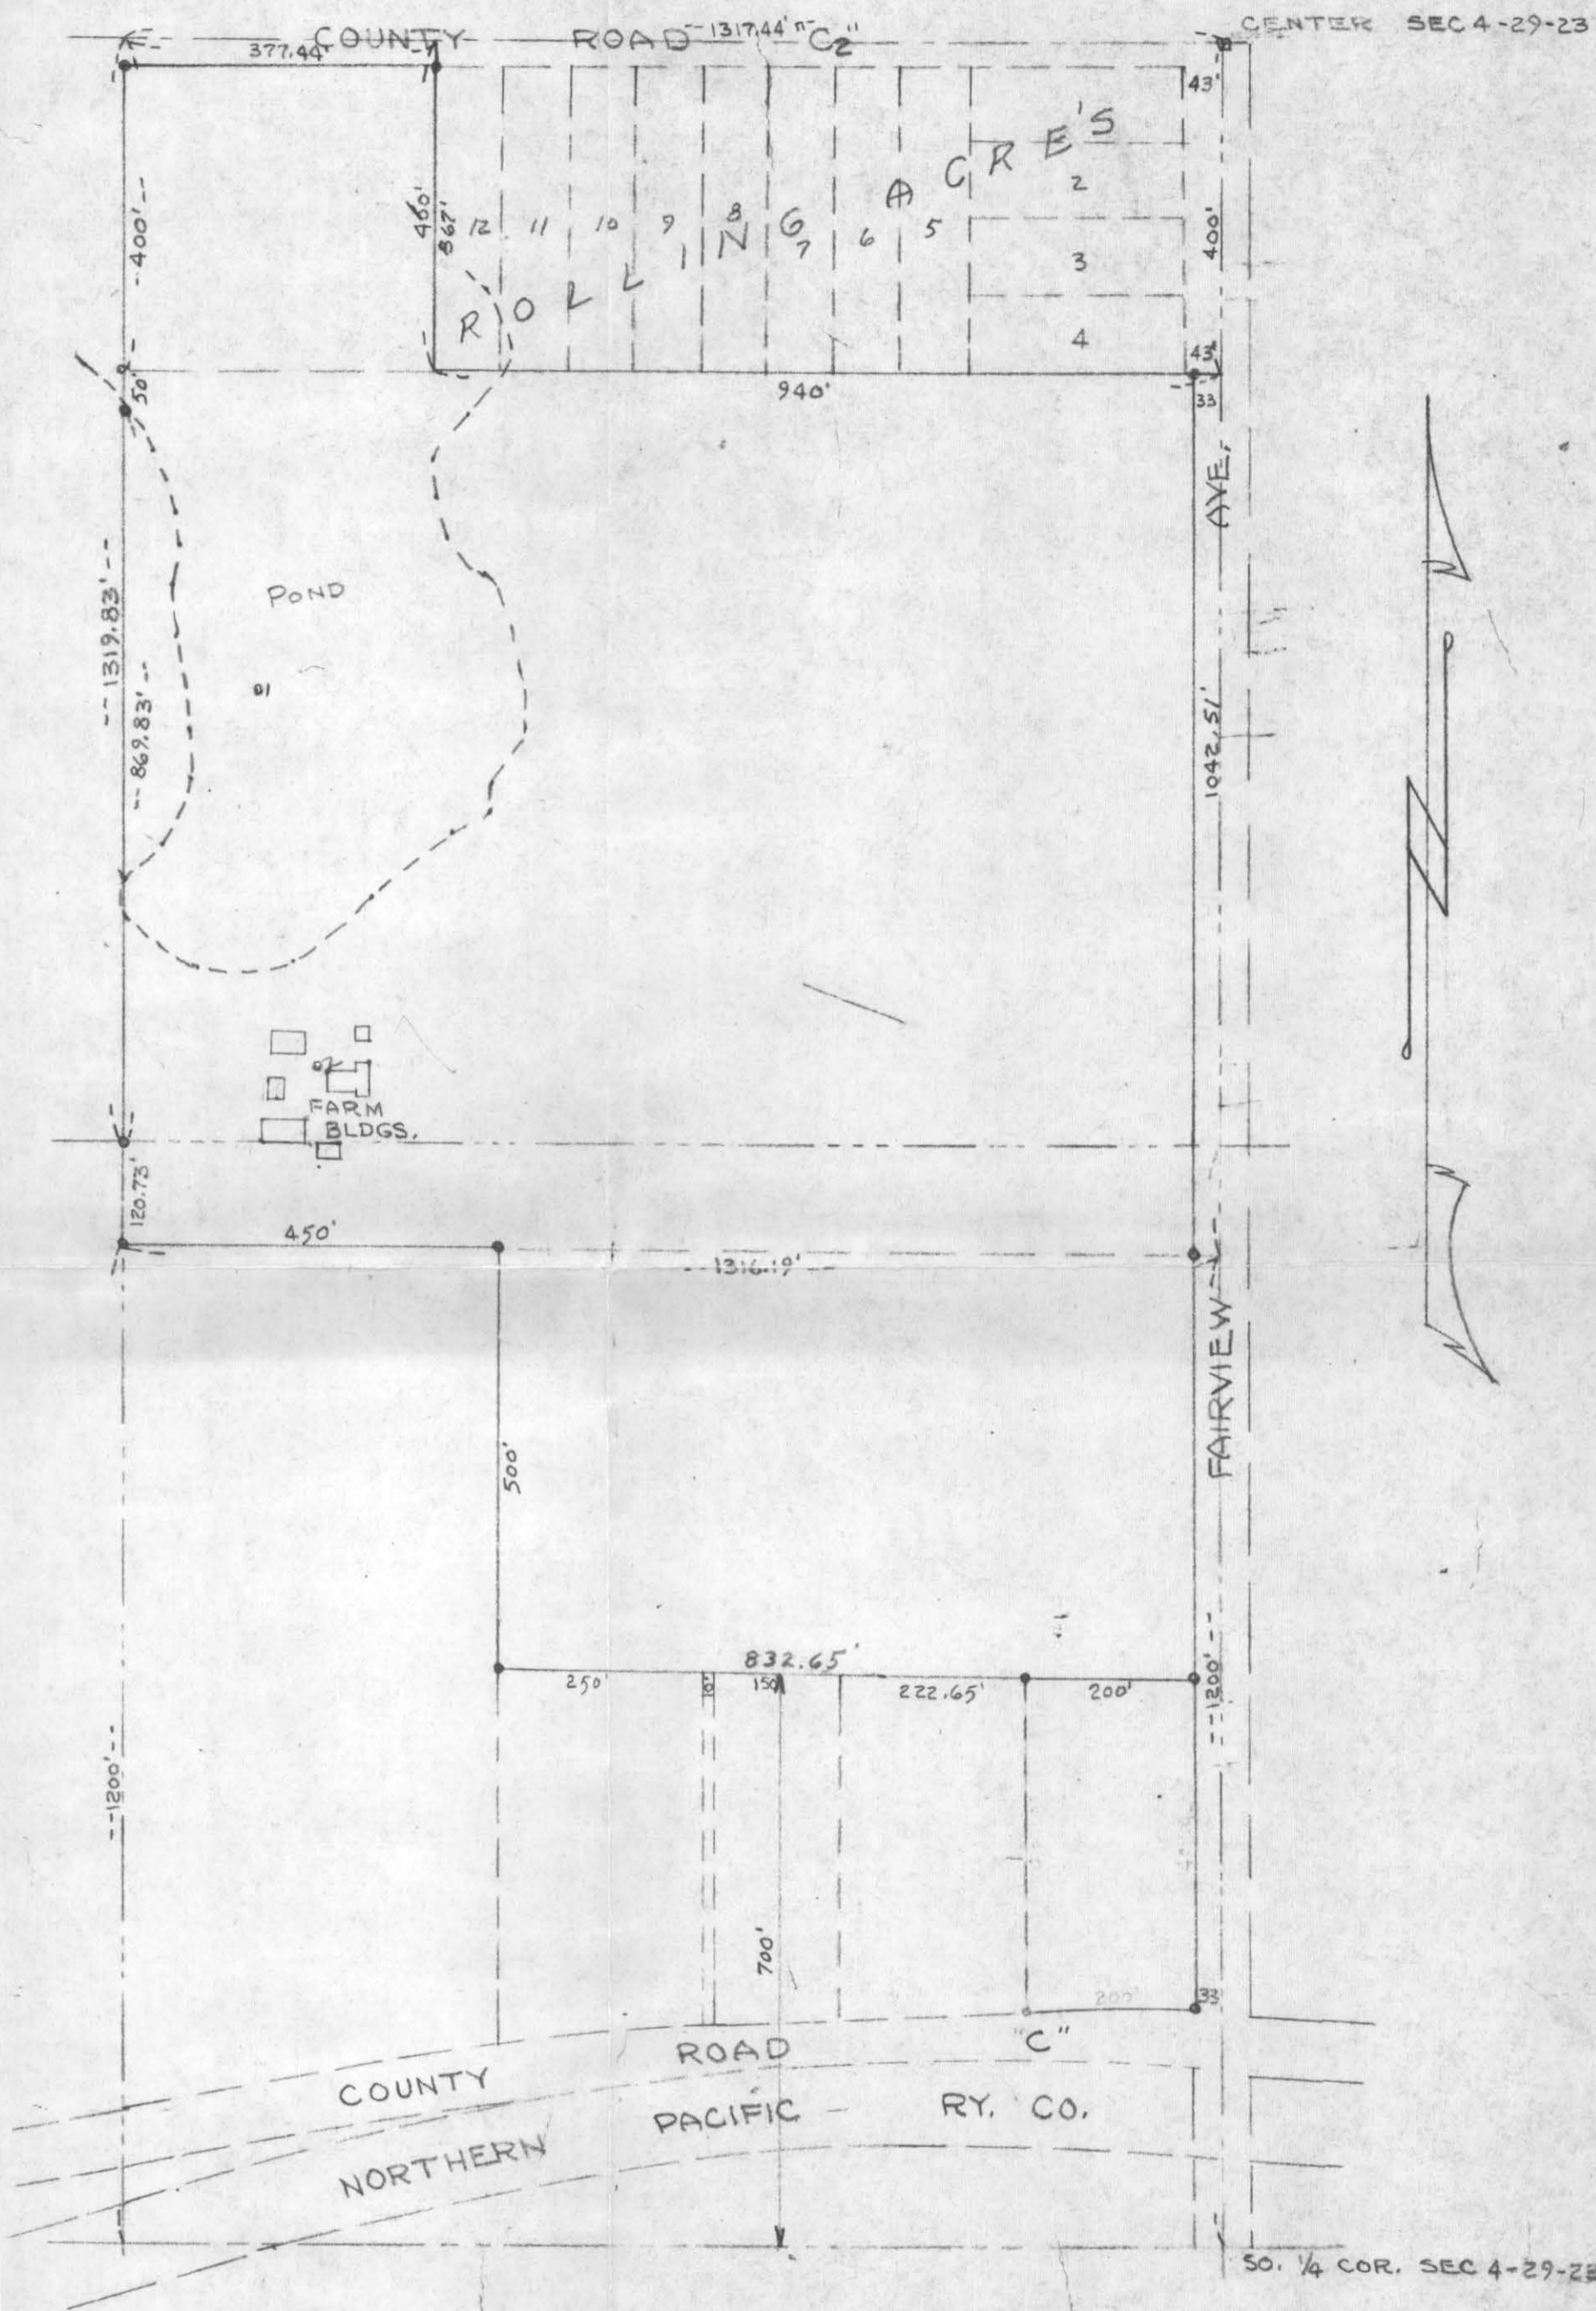

8262

Except the South 700.0 feet and except the North 500.0 feet of the South 1200.0 feet of the West 450.0 feet and except Rolling Acres, the East 1/2 of the Southwest 1/4 of Section 4, Town 29 North, Range 23 West, subject to Fairview Avenue and County Road "C2".
I hereby certify to having surveyed the property described on this map and have placed iron monuments at the corners as shown. There are no buildings or encroachments thereon except as shown.

Ronald O. Carley
Registered Surveyor, Minnesota Certificate 3527

#8262