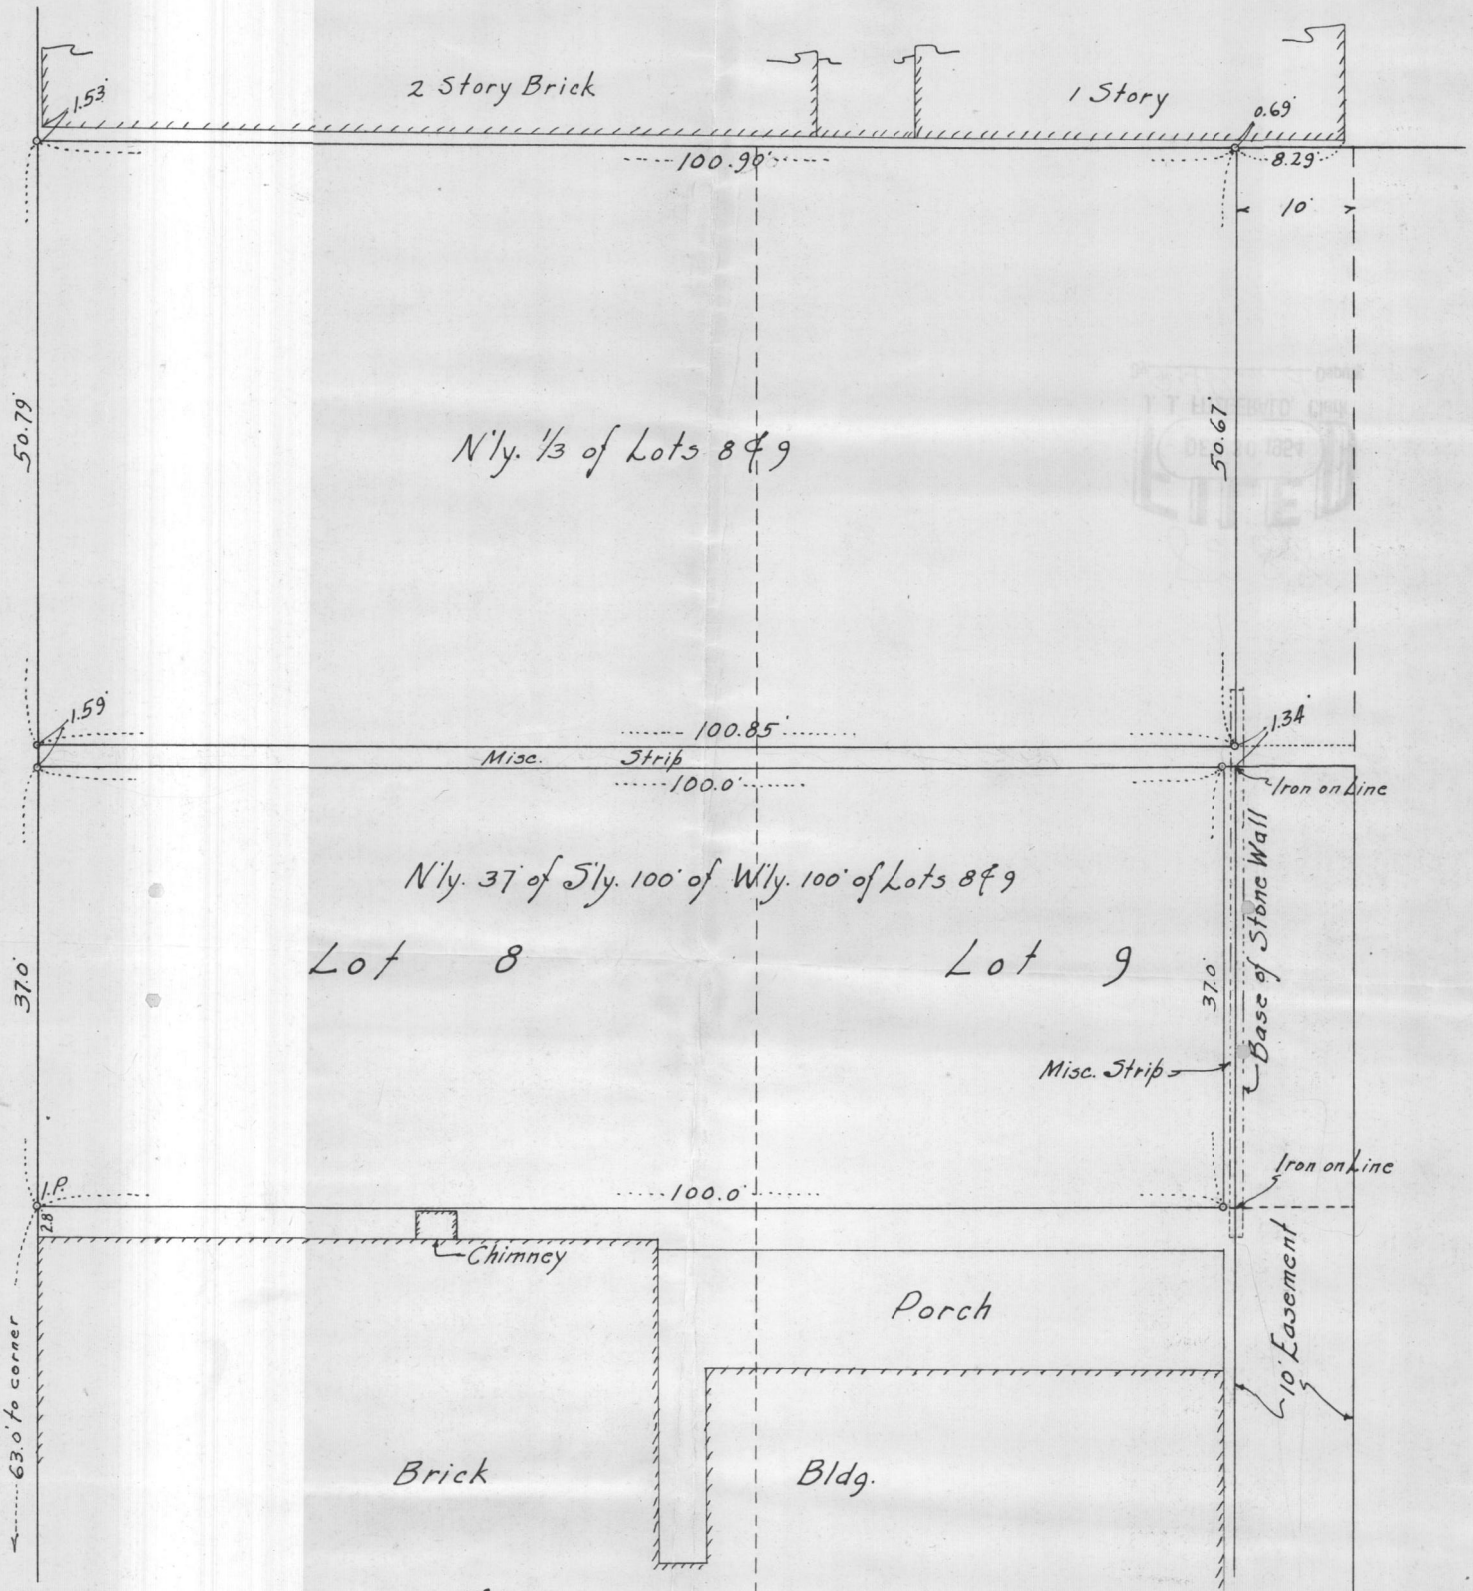

s is to certify that Franklyn J. Armstrong- Civil Eng.
urveyor - for many years in St. Paul that the above plat
rectly represents the description of all of lots 8 & 9
ept the Easterly 10 feet thereof and except the Southerly
' thereof in Block 2, Roberts and Randalls Addition to St.
l Minnesota

Franklyn J. Armstrong

PLAT OF SURVEY OF THE N'LY. 1/3 OF LOTS 8 AND 9
EXCEPT THE E'LY. 10 FT. THEREOF, AND THE N'LY.
37 FT. OF THE S'LY. 100 FT. OF THE W'LY. 100 FT. OF
LOTS 8 AND 9 ALL IN BLOCK 2 ROBERTS AND
RANDALLS ADDITION TO ST. PAUL, MINNESOTA
Scale: 10 ft. per inch
Sept. 14-1954

F. J. Armstrong Civil Engr.

828