

I hereby certify that the within plat of survey is a true and correct plat of survey of:


The Northerly 12.78 feet of Lot 5 and the Southerly 12.22 feet of Lot 4 Block 181 Robertson's Addition to the City of St. Paul.

as made by me on August 4, 1952.

F. J. Armstrong
F. J. Armstrong

Subscribed and sworn to before me this 6 day of December, 1955.

Helen O. Anderson
HELEN O. ANDERSON
Notary Public, Ramsey County, Minn.
My commission expires Sept. 20, 1958
My commission expires:

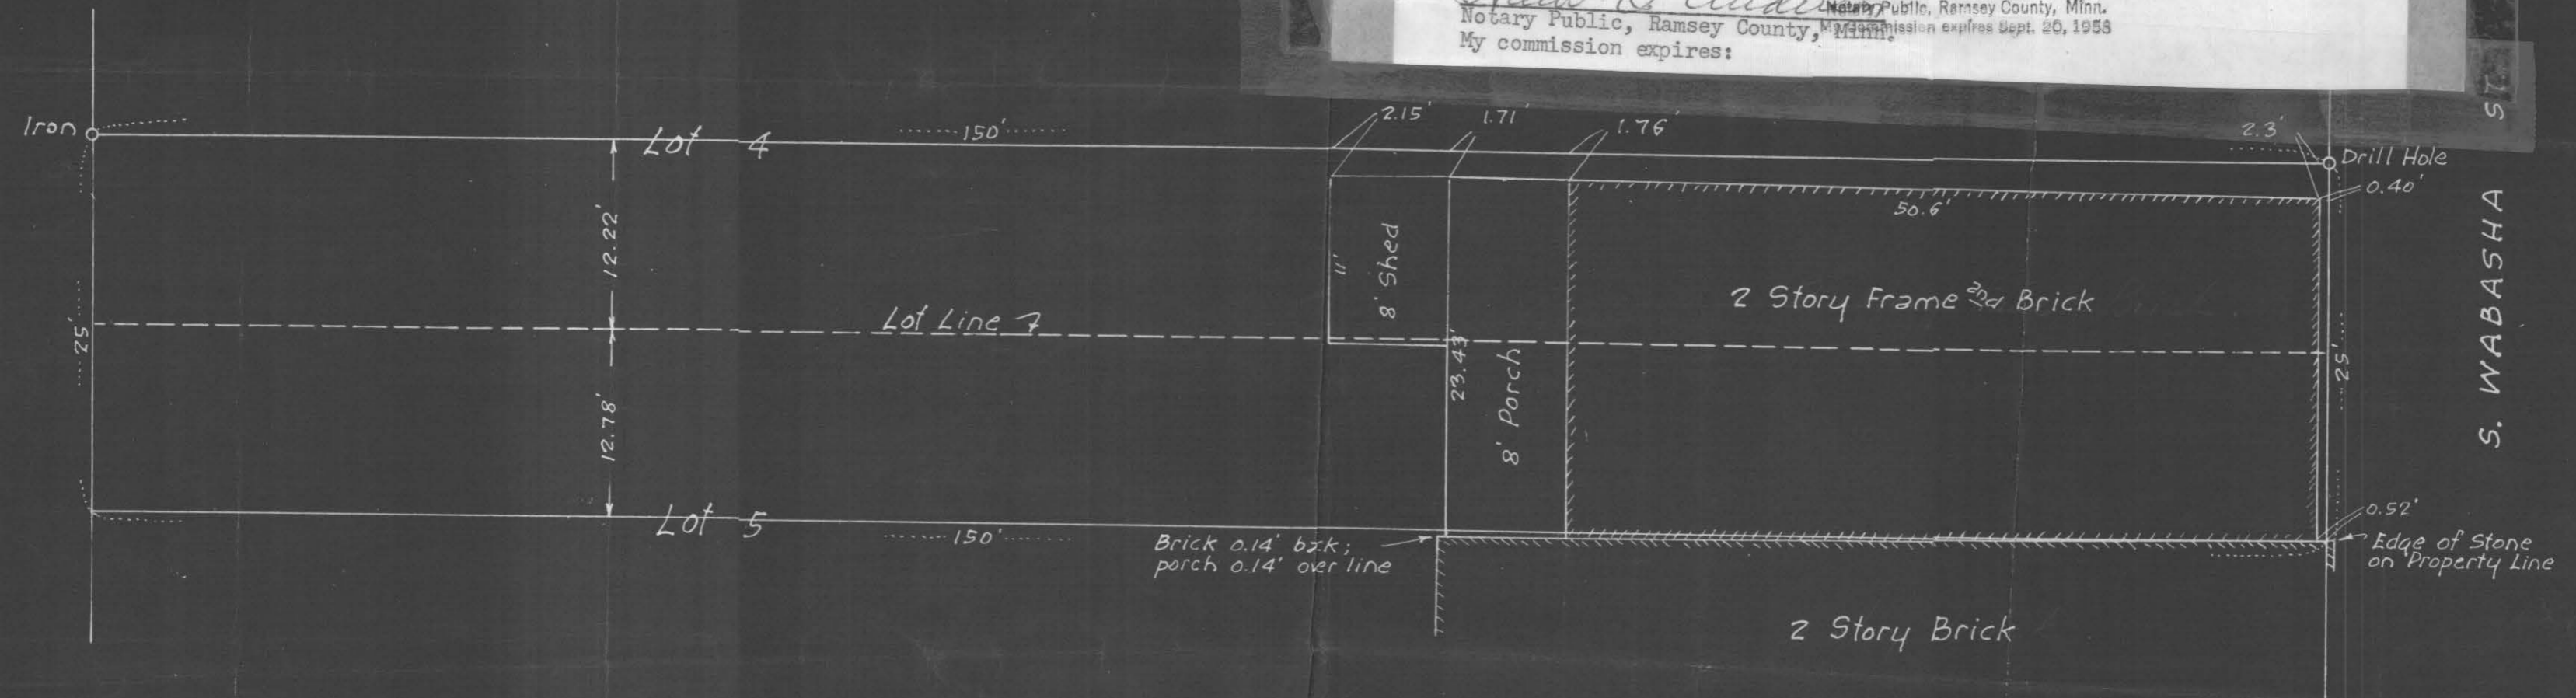

PLAT OF SURVEY OF
The Northerly 12.78 feet of LOT 5 and the
Southerly 12.22 feet of LOT 4 BLOCK 181
ROBERTSON'S ADDITION TO THE CITY OF
ST. PAUL
August 4, 1952

Scale: 1" = 10'

F. J. Armstrong Civil Engr

8605