


PLAT OF SURVEY

E. B. McDONOUGH CO.

Lots 9 to 25, both inclusive, except the Northerly 20 feet of Lot 25; Part of Lot "A" lying West of the East line of Lot 24 extended North to the North line of Lot "A" all in Block 2, J.C. Stout's Addition to Summit Park Ramsey County.

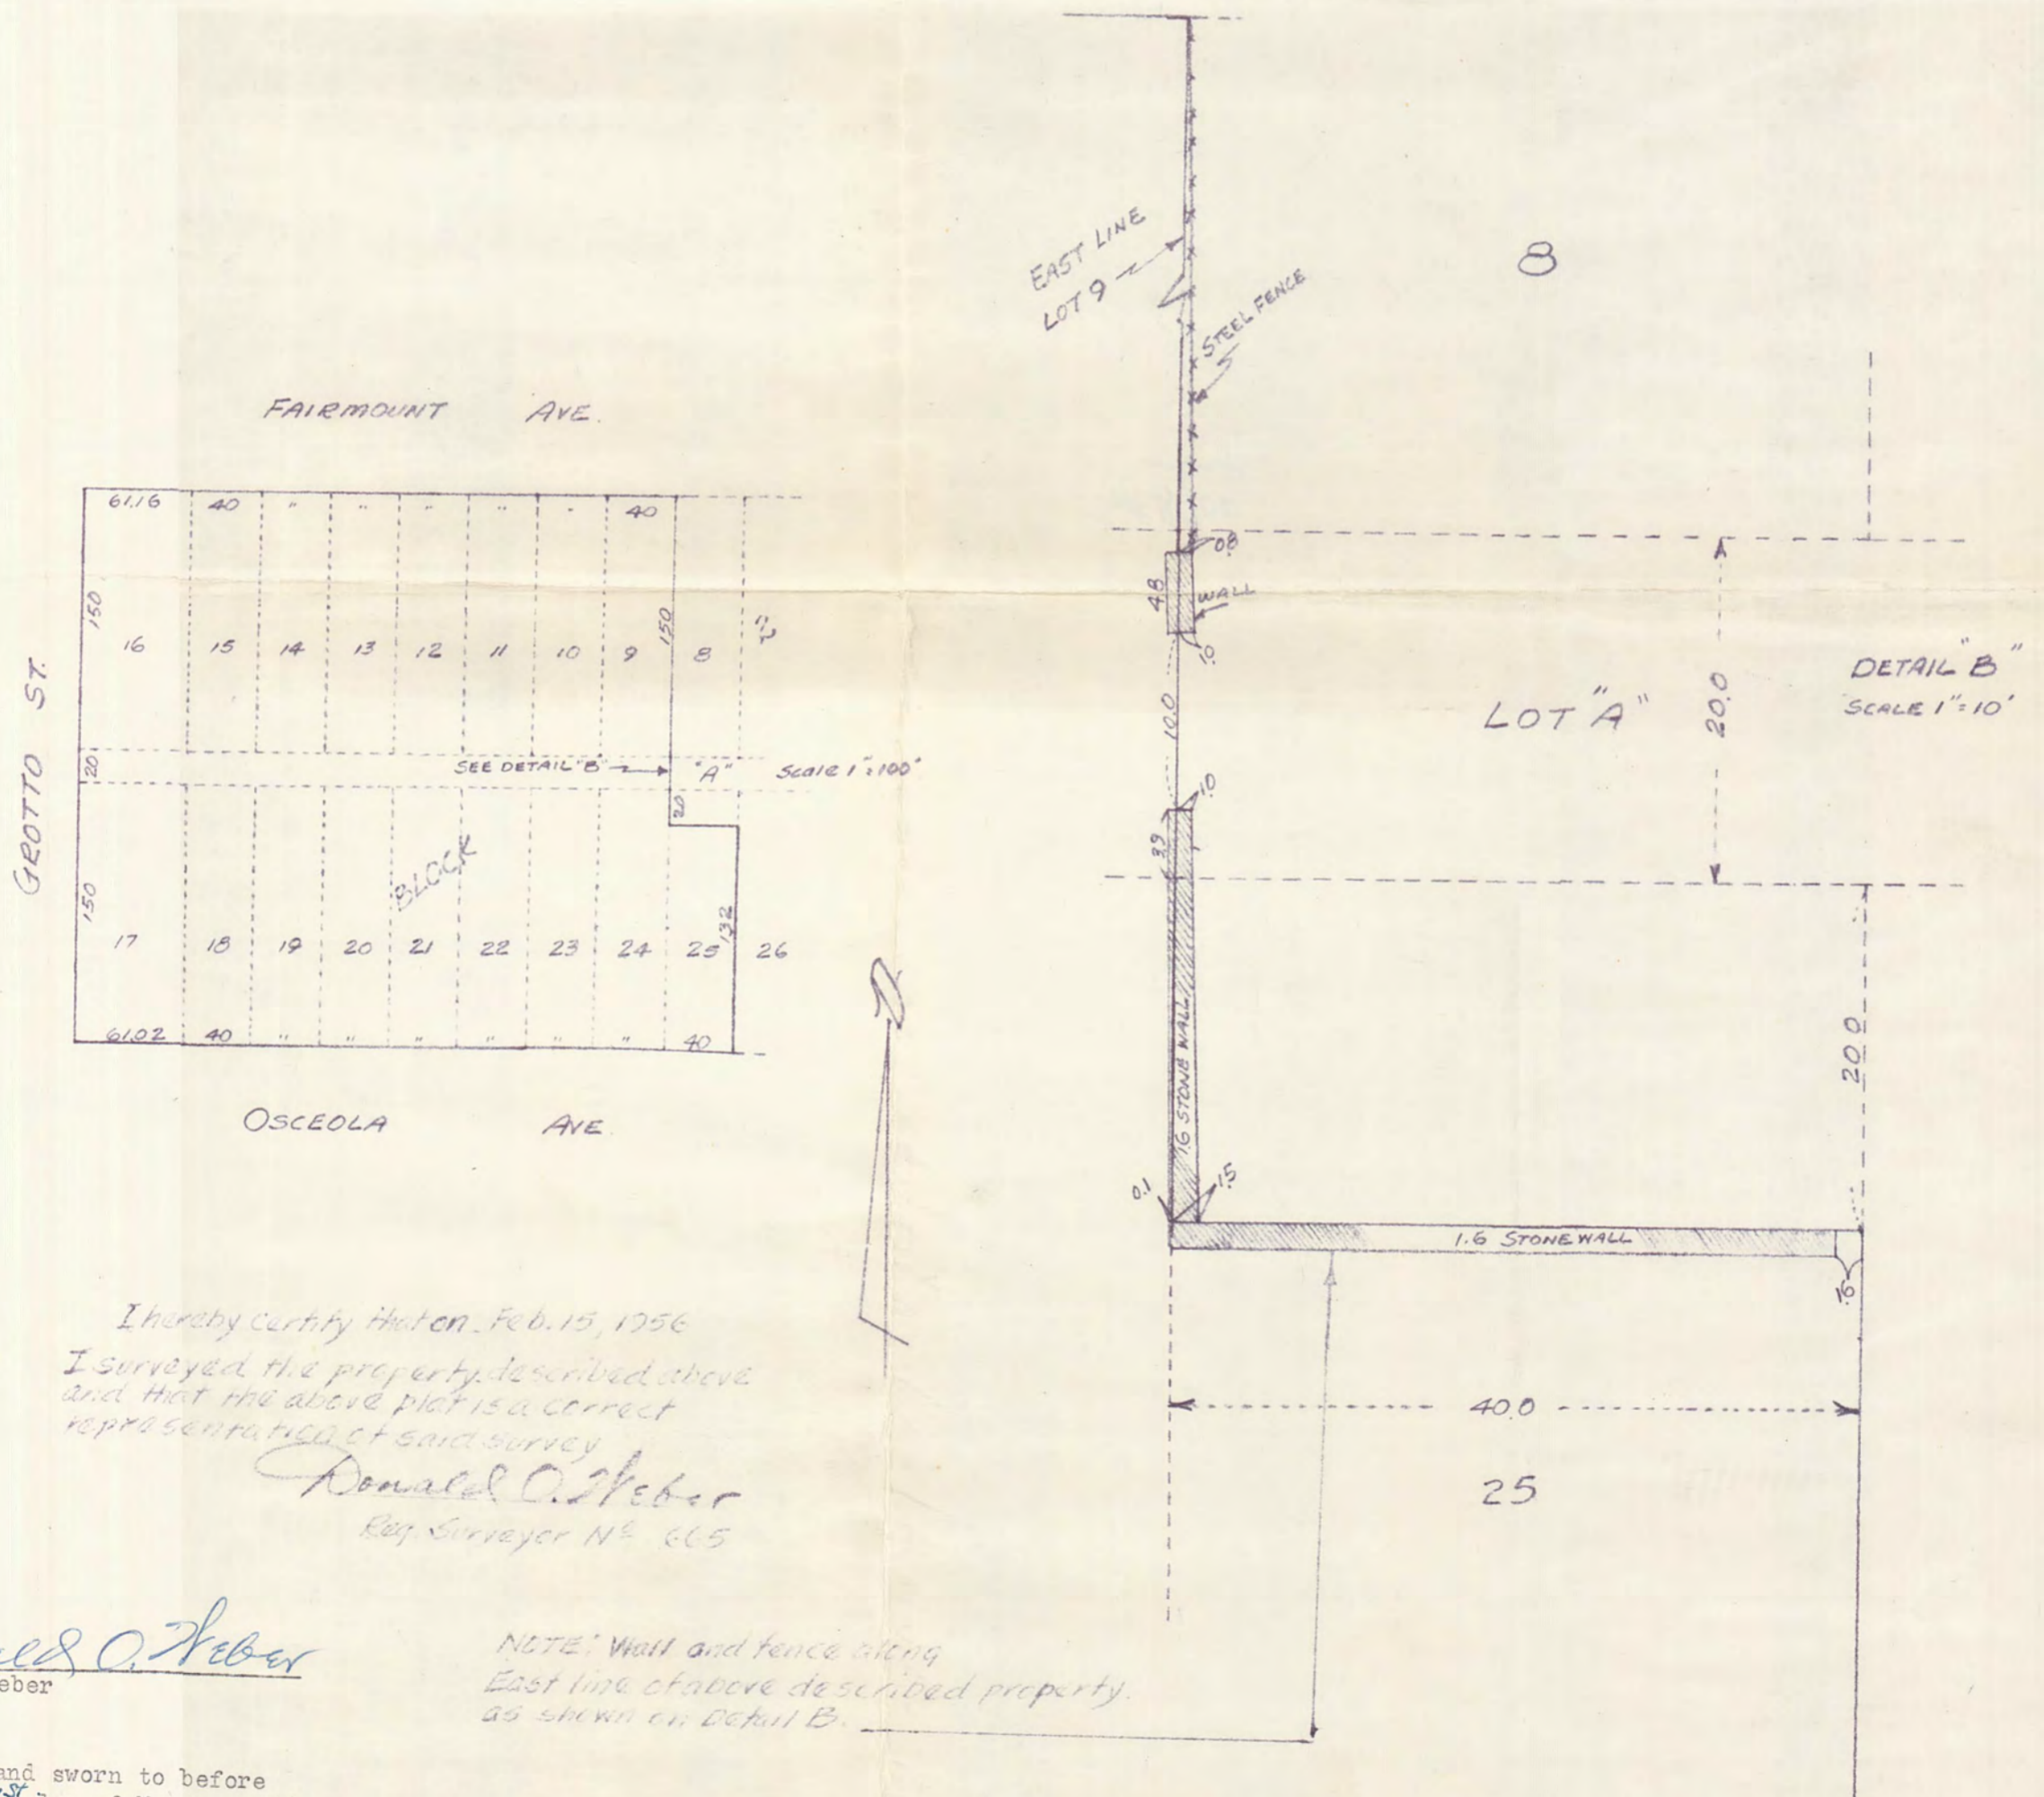

I hereby certify that on Feb. 15, 1956
I surveyed the property described above
and that the above plat is a correct
representation of said survey

Donald O. Weber
Reg. Surveyor No. 665

Donald O. Weber
Donald O. Weber

NOTE: Wall and fence along
East line of above described property
as shown on Detail B.

Subscribed and sworn to before
me this 21st day of March, 1956.

Kate M. Gillis
Notary Public, Ramsey Co. Minn.

My Subscription expires
KATE M. GILLIS,
Notary Public, Ramsey County, Minn.
My Commission Expires Nov. 13, 1960

8700