


871

CHANNEL ST.

ST.

STARKEY

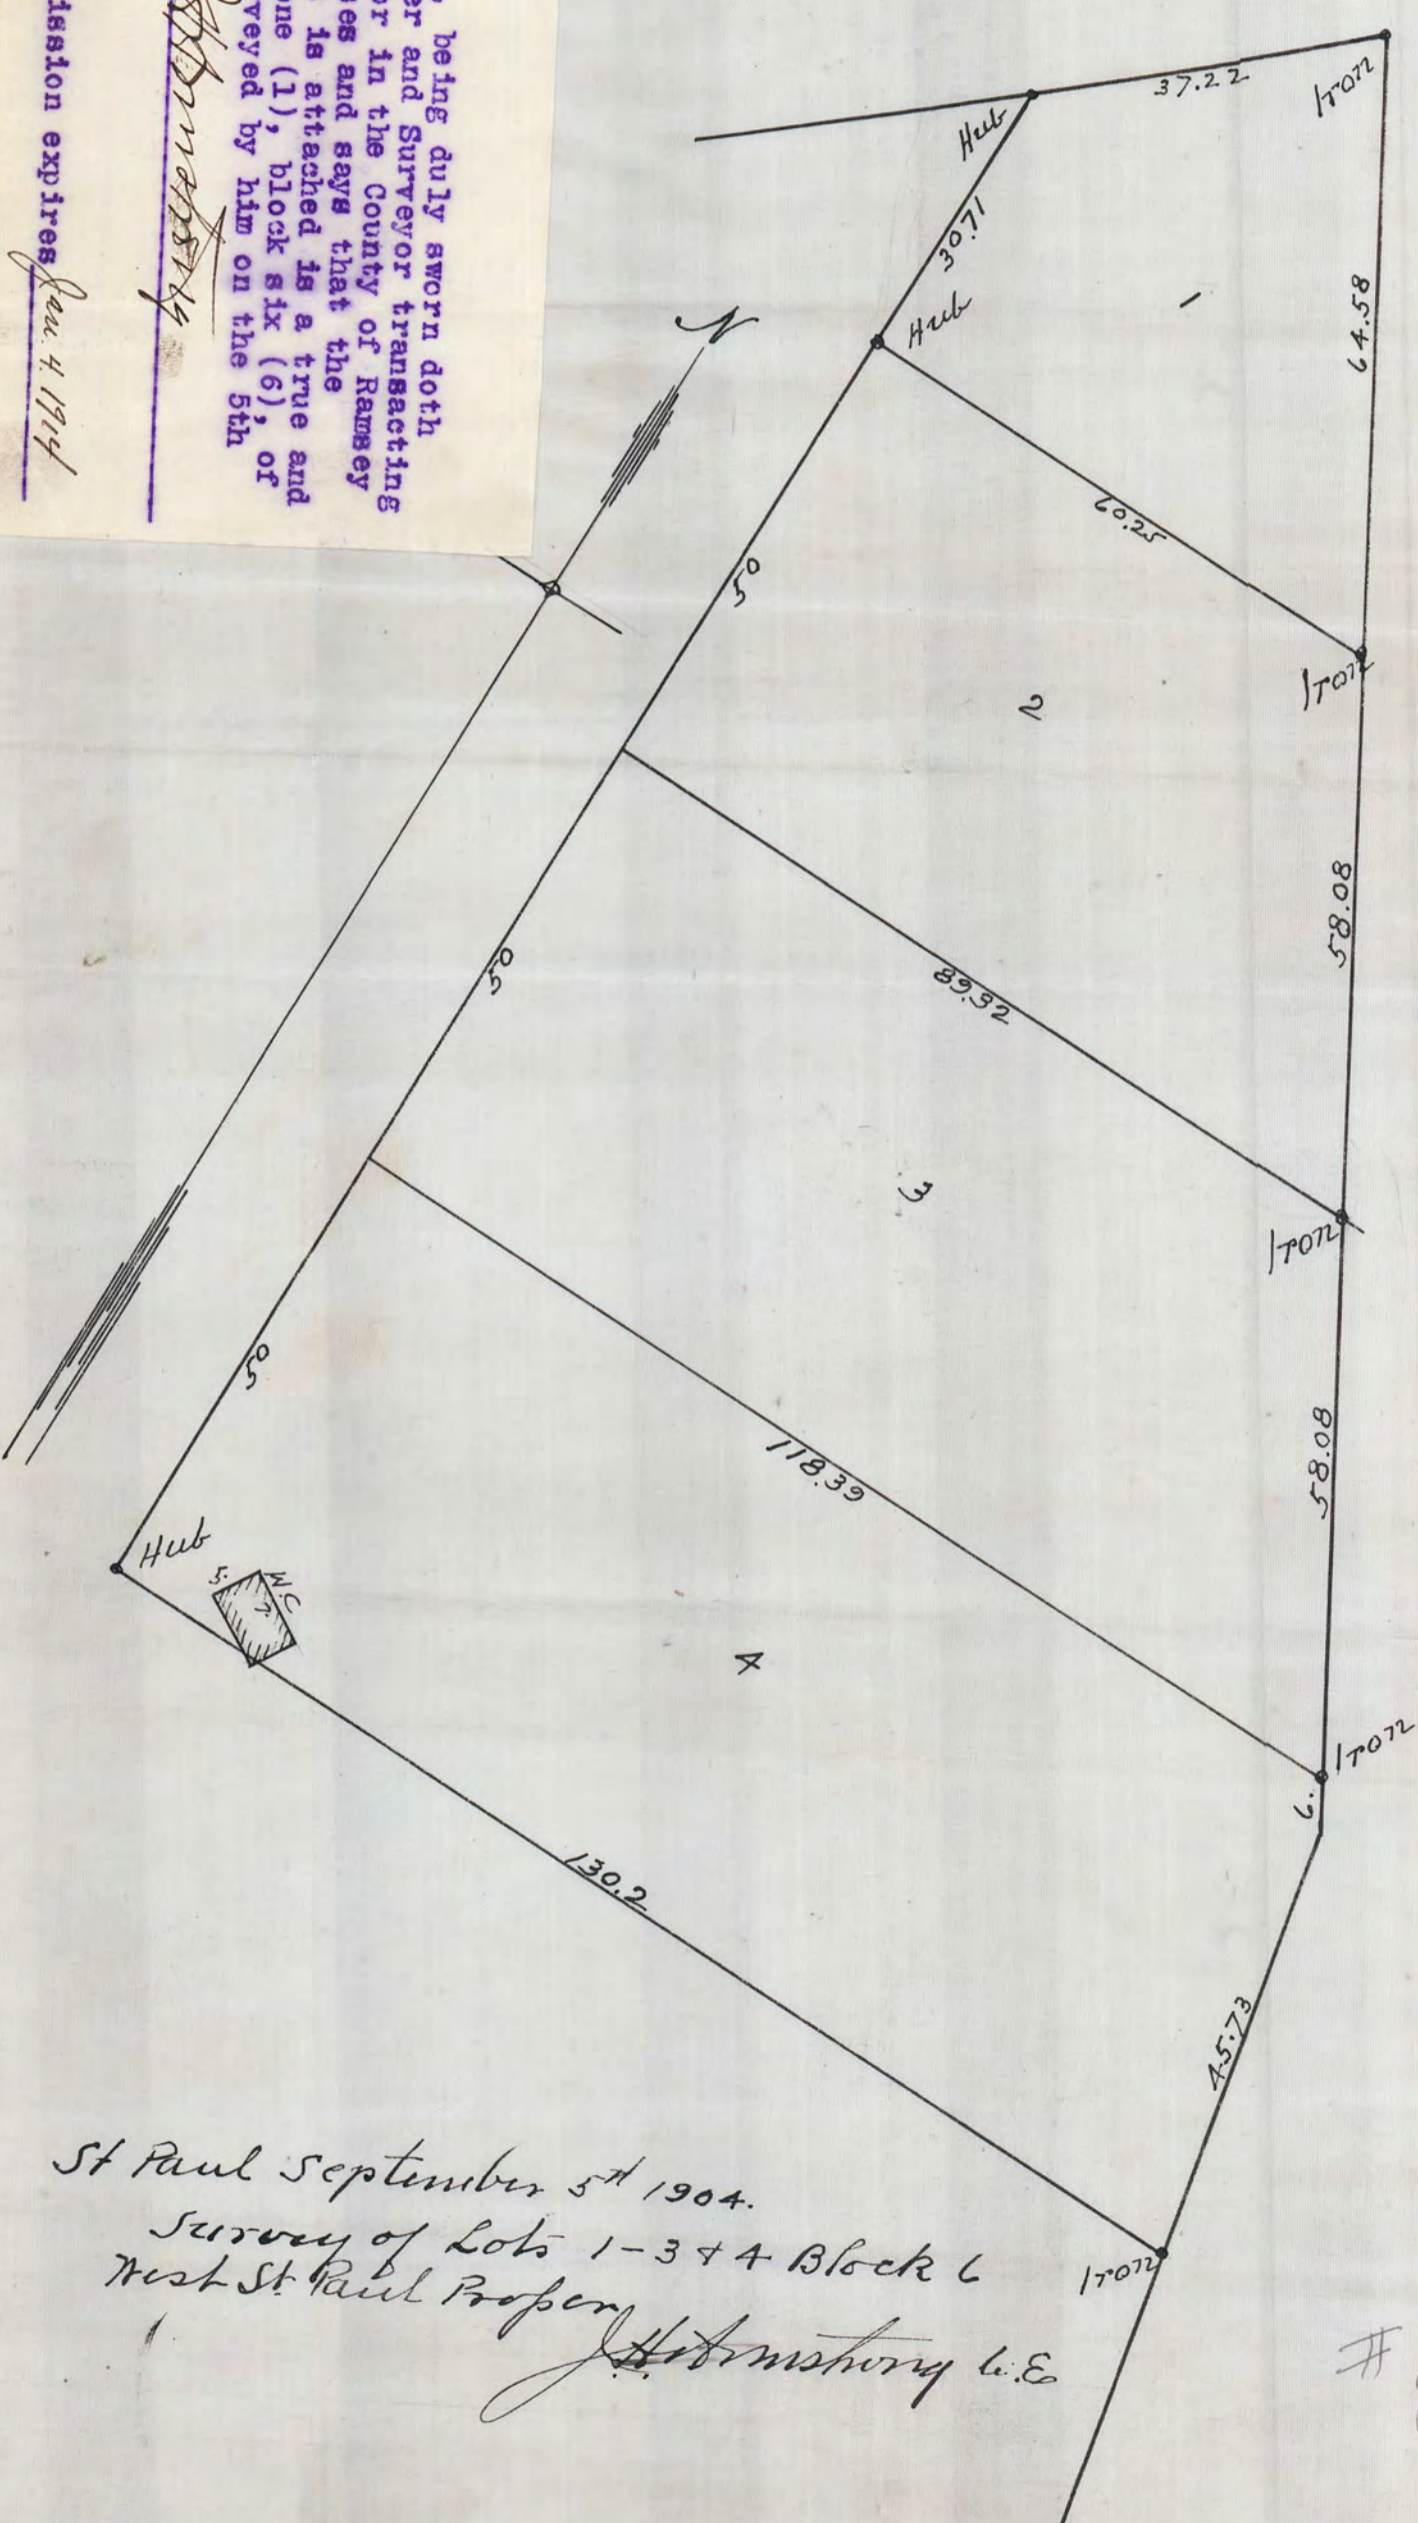

STATE OF MINNESOTA,)
) (SS. J. H. Armstrong, being duly sworn doth
 County of Ramsey.)
 depose and say that he is a Civil Engineer and Surveyor transacting
 his business as such Engineer and Surveyor in the County of Ramsey
 and State of Minnesota. He further deposes and says that the
 diagram or survey to which this affidavit is attached is a true and
 correct plat; diagram and survey of lot one (1), block six (6), of
 West St. Paul Proper, as the same was surveyed by him on the 5th
 day of September, A. D. 1904.
 Subscribed and sworn to before me
 this 28th day of July, A. D. 1909.
William D. White
 Notary Public, Ramsey Co., Minn. My Commission expires Jan. 4, 1914.

St Paul September 5th 1904.
 Survey of Lots 1-344 Block 6
 West St. Paul Proper
J. H. Armstrong L.E.

871