

# LOT 5 BLOCK 4

## # 8763

### BANNING AND OLIVER'S ADD.


SURVEYED BY  
SECURITY SURVEYING Co.

JULY 9<sup>TH</sup> 1923

11 DETROIT BLDG.


SCALE 20 FT. PER INCH.

ST. PAUL MINN.

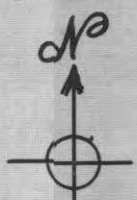

57'

ORLEANS

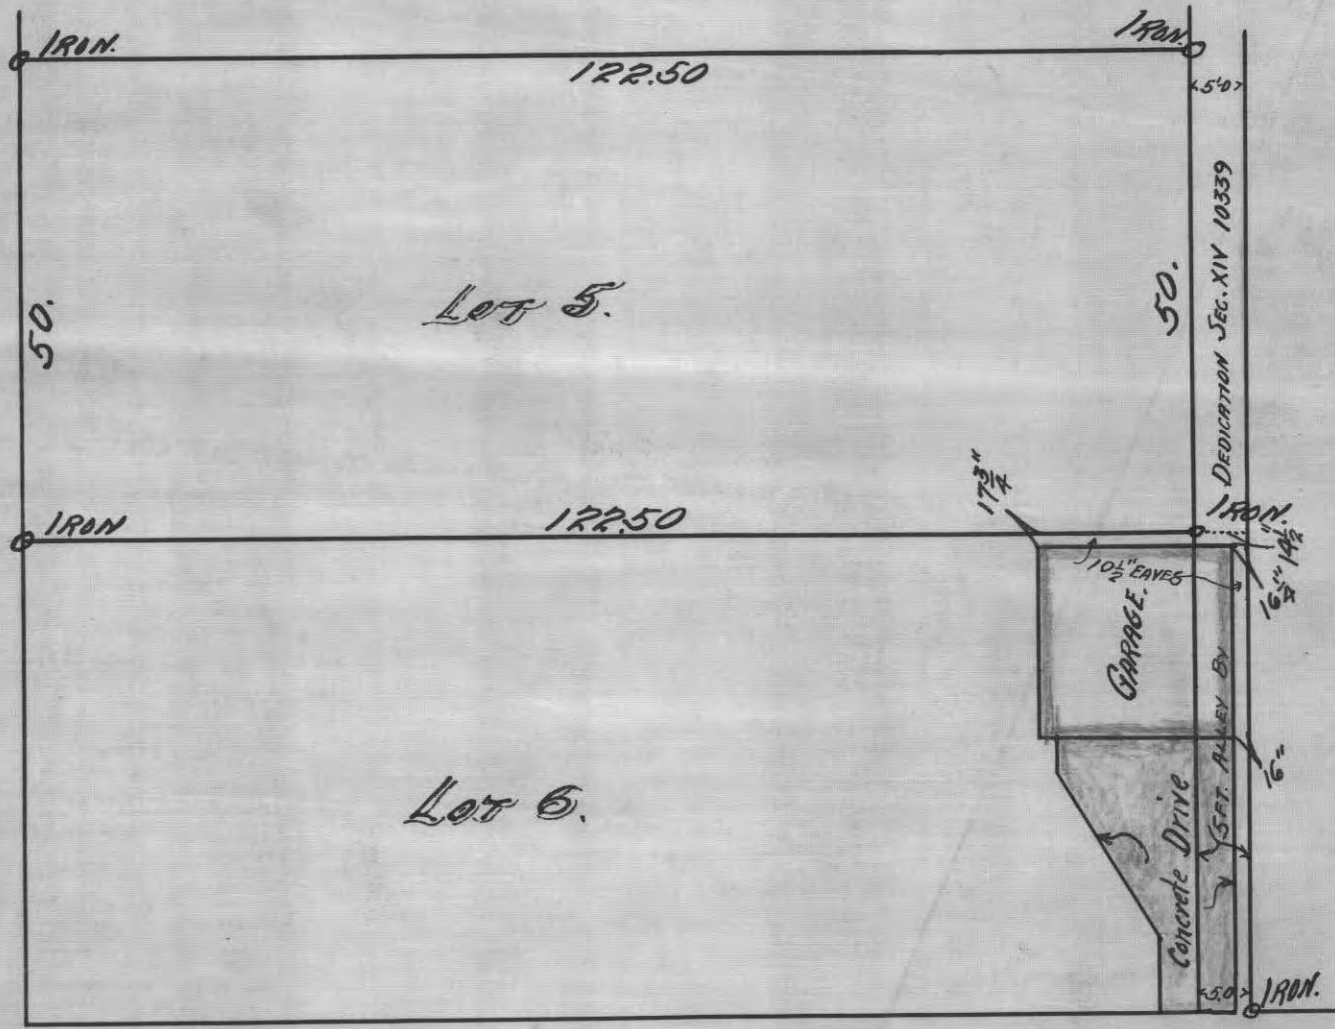

MORTON

57'

## # 8763