


8787

# CERTIFICATE OF SURVEY

James F. Simonet  
MINNESOTA REGISTERED LAND SURVEYOR NO. 705

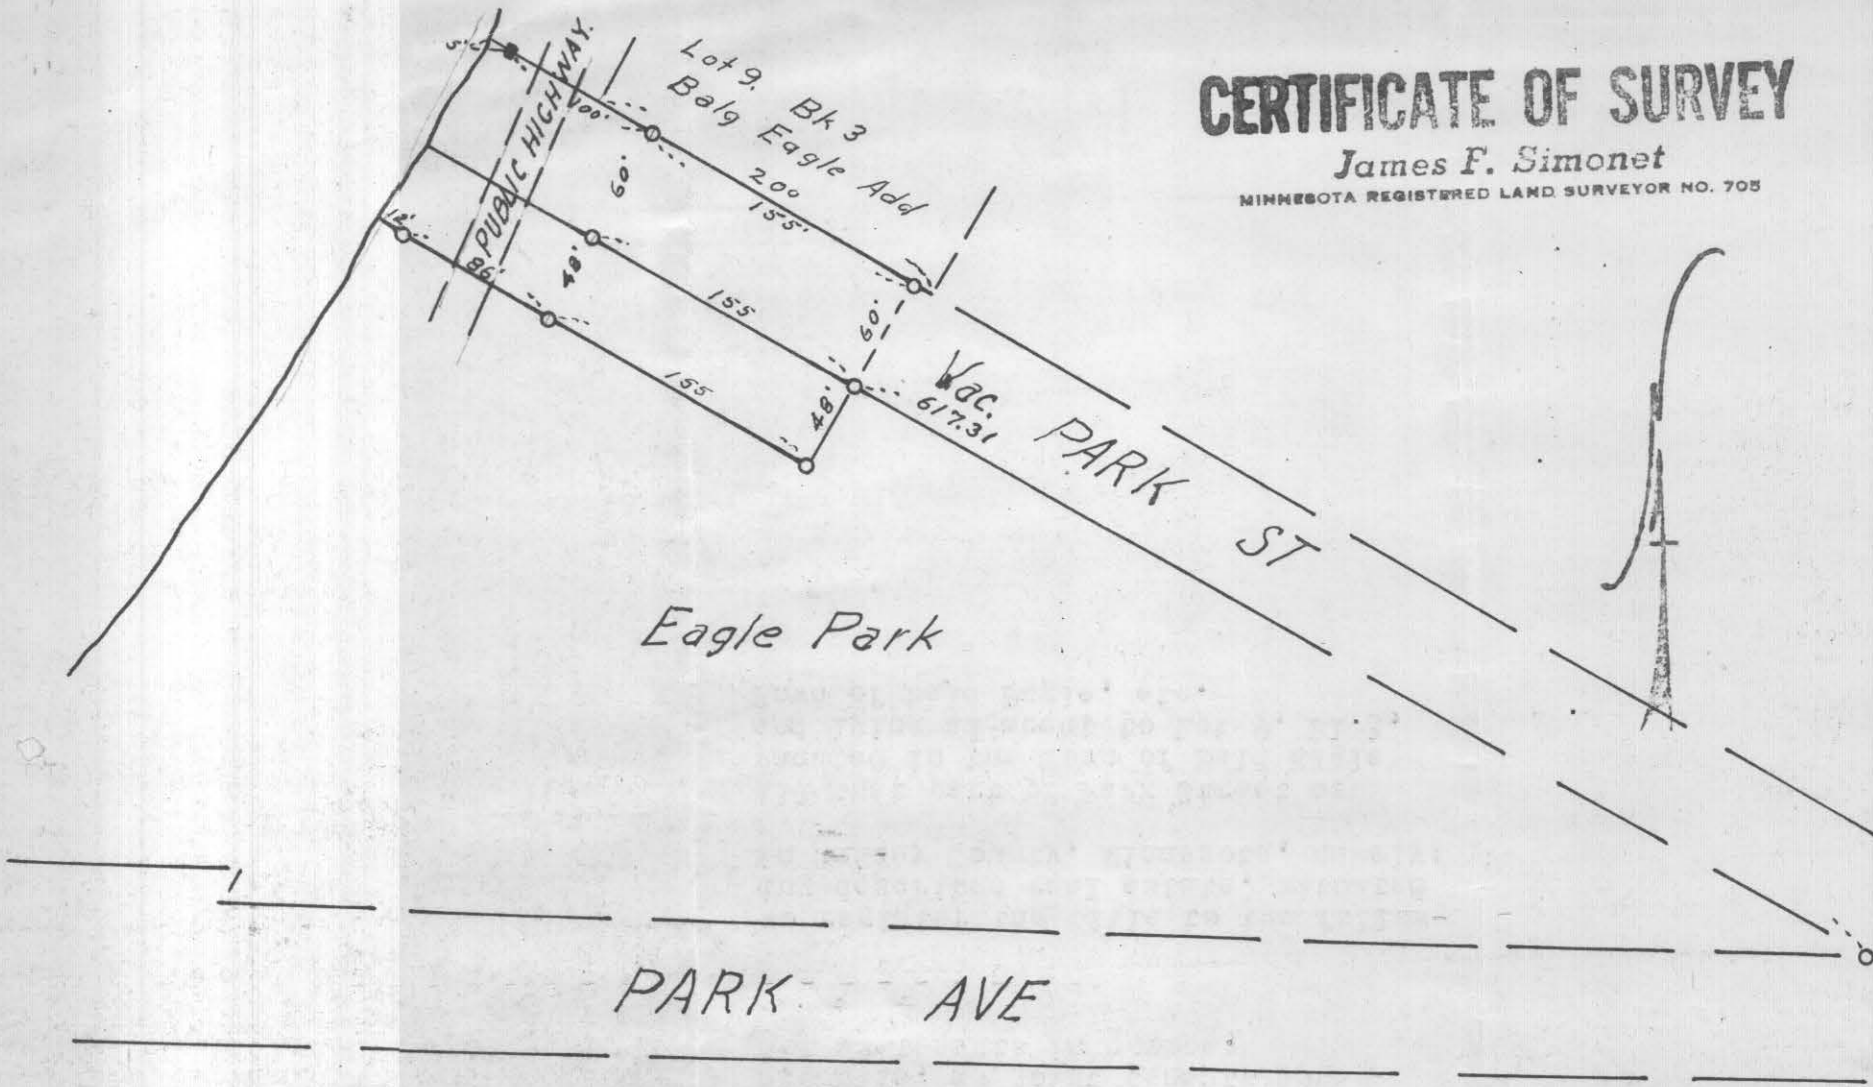

Survey made for Mr Bruce David  
 Part of Eagle Park of Bald Eagle Add. Ramsey Co. Minn.  
 o irons ■ Stake.



James F. Simonet  
 SURVEYOR  
 Stillwater, Minnesota

I hereby certify that the above drawing is  
 true and correct as shown. Surveyed by  
*James F. Simonet*  
 Date 19 July 1956 Surveyor  
 Scale 1" = 100'

#8787