


E. EIGHTH ST.

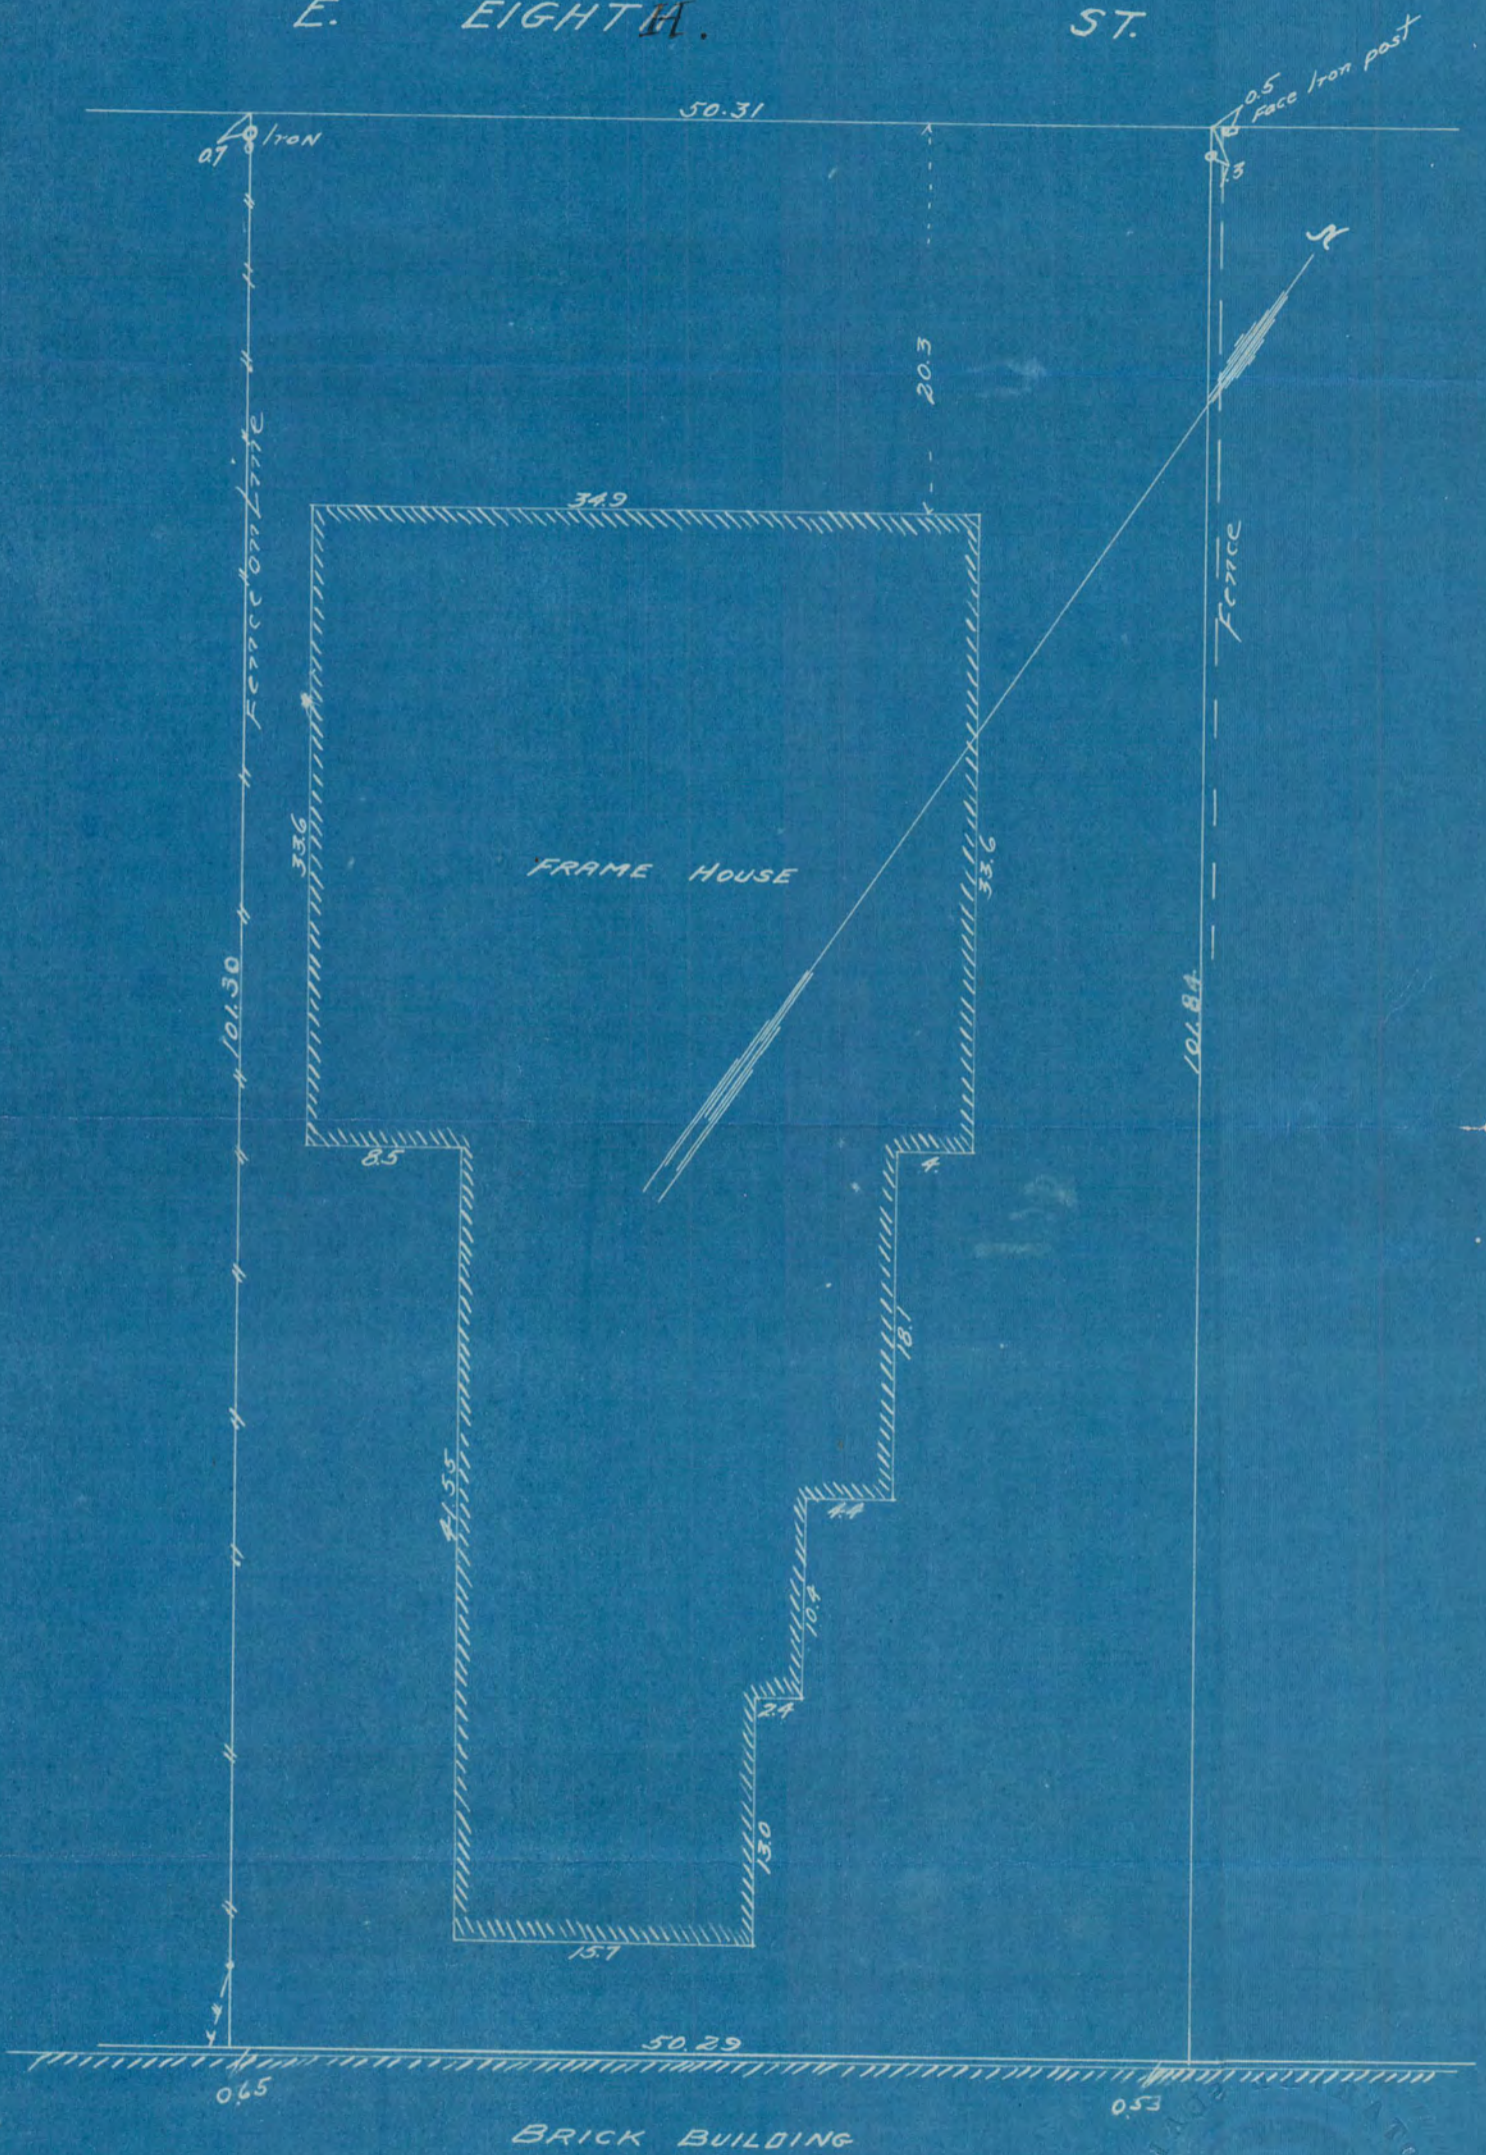

SURVEY OF THE MIDDLE 1/3 OF LOTS 1 AND 2 BLOCK 3
 WHITNEY AND SMITHS ADDITION.
 AUG. 1909.

J. H. Armstrong C. E.
 Scale 10 = 1 inch

#883