


CONCORD

ST.

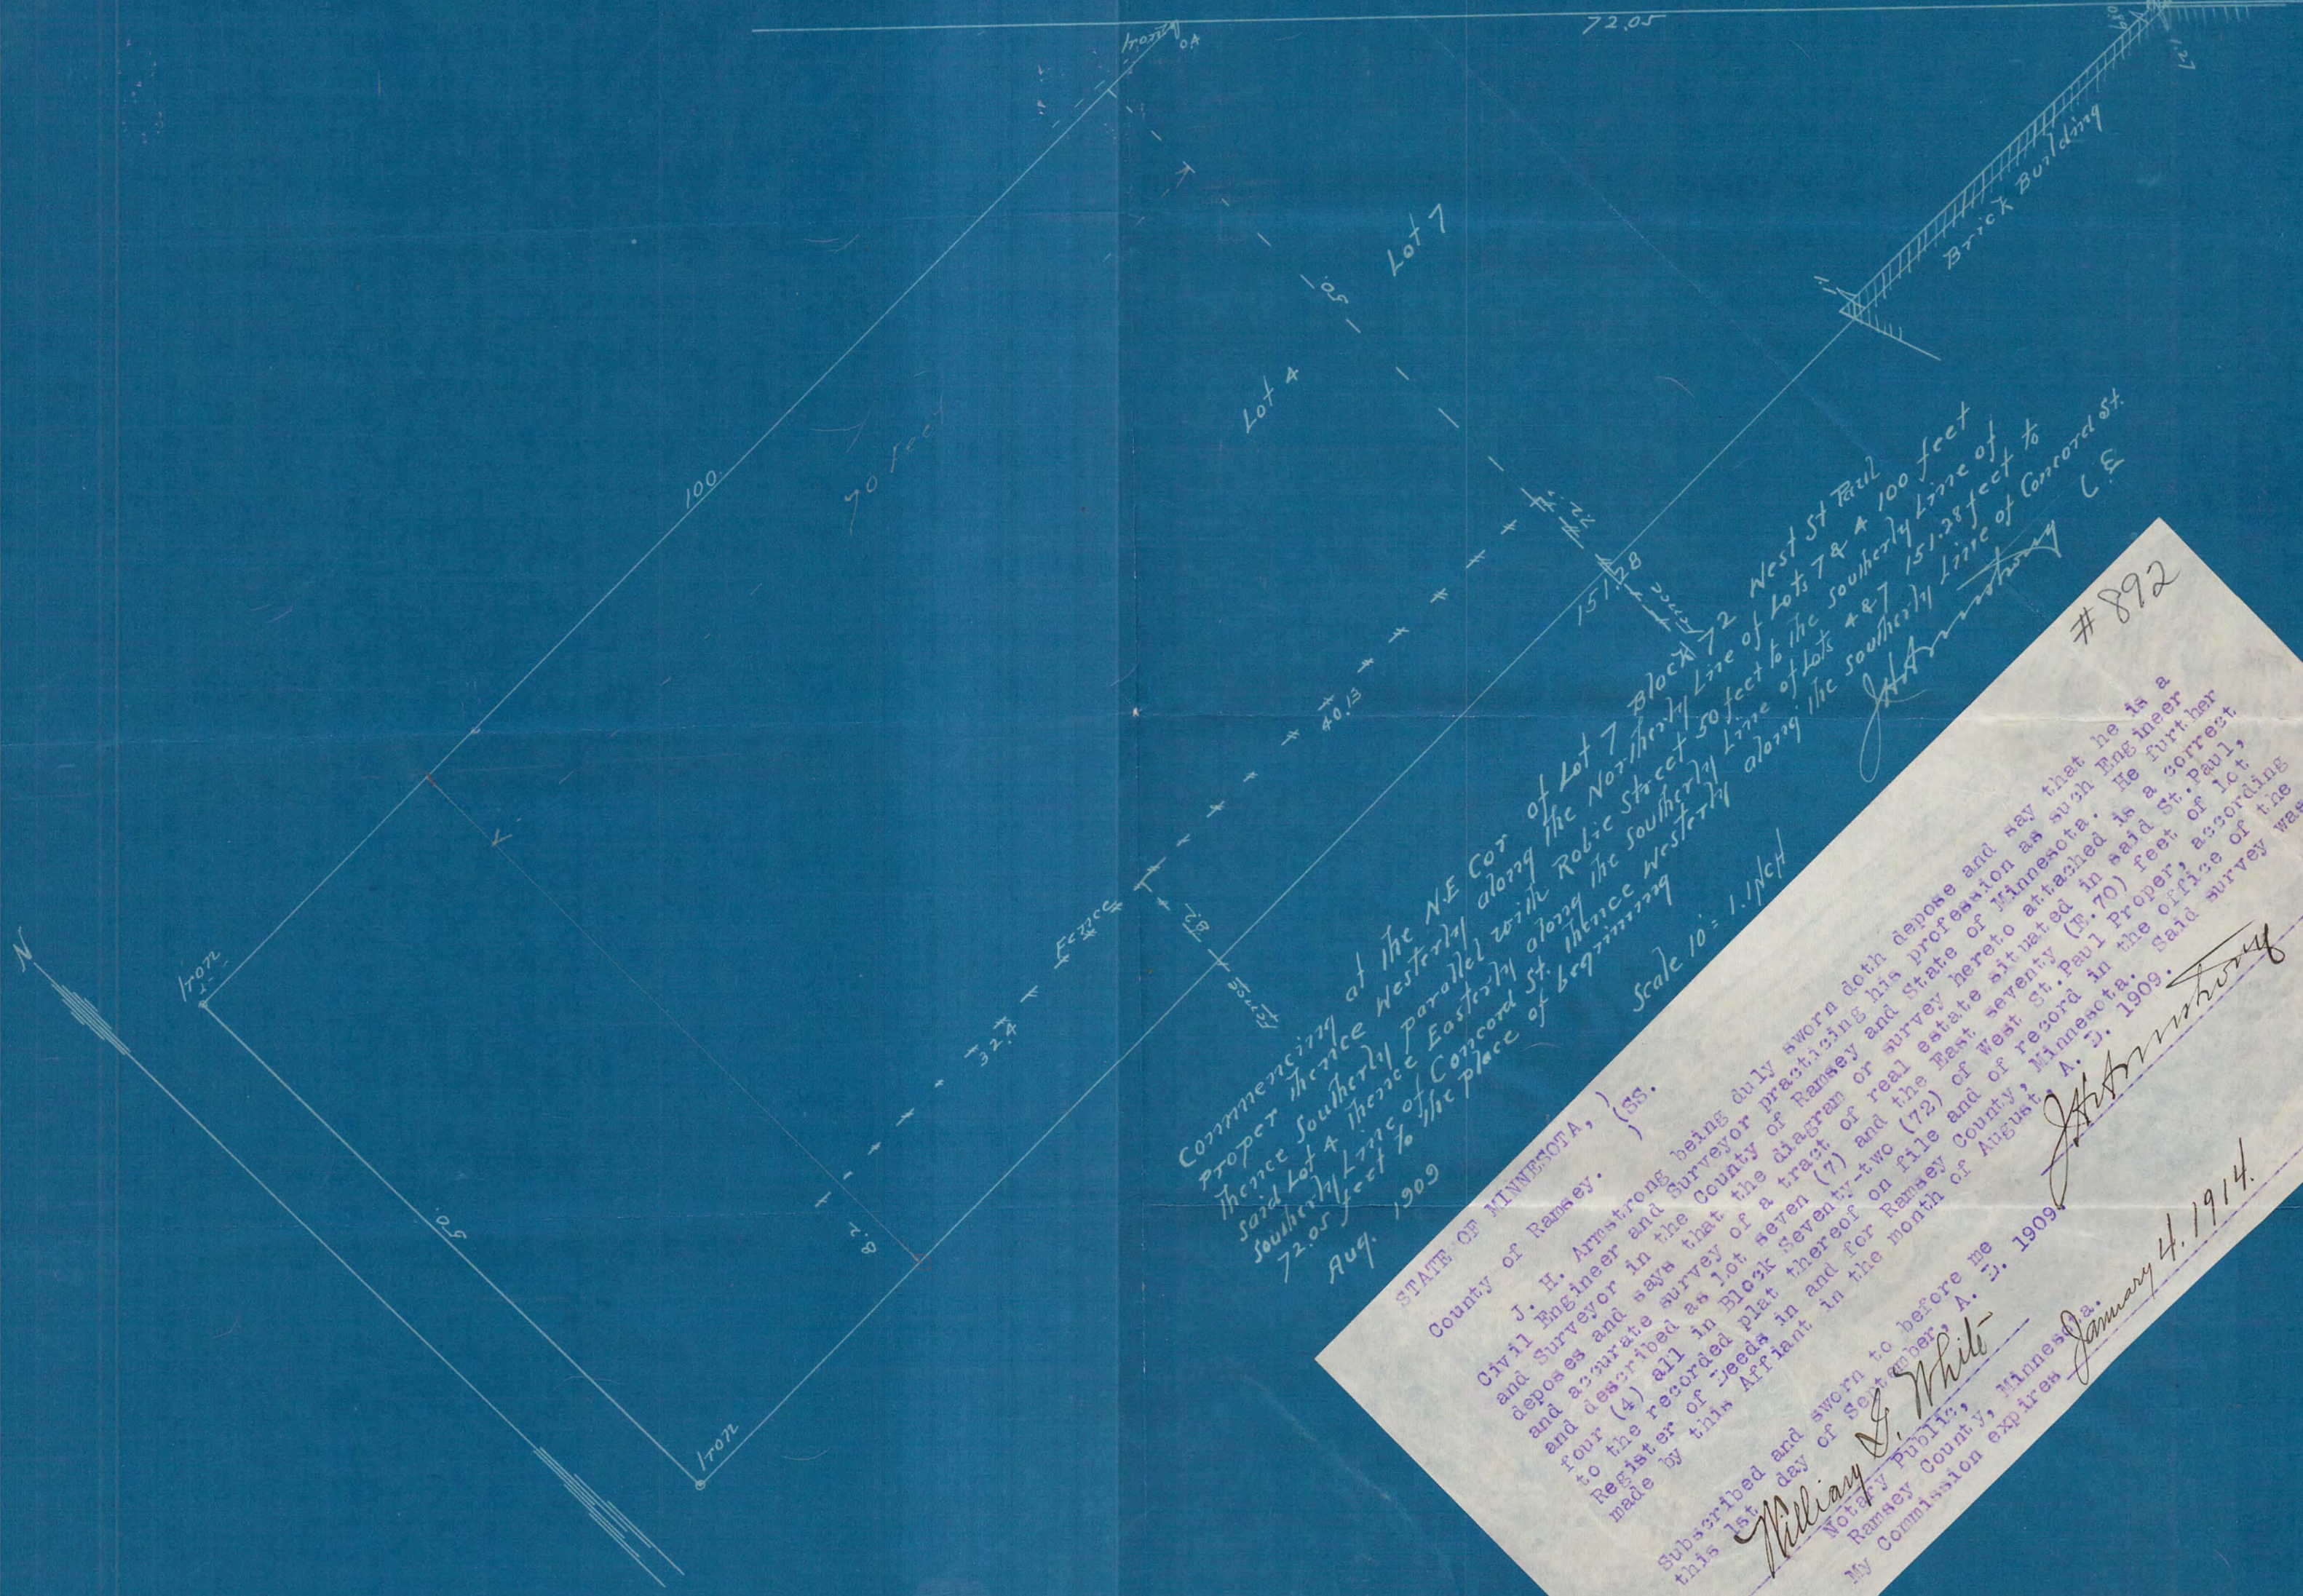

Commencing at the N.E. Cor of Lot 7 Block 72 West St Paul
 Property thence westerly along the Northernly line of Lots 7 & A 100 feet
 thence southerly parallel with Robie Street 50 feet to the southerly line of
 said Lot A thence Easterly along the southerly line of Lots 4 & 7 151.28 feet to
 southerly line of Concord St. thence westerly along the southerly line of Concord St.
 72.05 feet to the place of beginning

Aug. 1909

J. H. Armstrong C.E.

Scale 10" = 1.1/4"

892

STATE OF MINNESOTA,)
 County of Ramsey.) S.S.

J. H. Armstrong being duly sworn doth depose and say that he is a
 Civil Engineer and Surveyor practicing his profession as such Engineer
 and deposes and says that the diagram or survey hereto attached is a correct
 and accurate survey of a tract of real estate situated in said St. Paul,
 four (4) all in Block Seventy-two (72) of West St. Paul Property, according
 to the recorded plat thereof on file and of record in the office of the
 Register of Deeds in and for Ramsey County, Minnesota, A. J. 1909.
 made by this Affiant in the month of August, A. J. 1909.

Subscribed and sworn to before me
 this 1st day of September, A. J. 1909.

William G. White
 Notary Public, Minnesota.
 My Commission expires

J. H. Armstrong
 January 4, 1914.