


E. FIFTH

ST.

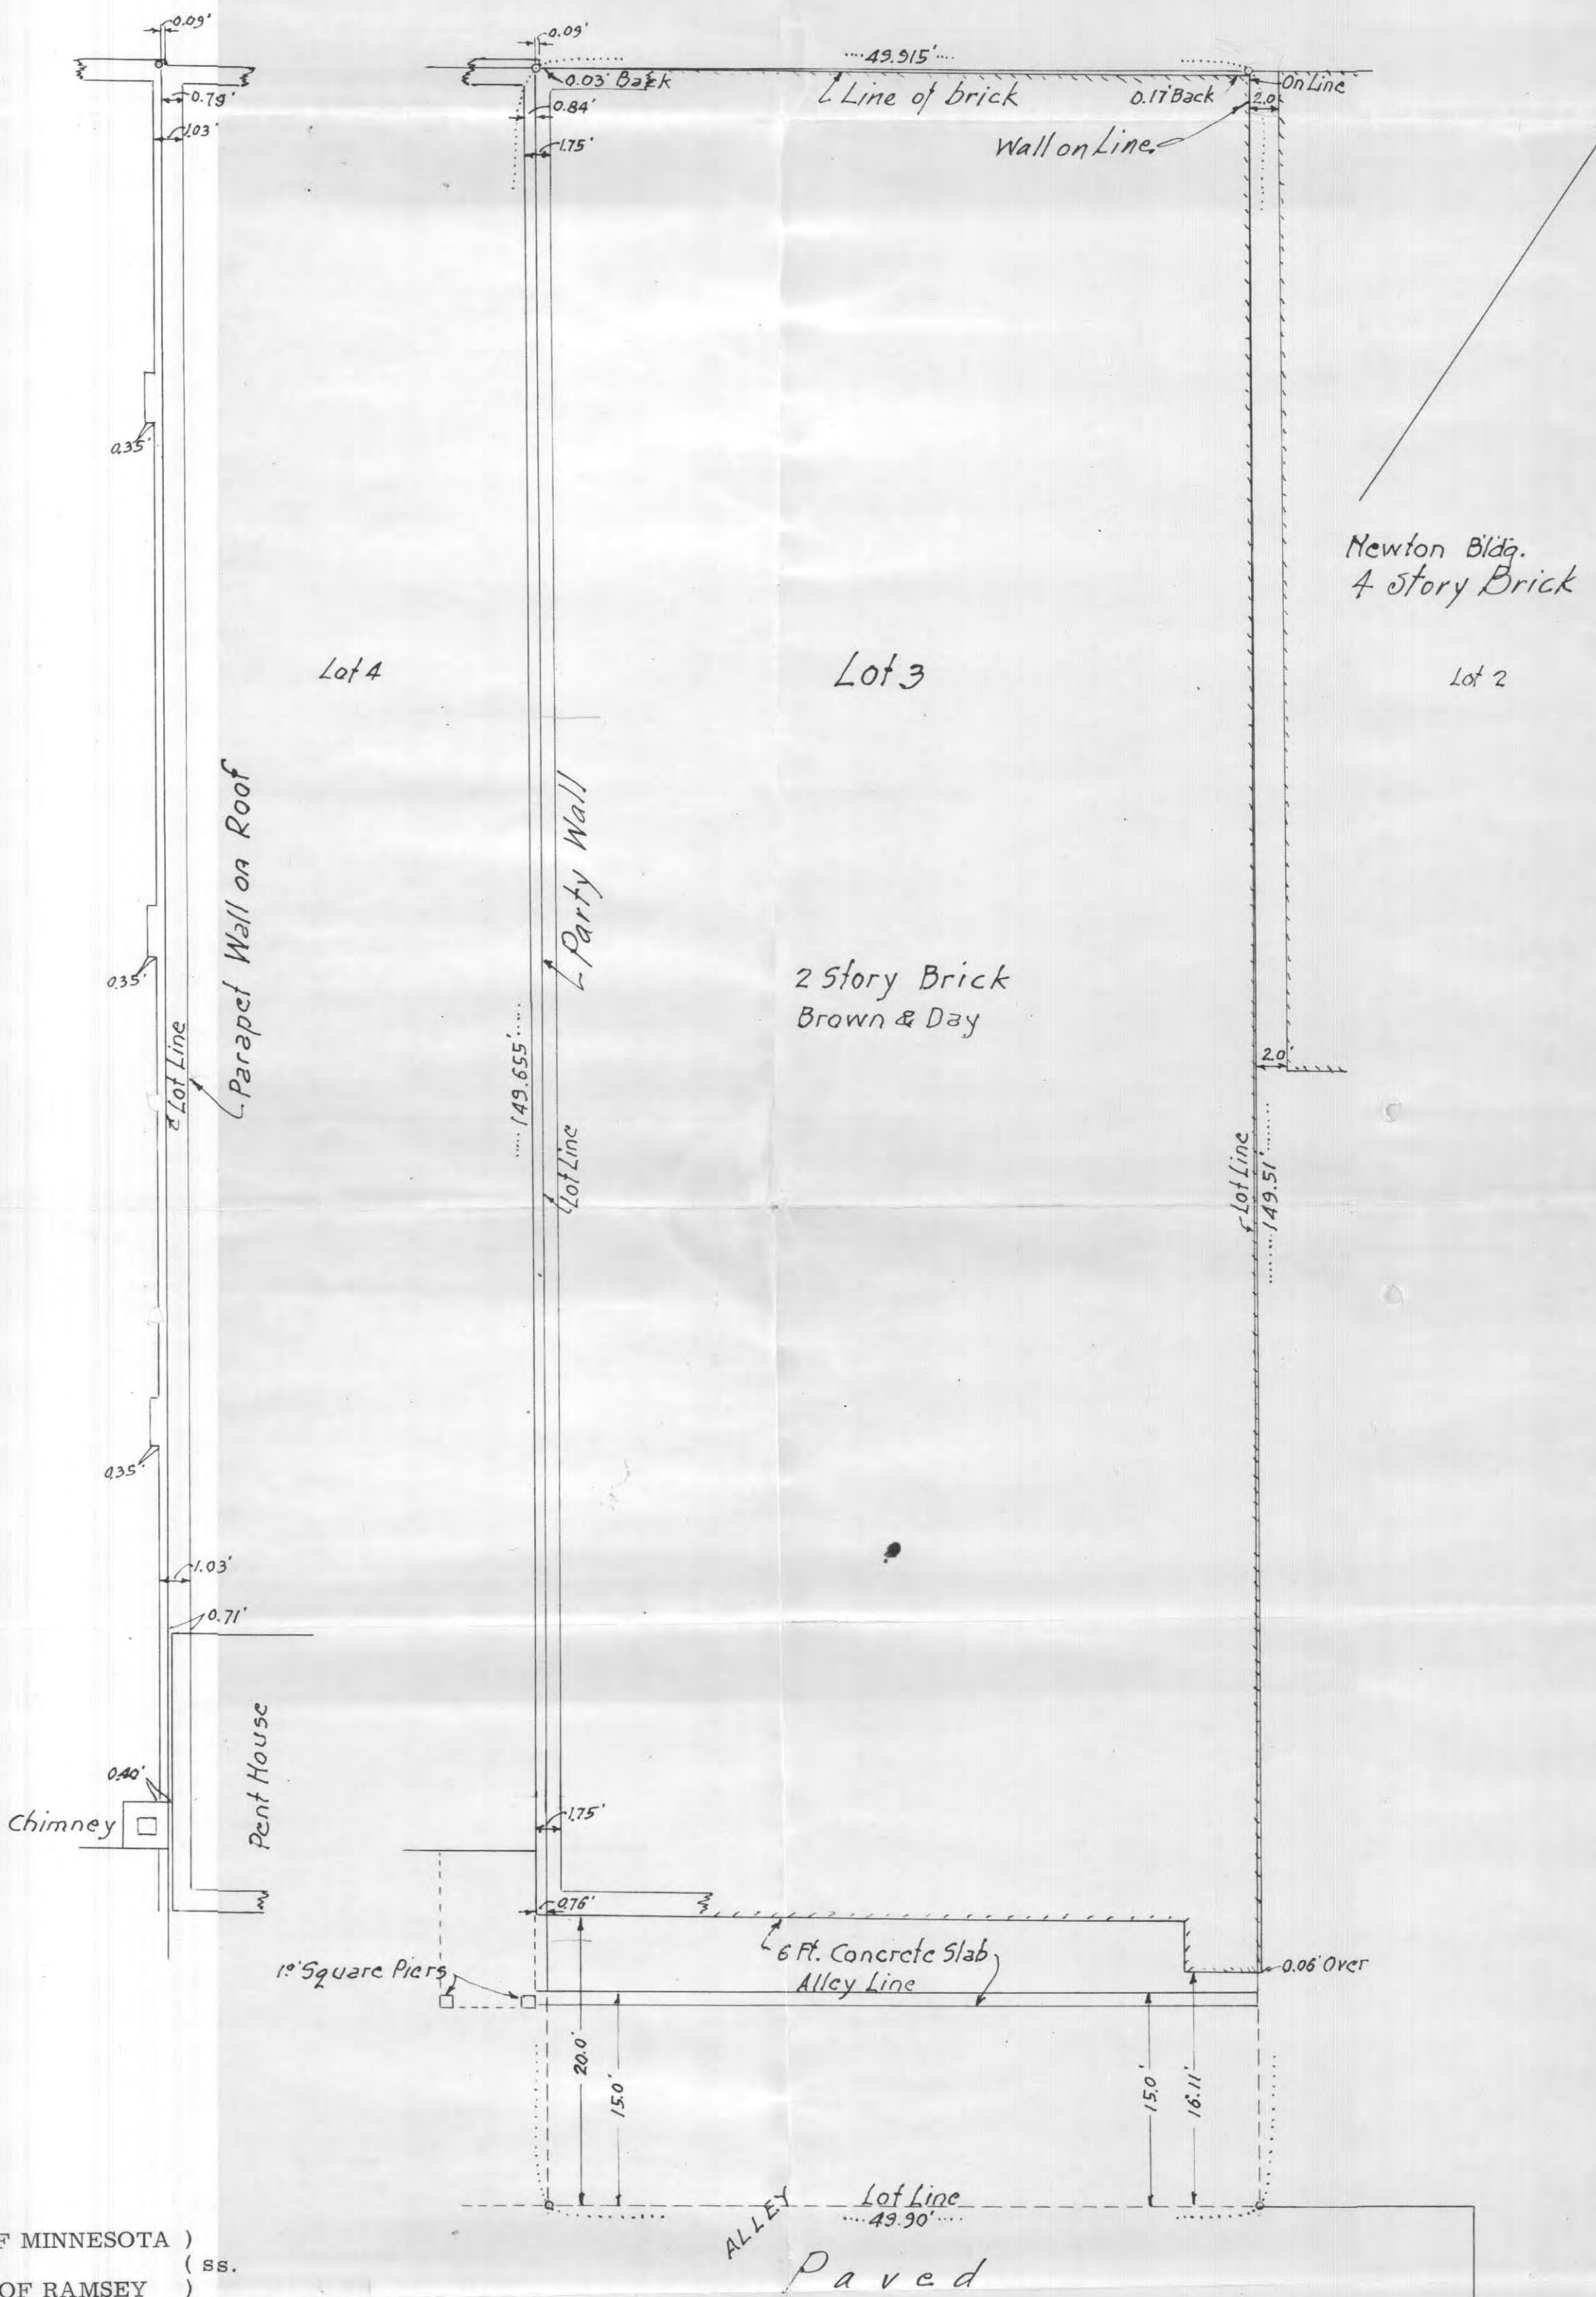

STATE OF MINNESOTA)
) ss.
 COUNTY OF RAMSEY)

I, F. J. ARMSTRONG, do herein and hereby certify that I am, and for many years last past have been, a duly Registered Civil Engineer and Surveyor, and that I made a survey of the real property situate in the City of Saint Paul, County and State aforesaid, and described as follows:

Lot Three (3) in Block Nineteen (19), St. Paul Proper, according to the plat thereof on file and of record in the office of the Register of Deeds in and for said Ramsey County, Minnesota; that said survey was made on November 3rd, 1954, and that the foregoing plat of survey was thereafter made by me and that the same correctly shows the boundary lines of said real property and the location of the improvements thereon.

Subscribed and sworn to before me this 8th day of October, 1956.

Thomas D. Differt

THOMAS D. DIFFERT
 Notary Public, Ramsey County, Minn.
 My Commission Expires Sept. 20, 1961

MAP OF SURVEY OF
 LOT 3, BLOCK 19, ST. PAUL PROPER.
 ST. PAUL, MINN.

Scale 1"=10' November 3rd 1954.

F. J. Armstrong Civil Engr

8988