


E. FIFTH

ST.

Stone base at sidewalk level

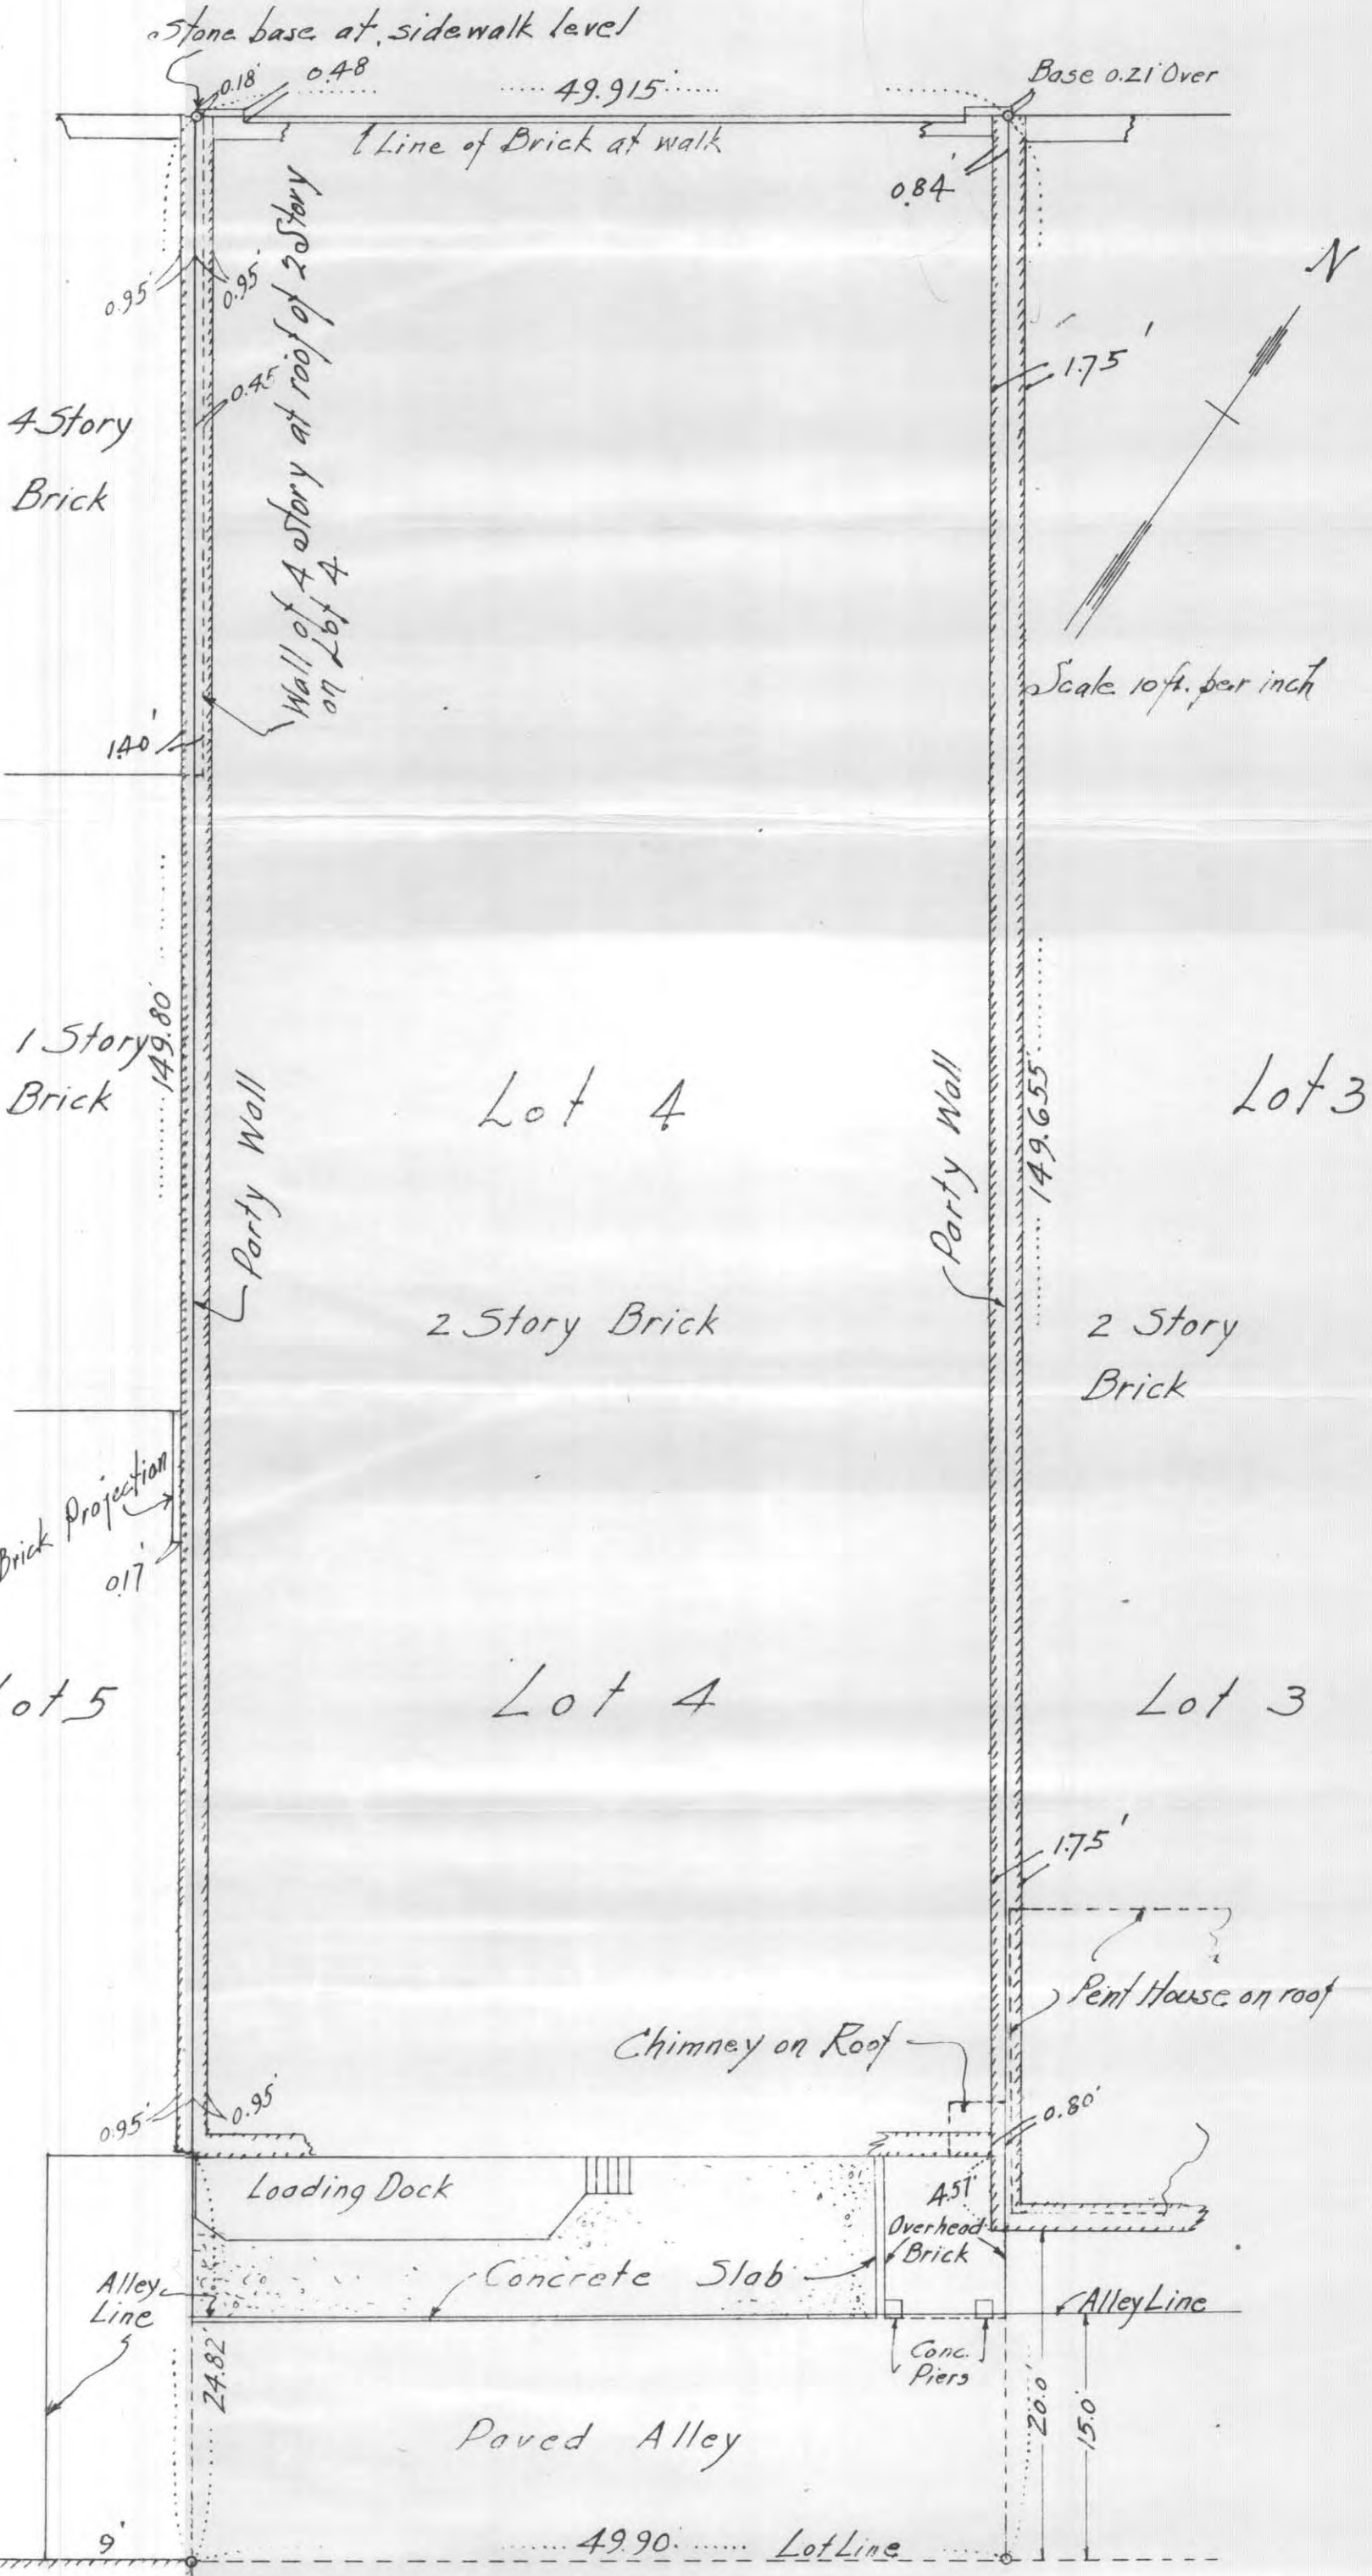

I hereby certify that this map correctly represents Lot 4 in Block 19 in what is commonly called St. Paul Proper; as surveyed by me in March 1957

Dated this 6th day of March 1957

A. J. Armstrong, Civil Engr

A. J. Armstrong

Subscribed and sworn to before me this 7th day of March 1957

Genevieve Wall
Notary Public, Ramsey County, Minn.

My Commission Expires Feb. 20, 1964



#9150