

9255

PR. 4-4492


WARREN I. FORSBERG

Registered Land Surveyor

2060 E. 5th St.
St. Paul 6, Minn.

PLAT OF SURVEY

PROPERTY OF John E. Blomquist, Inc.
described as follows: Lot #2, except the N.W. 1/4 14 feet thereof, Block 1, Auditor's Sub. No. 19, Ramsey County, Minn.

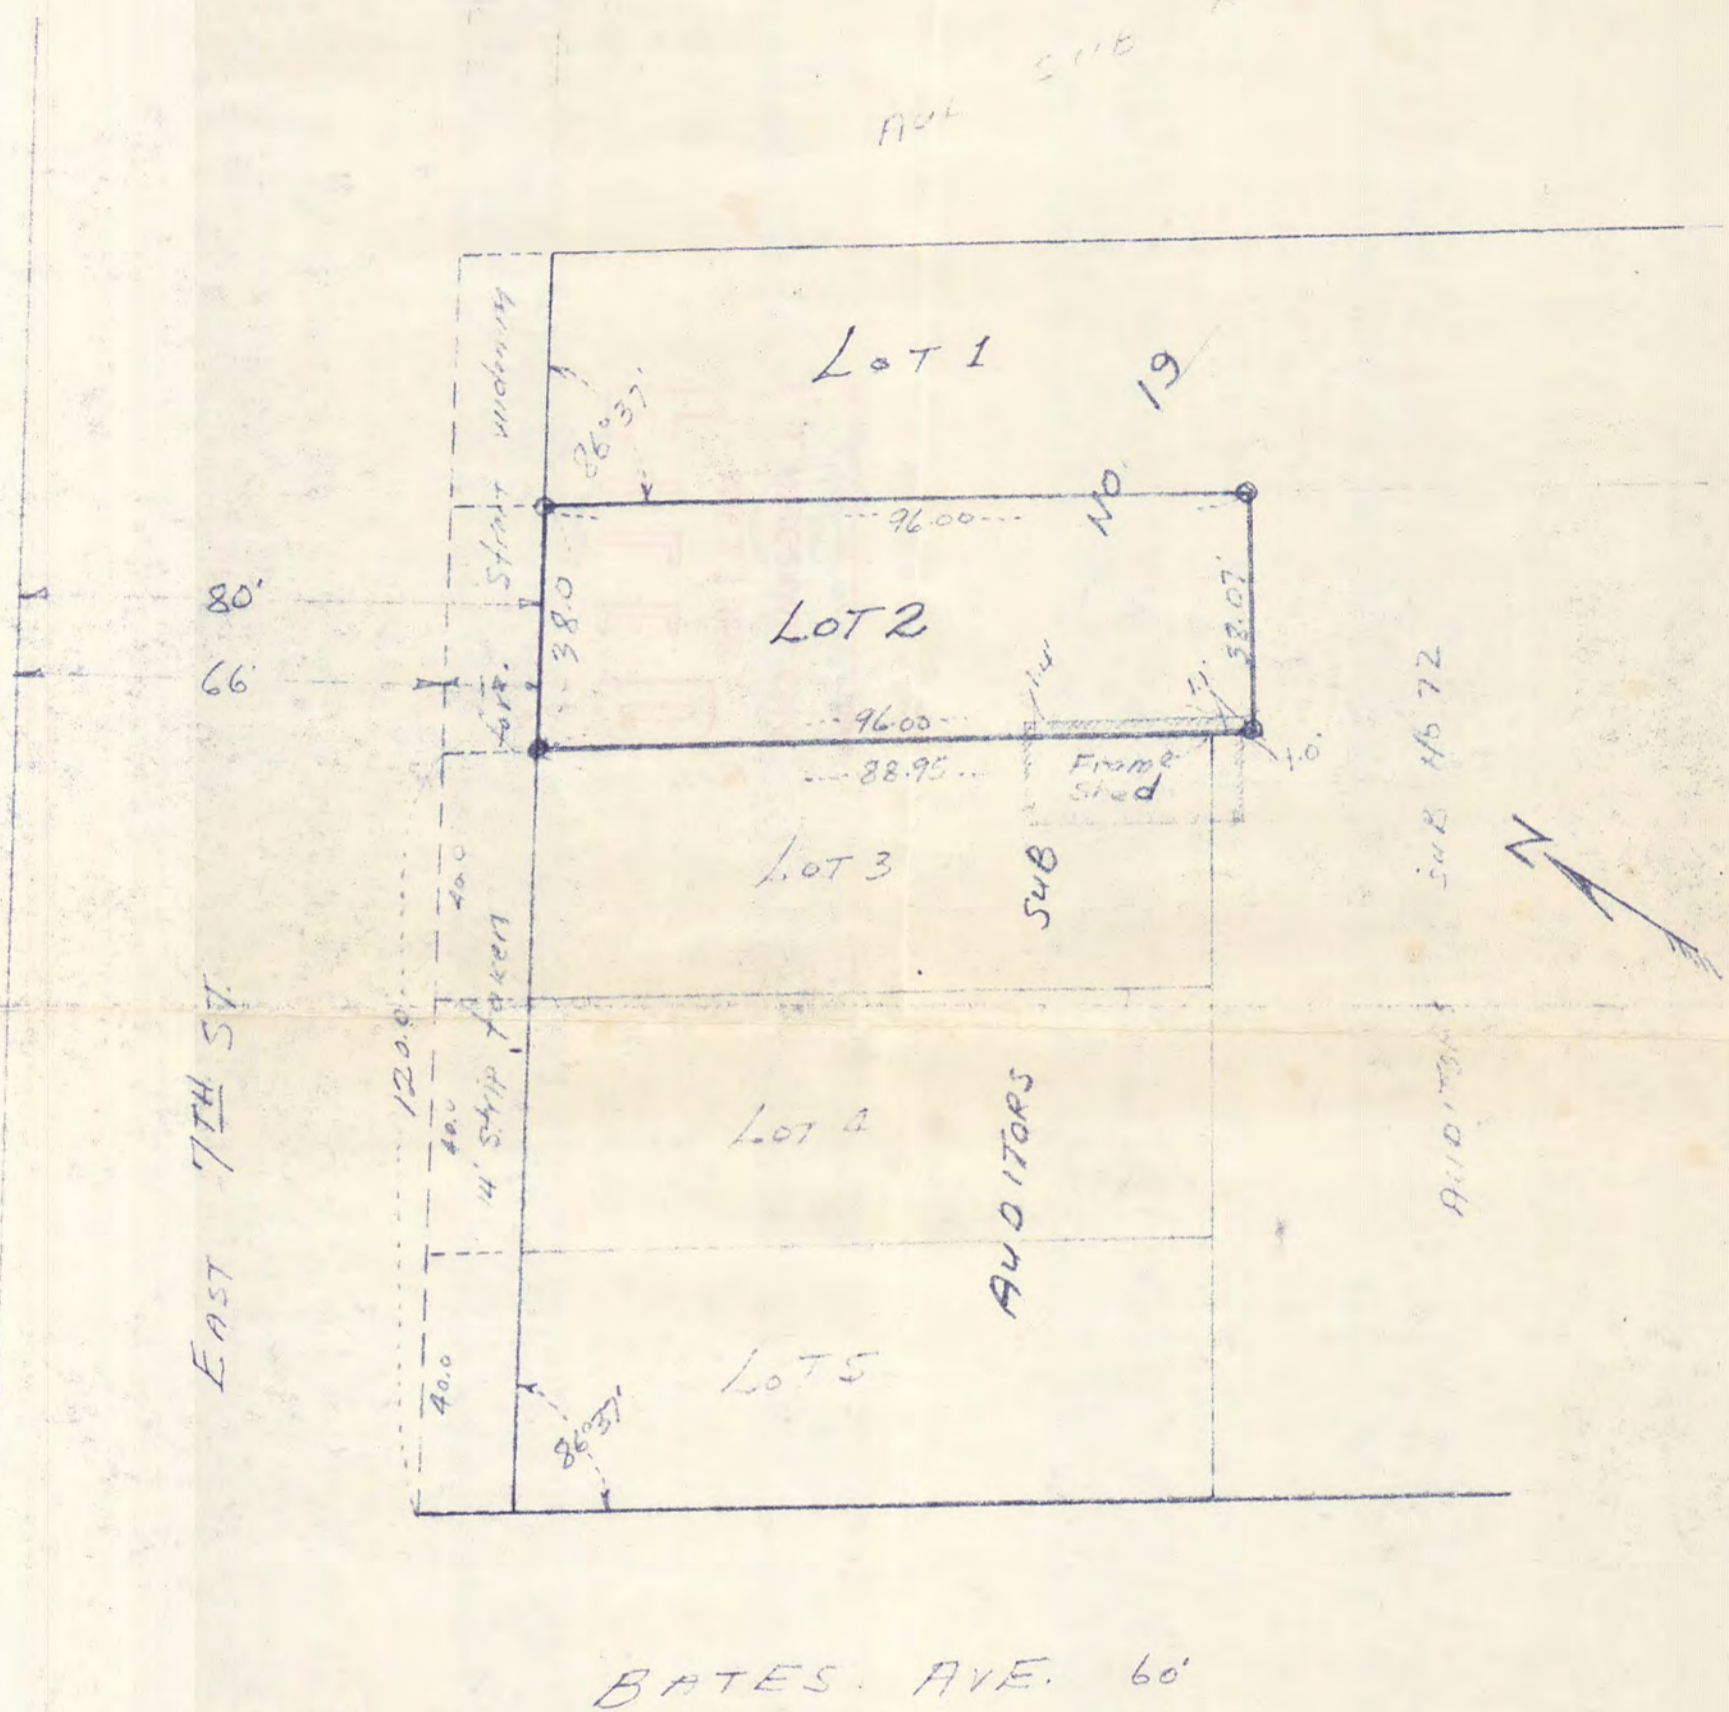

Correction OK Whitney

I hereby certify to having surveyed the above described property and that this plat is a correct representation of said survey and the same is correct. There are no traveled roads or easements on or across same and no encroachments except as shown.

Irving S. Forsberg
Irving S. Forsberg, Registered Surveyor
Minnesota Certificate No. 1734

State of Minnesota)
County of Ramsey)

On this 23rd day of October A. D. 1957 before me, the undersigned, personally appeared Irving S. Forsberg to me known to be the person described in and who executed the foregoing instrument and acknowledged that he executed the same as his free act and deed.

Kenneth E. Wincomb Oct. 4 1967
Notary Public, Ramsey County, Minn. My commission expires

CERTIFICATE OF SURVEY

I hereby certify that on _____, 19____ I surveyed the property described above and that the above plat is a correct representation of said survey.

Scale: 1 inch 30 feet.

O—Indicates Iron Monument.

June 26-1957

9255