PLAT OF SURVEY

OF PROPERTY OF FRANK D. MARZITELLI
DESCRIBED AS FOLLOWS:

Lot 5 Block 26 "COMO" St. Paul, Minnesota except the N. 92' thereof and except the S. 8.0' thereof taken for Arlington Ave. and that part of Fisk St (Vacated) accruing there to.

Scale 1" = 20' feet
° Indicates Iron

I. S. Forsberg Surveyor
567 Brainerd Ave.
P.R. 6-0985

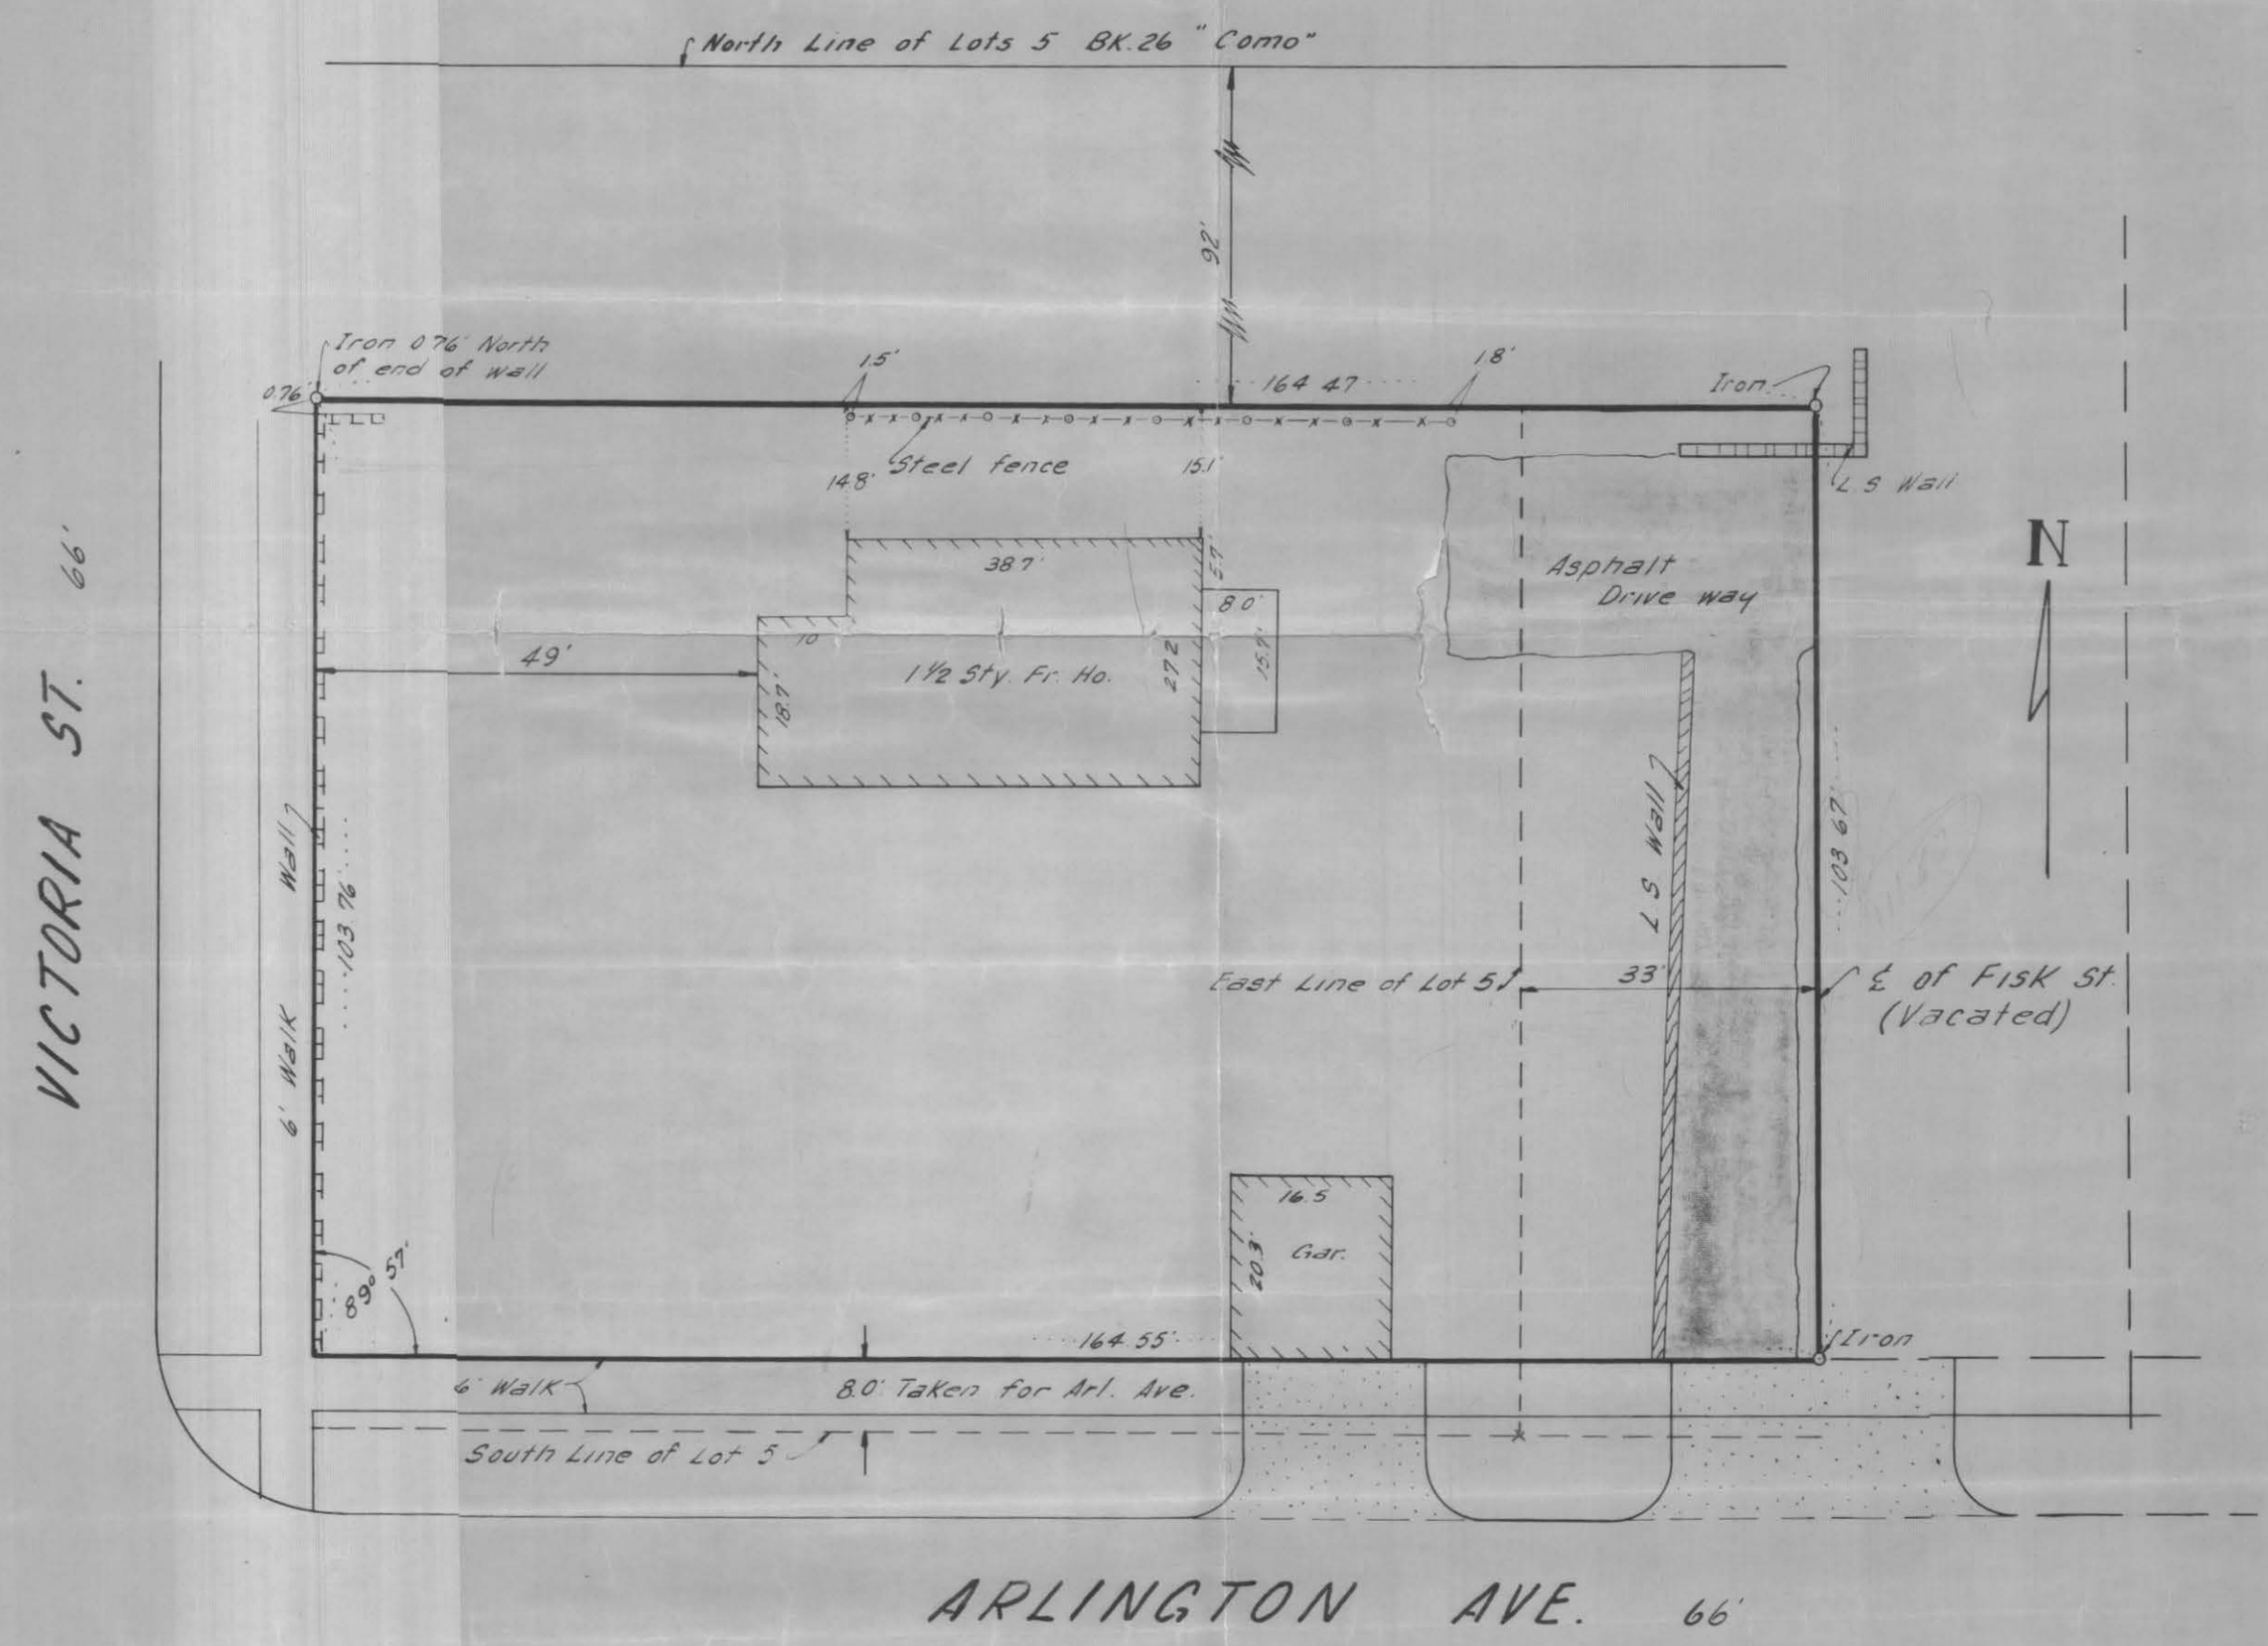

On this 26th day of February, 1958, before me, a Notary Public in and for Ramsey County, Minnesota, appeared I. S. Forsberg, to be known to be the person described in and who executed the within Certificate of Survey and acknowledged that he executed the same as his free act and deed.

Julia S. Spermbaur

Julia S. Spermbaur, Notary Public, Ramsey County, Minnesota
My commission expires December 8, 1964

CERTIFICATE OF SURVEY

I hereby certify that on June 30 1956 I surveyed the property described above and that the above plat is a correct representation of said survey, and same is correct.

I S Forsberg

Minnesota Registration № 1734

I S Forsberg

#9397