


#9399

CERTIFICATE of SURVEY

F. J. ARMSTRONG
Civil Engineer and Surveyor
ST. PAUL, MINN.



Lot 2

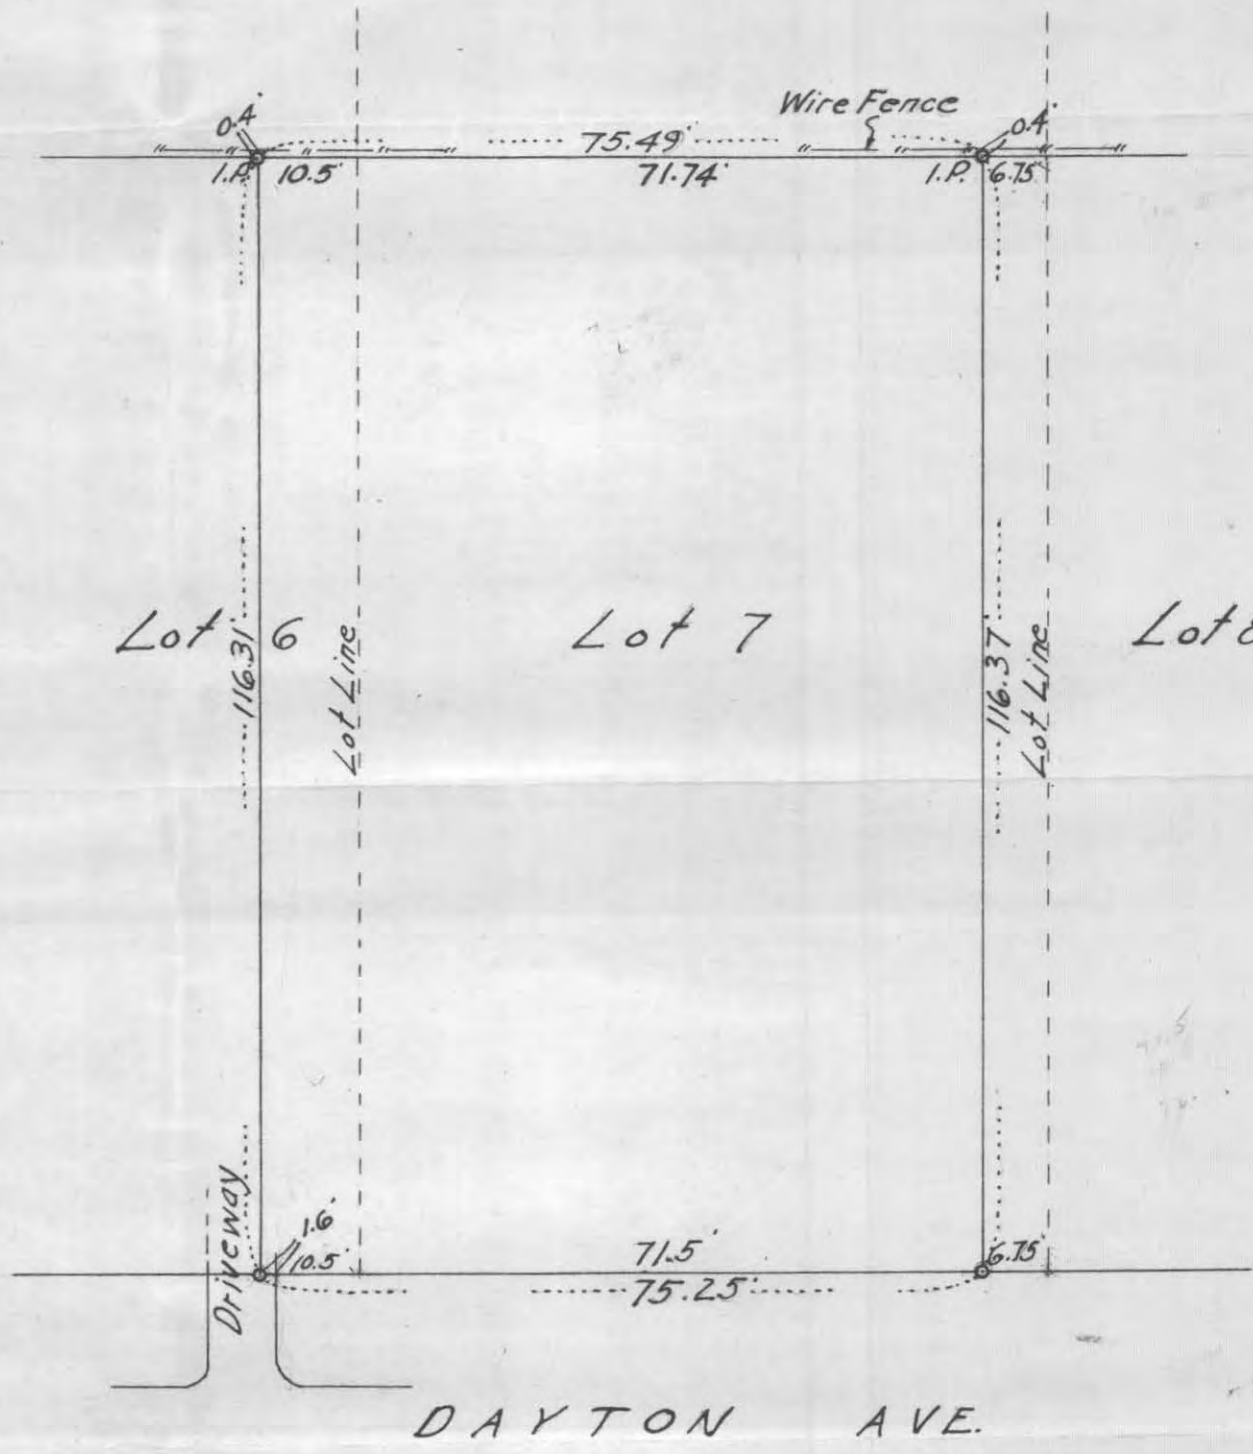

Scale: 20 ft. per inch

I HEREBY CERTIFY that on the 19th day of July, A. D. 1957

I made a survey of the following described property, to-wit: The East 10.5 ft. of Lot 6 and Lot 7 except the East 6.75 ft. Block 80 Dayton & Irvine's Add'n. to St. Paul, Minnesota

Subscribed and sworn to before me this

18th day of December, 1957

McNeil V. Seymour
Notary Public.

and the above map is a true and correct map of said survey and the improvements shown thereon are correctly indicated

McNEIL V. SEYMOUR

My Commission Expires Notary Public, Ramsey County, Minn.
My Commission Expires Aug. 22, 1963,

F. J. Armstrong
Civil Engineer