


VANDALIA STREET

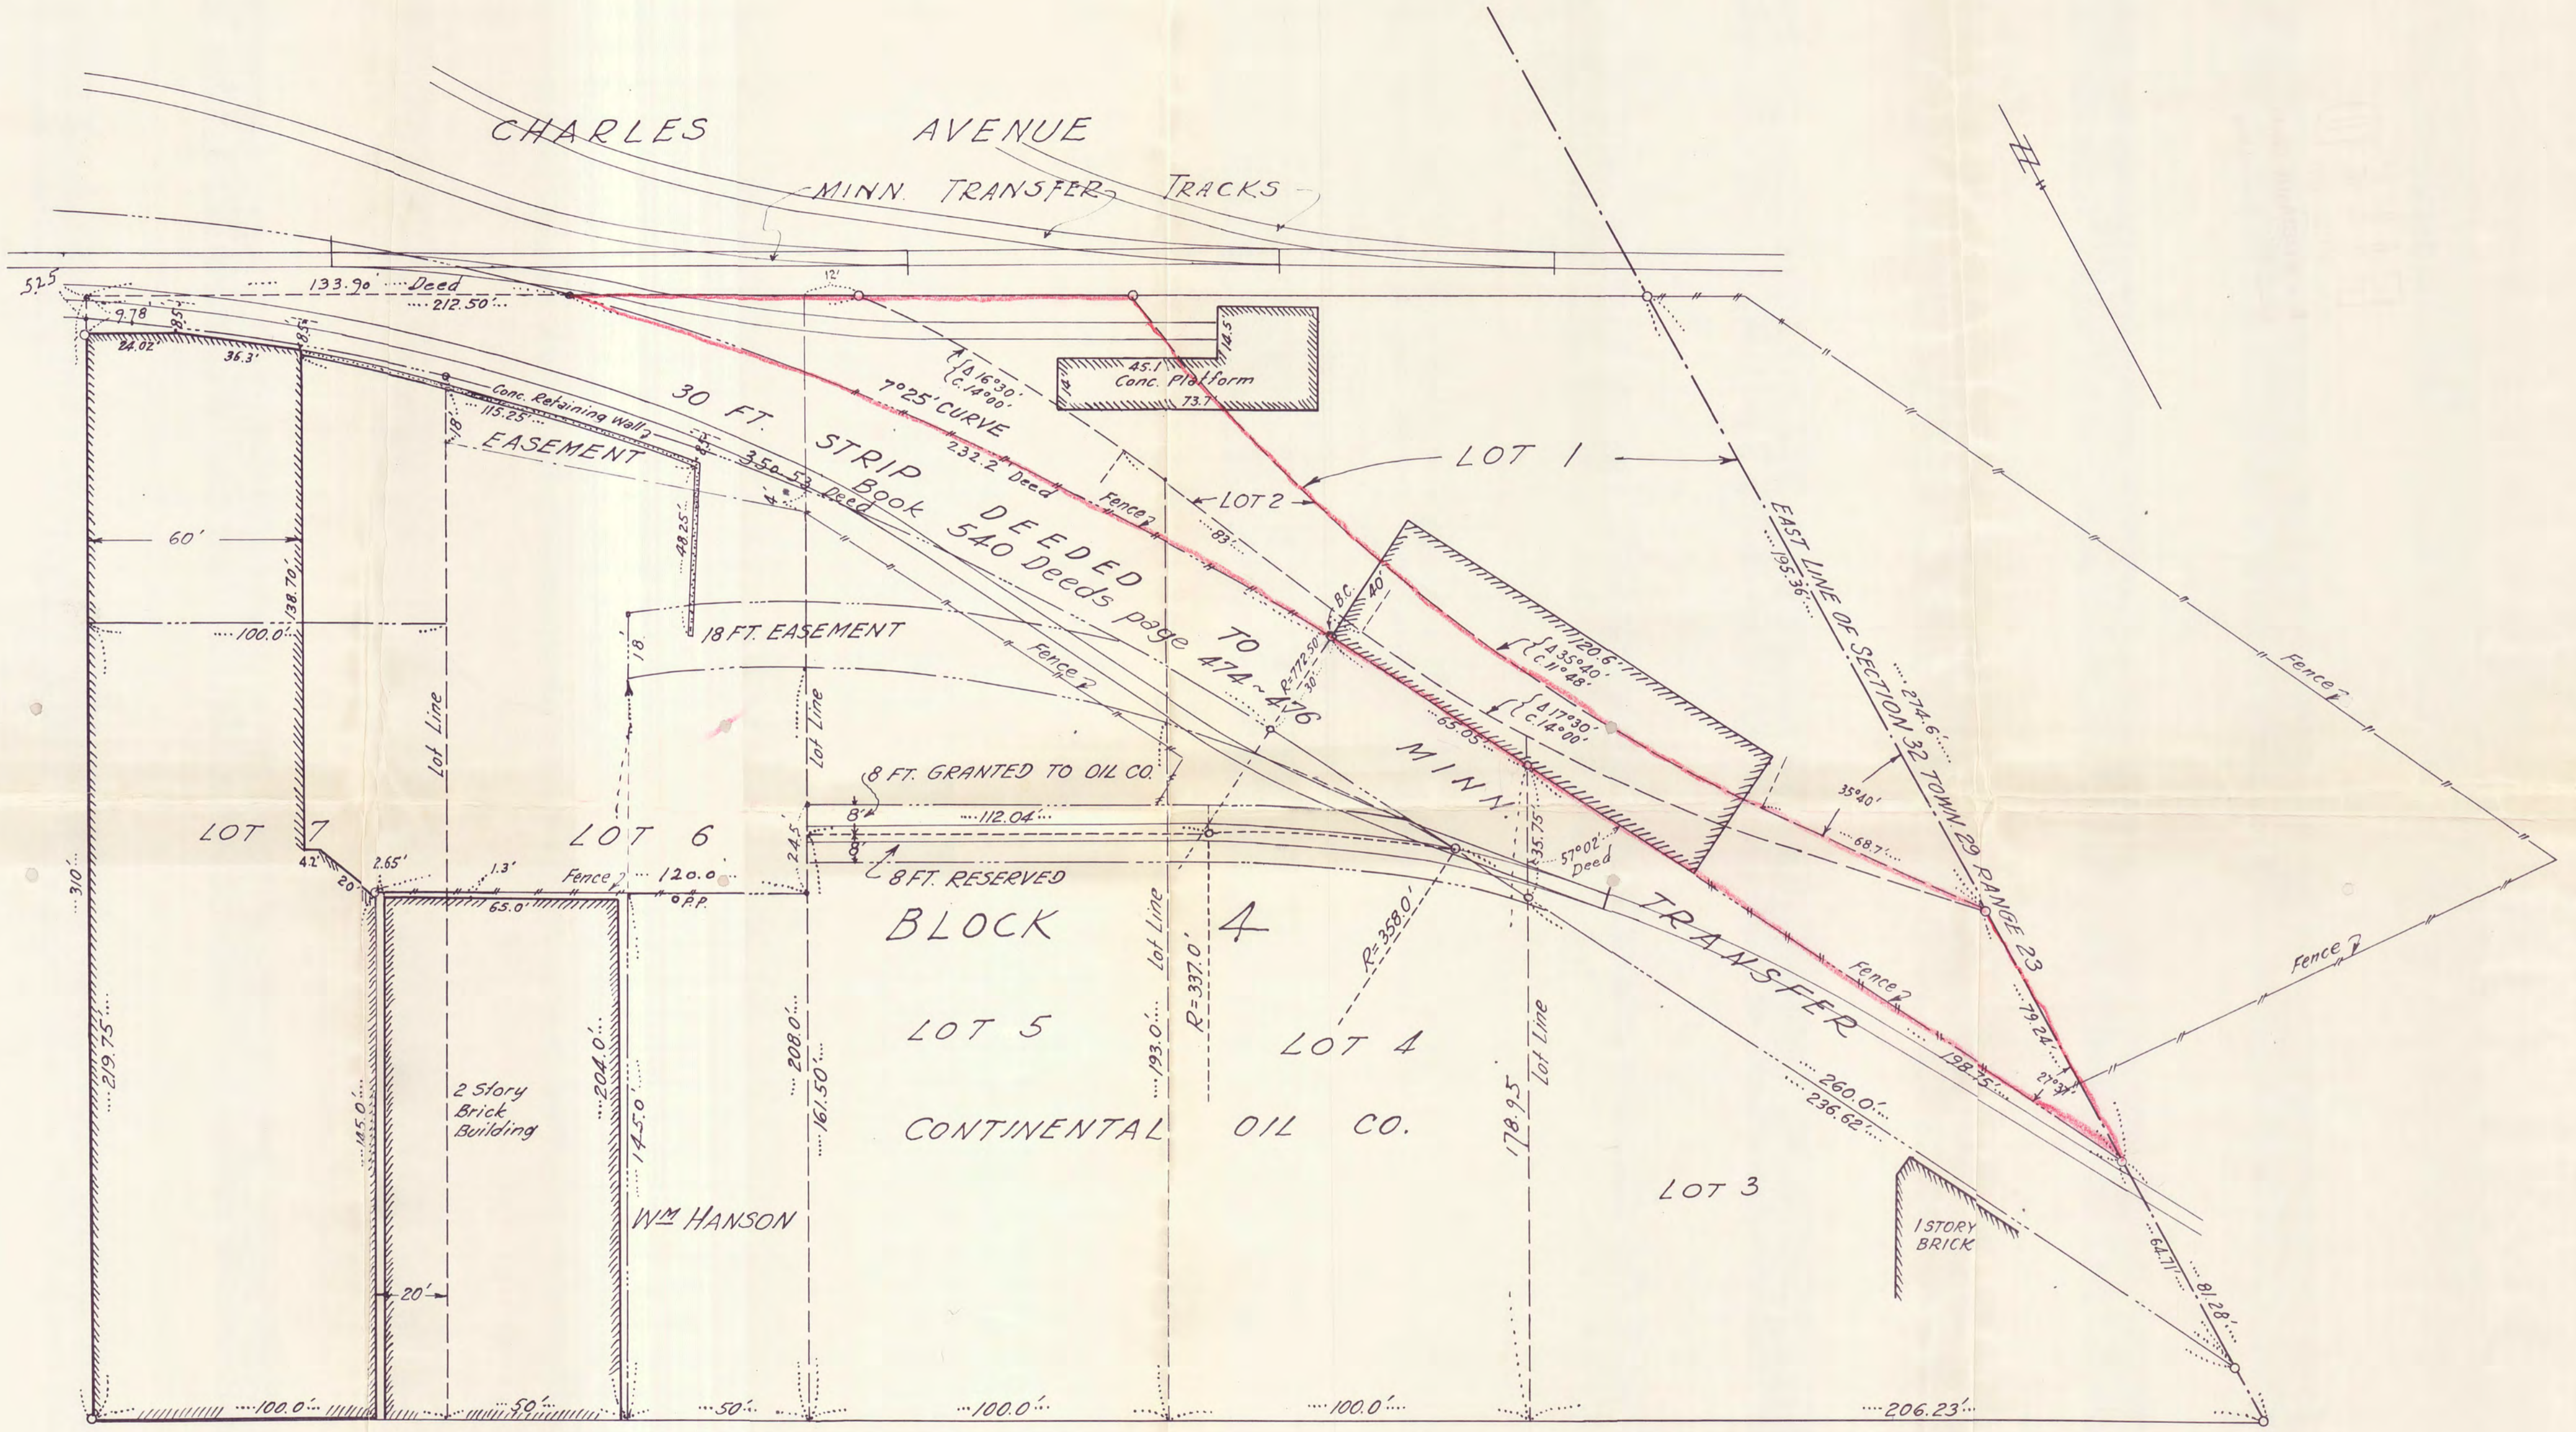

CHARLES AVENUE

MINN. TRANSFER TRACKS

BLOCK 4
CONTINENTAL OIL CO.

UNIVERSITY AVENUE

PLAT OF SURVEY OF LOTS 1 AND 2
AND PART OF LOTS 3-4-5-6 AND 7
BLOCK 4, ROBBINS AND OTHERS
REARRANGEMENT, AS SURVEYED
BY ME IN JUNE, 1957
SCALE 1"=30 FEET.

F. J. Armstrong
F. J. Armstrong, Civil Engineer
Dated June 27th 1957

PROPERTY OF BORCHERT-INGERSOLL INC.

#9404

M-850