


# SURVEY OF

## LOCATION OF SERVICE STATION AT PROSPERITY & JESSAMINE AVES. ST PAUL, MINN.

SCALE 1" = 30'

Tel. To. 0640

T. J. WELCH, REG. SURVEYOR  
738 SURREY AVE  
ST PAUL, MINN.  
10-10-52

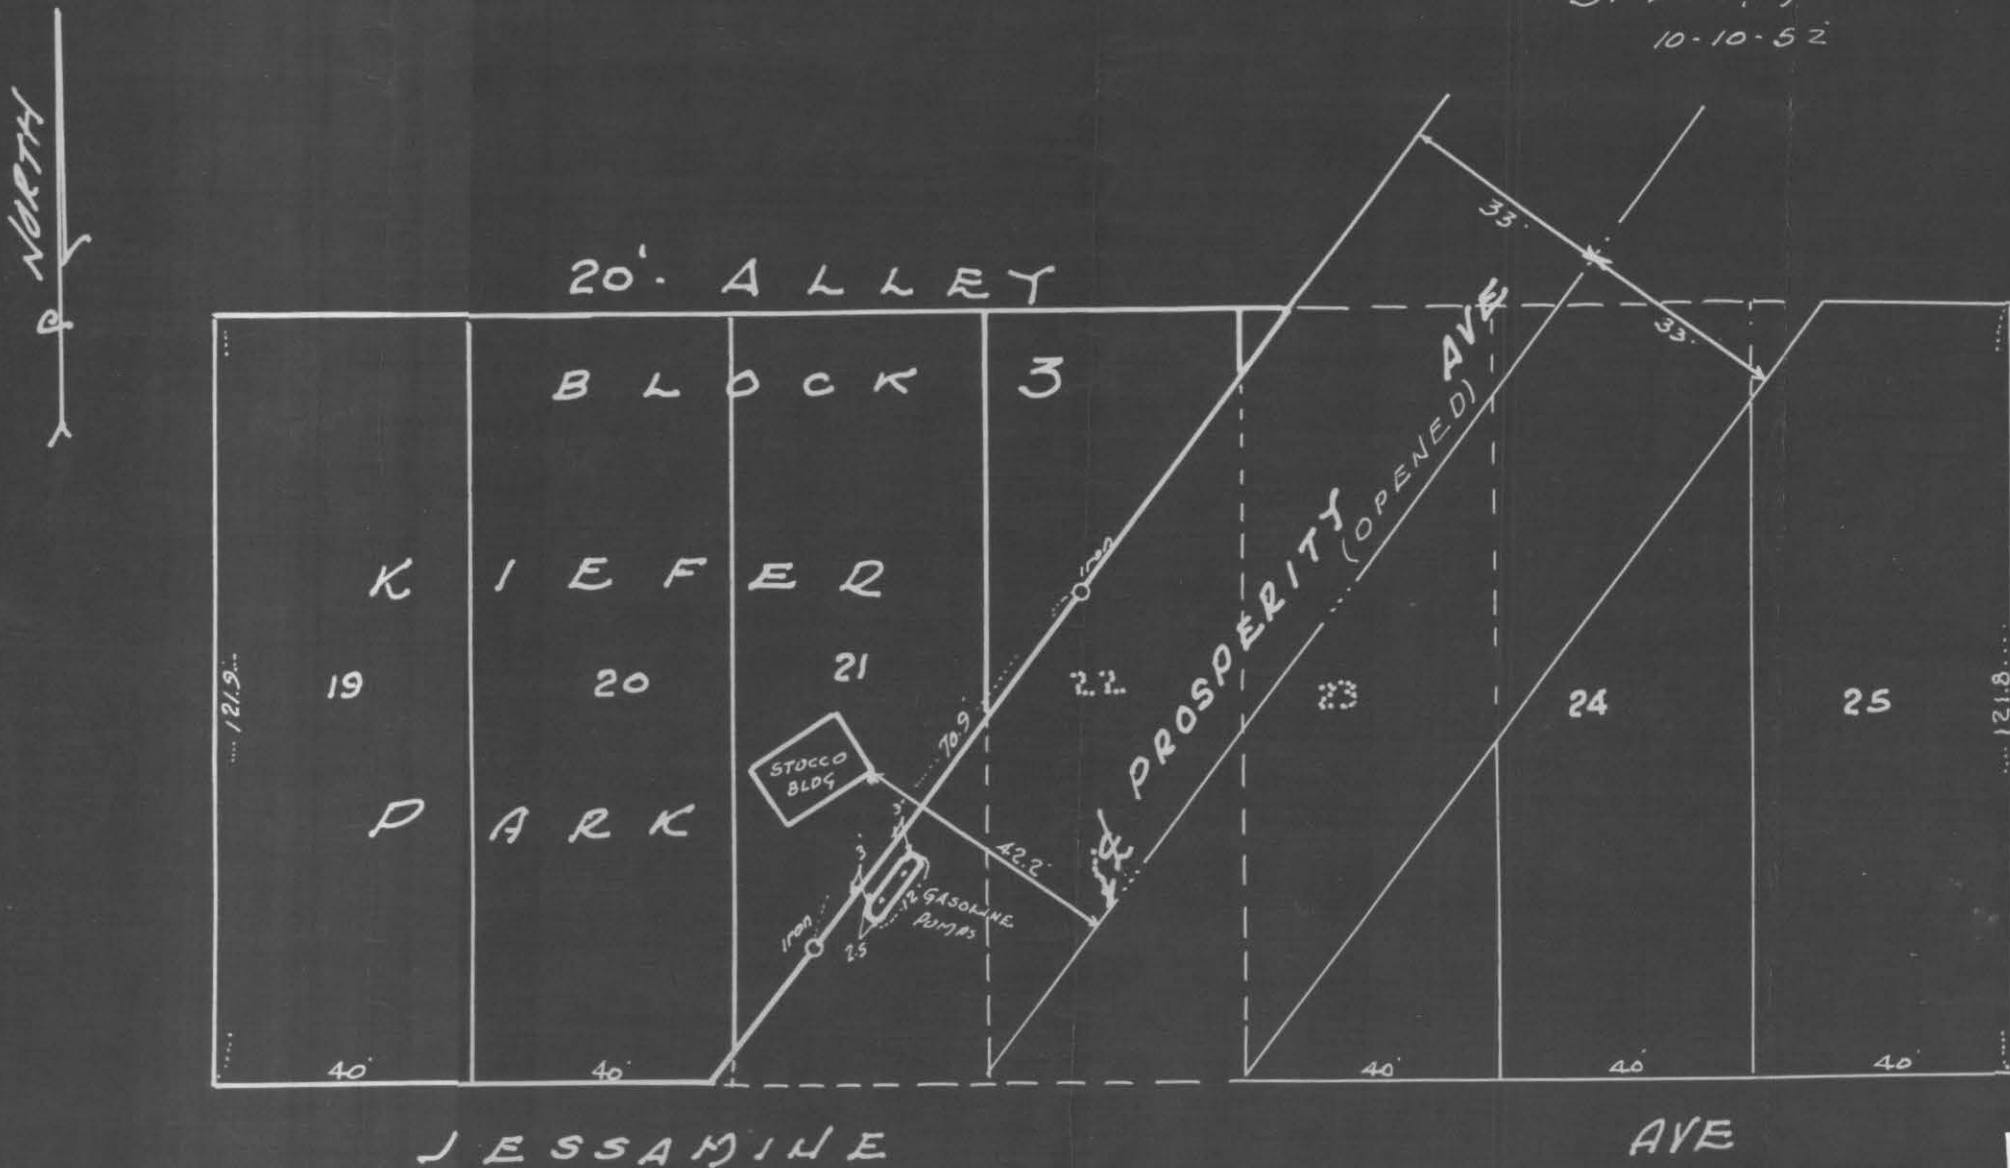

#9535