


Lot 6 - Auditors Sub #80

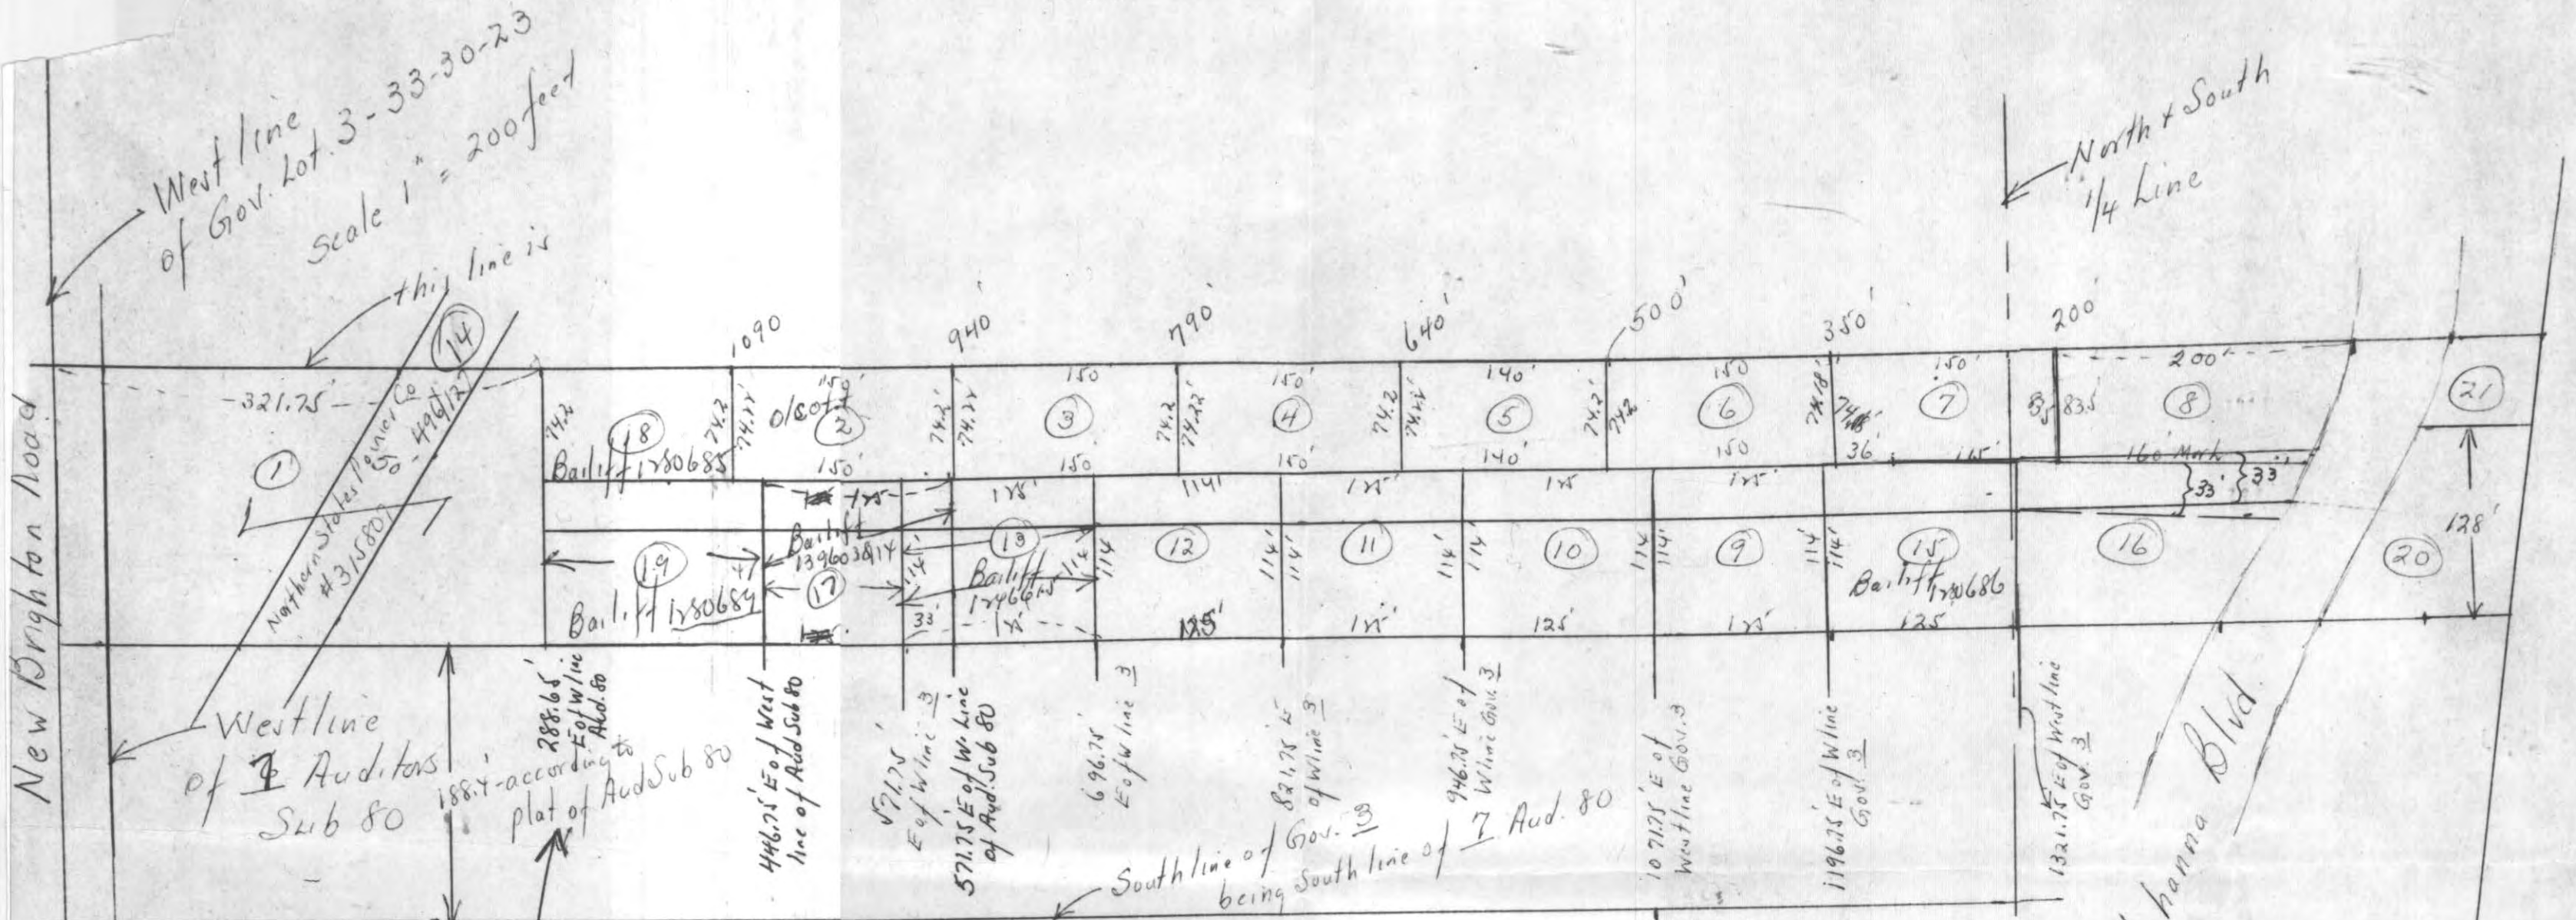

WD-843794
Deed to Hebbe
recites this measurement
as 188.57

#2	3	4	5	6	7	8	9	10	11	12	13	14
1223079x 715x 1231770x 1337892x 893x	1223079x 715x 1231919x 1240790x	1196929x 1199669x 1200705x 1230046x	1234328x 1260876x	1195853x 854x 1206087x 1216225x 1221608x 1249686x 1249687x 688x	1199486x 1223079x 715x 1223535x 536x 1246966x 1226334x 1275456x 1405120x 121x	1189660x 1223079x 715x 1226855x 572x 1246966x 1370140x 722x 1412218x	1183757x 258x 715x 1186753x 1190898x 1191018x 1241522x 1344788x 789x 1345822x 1474289x 290x	1183751x 252x 715x 1186754x 1205660x 1209167x 1209168x 169x 170x 1231682x 1247167x	1202487x 715x 1211086x 894x 1221540x 937x 1312246x	1223079x 715x 1240946x 937x 1266900x 1312246x	1223079x 715x 1246615x 1431995x 1280687x 1396038x	37496 3.9.13.15.17.19 1467483x
1223079x 715x 1280886x 1431995x 1457171x	1223079x 715x 1288838x 1288713x 1388888x 1290421x 1387130x 1430919x	1446613x 890x 144747x 439x 419x 1410062x 1471755x 1474441x 1454695x	1223079x 715x 1280881x 1396038x 1431995x	1223079x 715x 1280881x 1431995x	1223079x 715x 1263839x 1280881x 1387130x 1430919x 1431995x 1450621x	1223079x 715x 1263839x 1280881x 1387130x 1430919x 1431995x 1450621x	1223079x 715x 1263839x 1280881x 1387130x 1430919x 1431995x 1450621x	7.8.16.20.21 1449812x 1410472x 1454169x 171x 1464123x	16.20.21 1455495x 1457516x 1467833x			