


CERTIFICATE of SURVEY

F. J. ARMSTRONG
Civil Engineer and Surveyor
ST. PAUL, MINN.

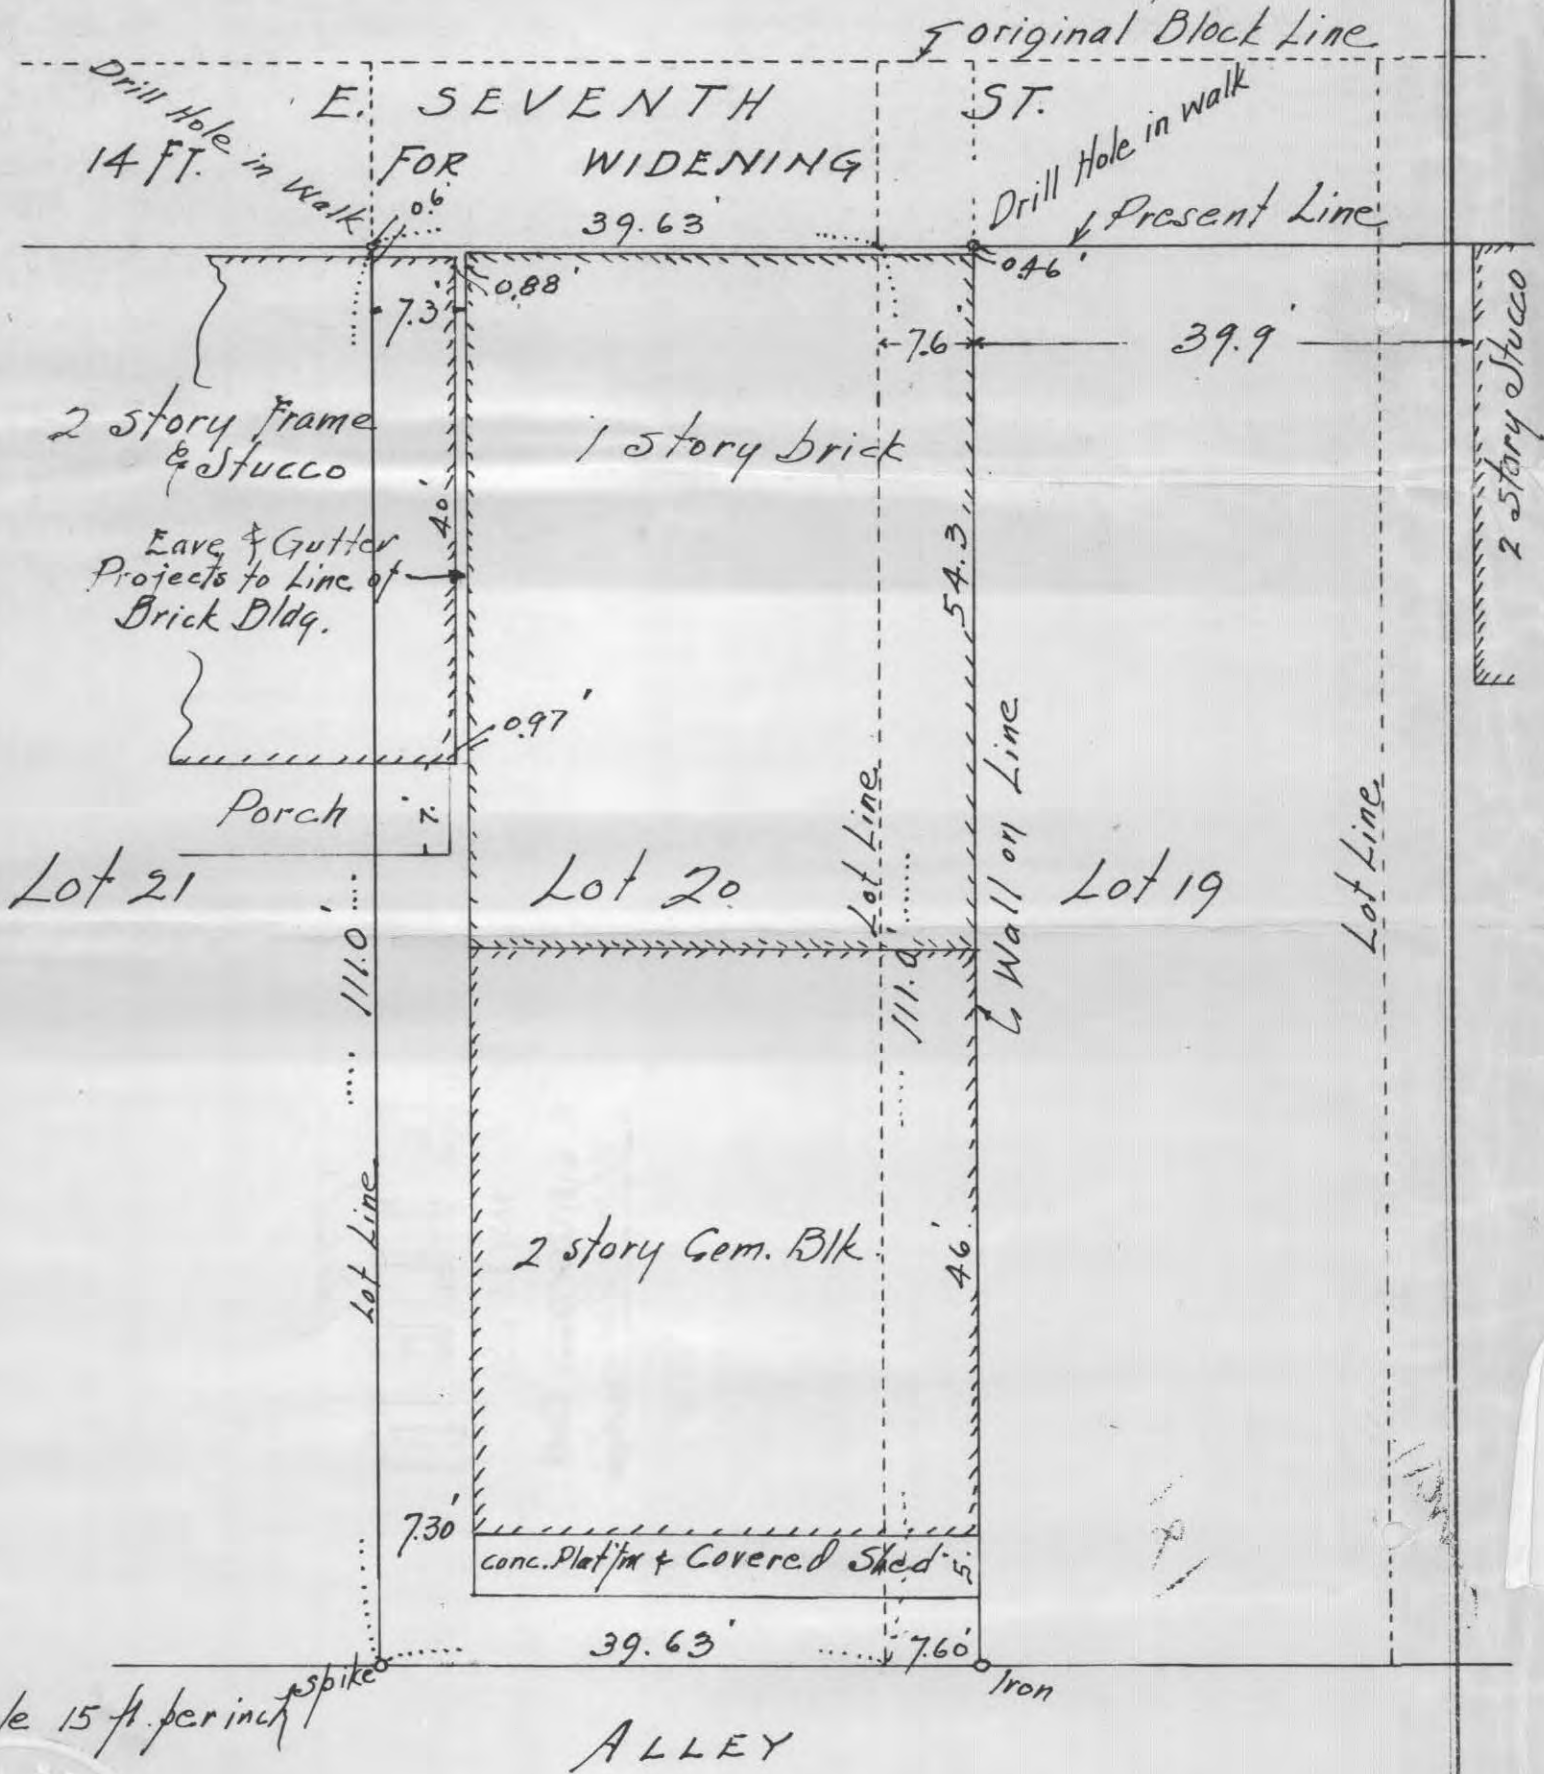

Scale 15 ft. per inch *spikes*

I HEREBY CERTIFY that on the 19th day of March, A. D. 1959

I made a survey of the following described property, to-wit: Lot 20 and the South-Westerly 7.6 feet of Lot 19, Johnstones Subdivision of Block 112 of Lyman Dayton's Addition to St. Paul.

and the above map is a true and correct map of said survey and the improvements shown thereon are correctly indicated

F. J. Armstrong
Civil Engineer

Subscribed and sworn to before me this 1st day of April, 1959

Robert G. Flynn
Notary Public

My Commission Expires June 12, 1962

9781