



CERTIFICATE OF SURVEY FOR: HNTB ST. PAUL DOWNTOWN AIRPORT

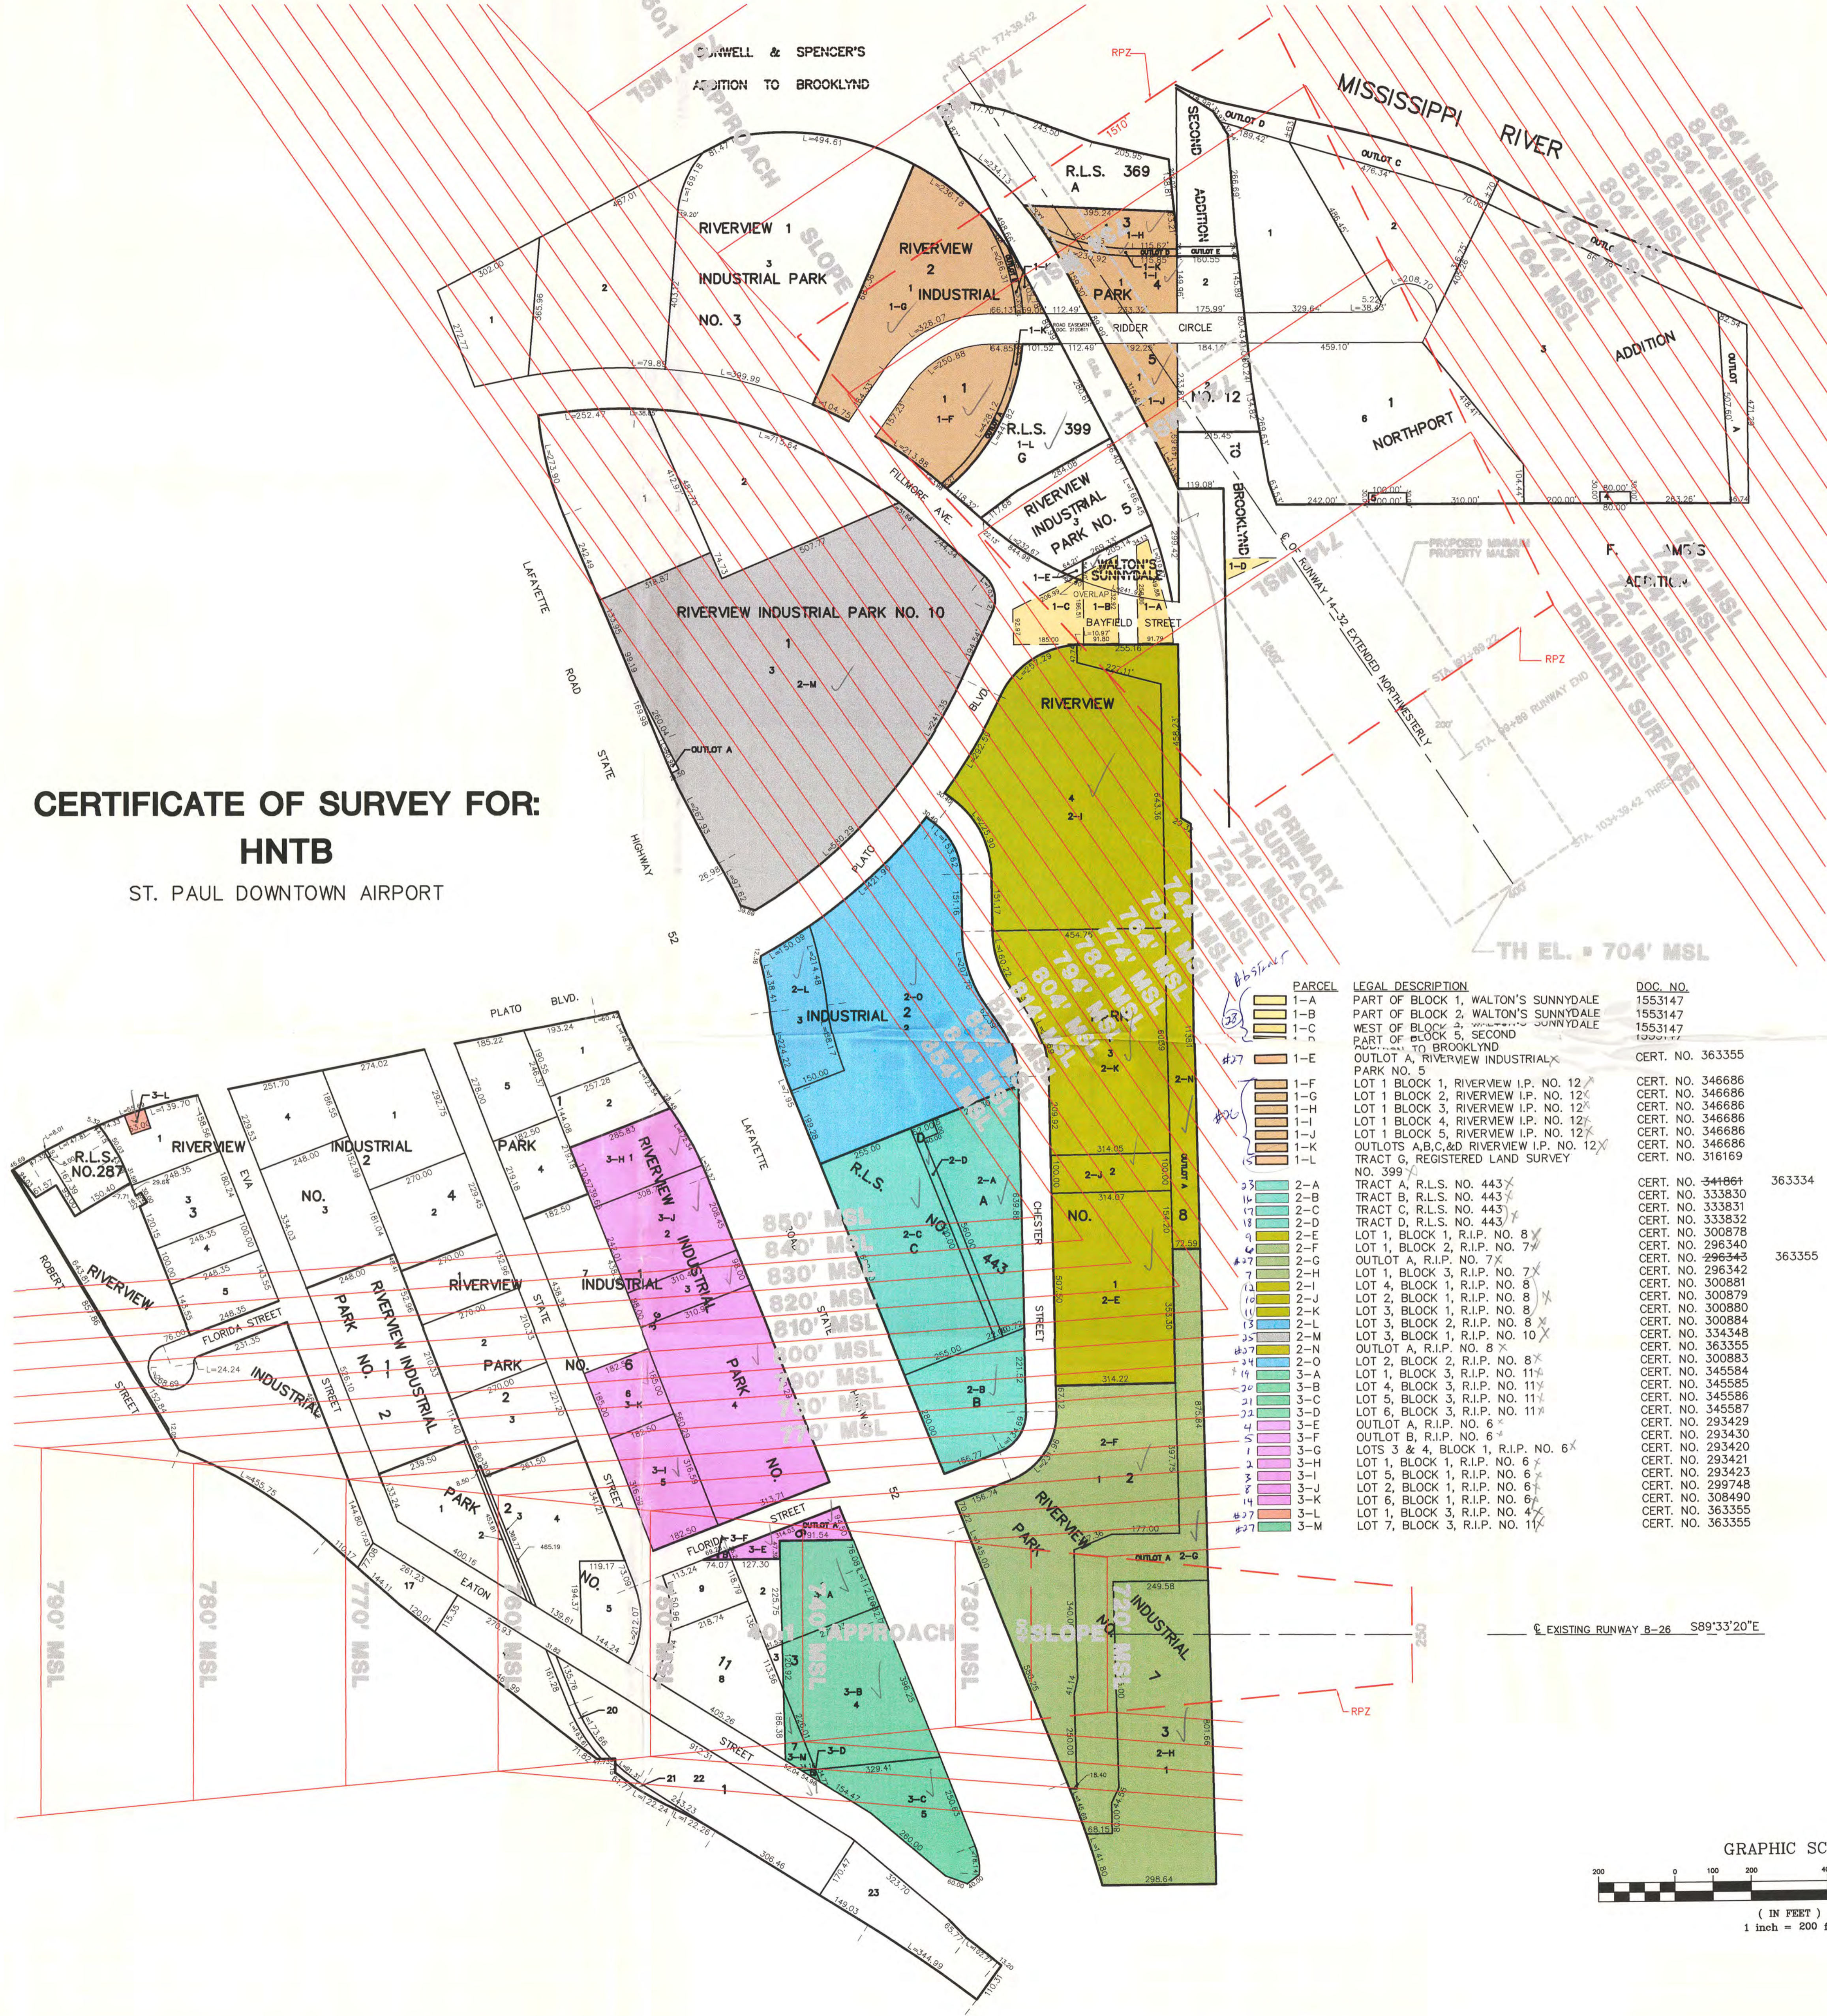

PARCEL	LEGAL DESCRIPTION	DOC. NO.	BOOK	PAGE	LAST REVIEW	OWNER	RESTRICTION DOCUMENT DATED JULY 10, 1961	RESTRICTION DOCUMENT DATED AUGUST 19, 1963
1-A	PART OF BLOCK 1, WALTON'S SUNNYDALE	1553147	1770	241	1991	CITY OF SAINT PAUL		
1-B	PART OF BLOCK 2, WALTON'S SUNNYDALE	1553147	1770	241	1991	CITY OF SAINT PAUL		
1-C	WEST OF BLOCK 3, WALTON'S SUNNYDALE	1553147	1770	241	1991	CITY OF SAINT PAUL		
1-D	PART OF BLOCK 5, SECOND ADDITION TO BROOKLYND	1930117	1770	241	1991	CITY OF SAINT PAUL		
1-E	OUTLOT A, RIVERVIEW INDUSTRIAL PARK NO. 5	CERT. NO. 363355	773	355	1993	CITY OF SAINT PAUL		

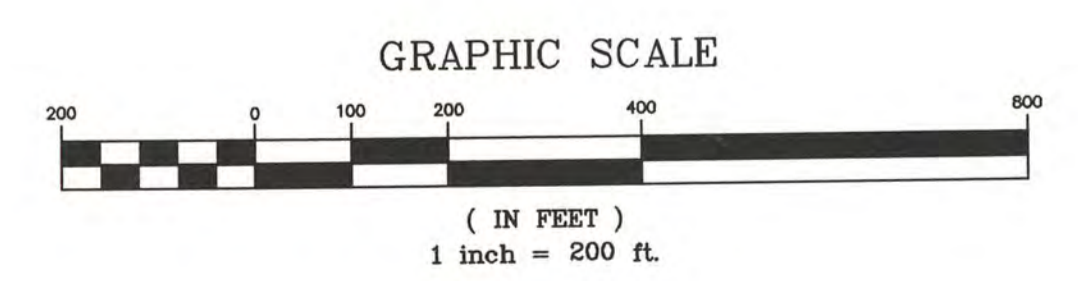

LEGEND
 --- DESCRIBED EASEMENT
 R.I.P. DENOTES RIVERVIEW INDUSTRIAL PARK

DESCRIPTION
 (AS PROVIDED BY THE CLIENT)

NOTE
 AREA SHOWN IS SECTION 5, T.28, R.22
 RAMSEY COUNTY, MN

CERTIFICATION
 I HEREBY CERTIFY THAT THIS SURVEY, PLAN OR REPORT WAS PREPARED BY ME OR UNDER MY DIRECT SUPERVISION AND THAT I AM A DULY REGISTERED LAND SURVEYOR UNDER THE LAWS OF THE STATE OF MINNESOTA.
 Barton G. Ahrens DATED: 01/27/98
 BARTON G. AHRENS
 MN REG. NO. 19162

