BOUNDARY SURVEY

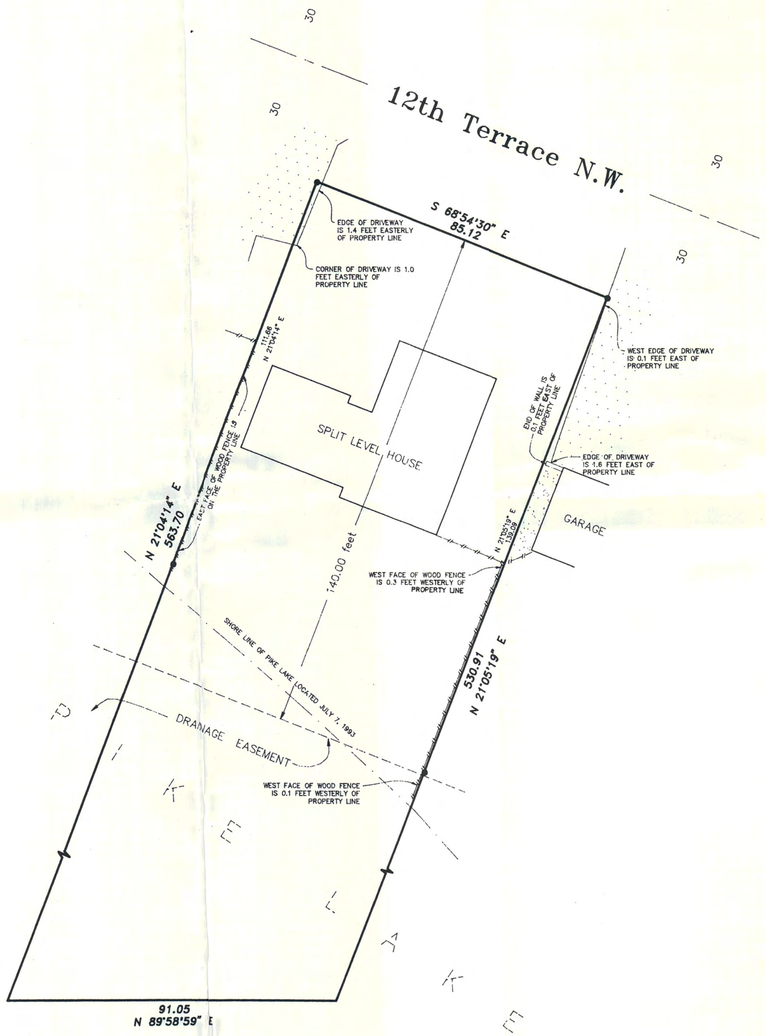

LEGAL DESCRIPTION
PROVIDED

Lot 2, Block 2, PIKE LAKE CHANNEL ADD., according to the recorded plat thereof on file in the office of the County Recorder, Ramsey County, Minnesota.

NORTH

20 0 20 40 60 Feet

WOOD FENCE
SET IRON PIPE, MARKED NO. 16099

GRAVEL
BITUMINOUS PAVEMENT

PAUL R. McLAGAN & SON
MINNESOTA REGISTERED LAND SURVEYORS
940 South Robert Street West St. Paul. Minn. 55118
(612) 457-3645
Fax (612) 457-8642

BOUNDARY SURVEY

For **John Haley**

Sheet # of #

Date **July 7, 1993**

Job No. [illegible]

I Hereby Certify that this survey, plan or report was prepared by me under my direct supervision and that I am a duly Registered Land Surveyor under the laws of the State of Minnesota.

PAUL J. McGINLEY, R.L.S. MINN. REGISTRATION NO. 16099

Revisions

MINNESOTA BLUEPRINT 937-264