


NE 1/4 SEC. 7, T.28 R.22

06-28-22 05-28-22
08-28-22

09-43-11901

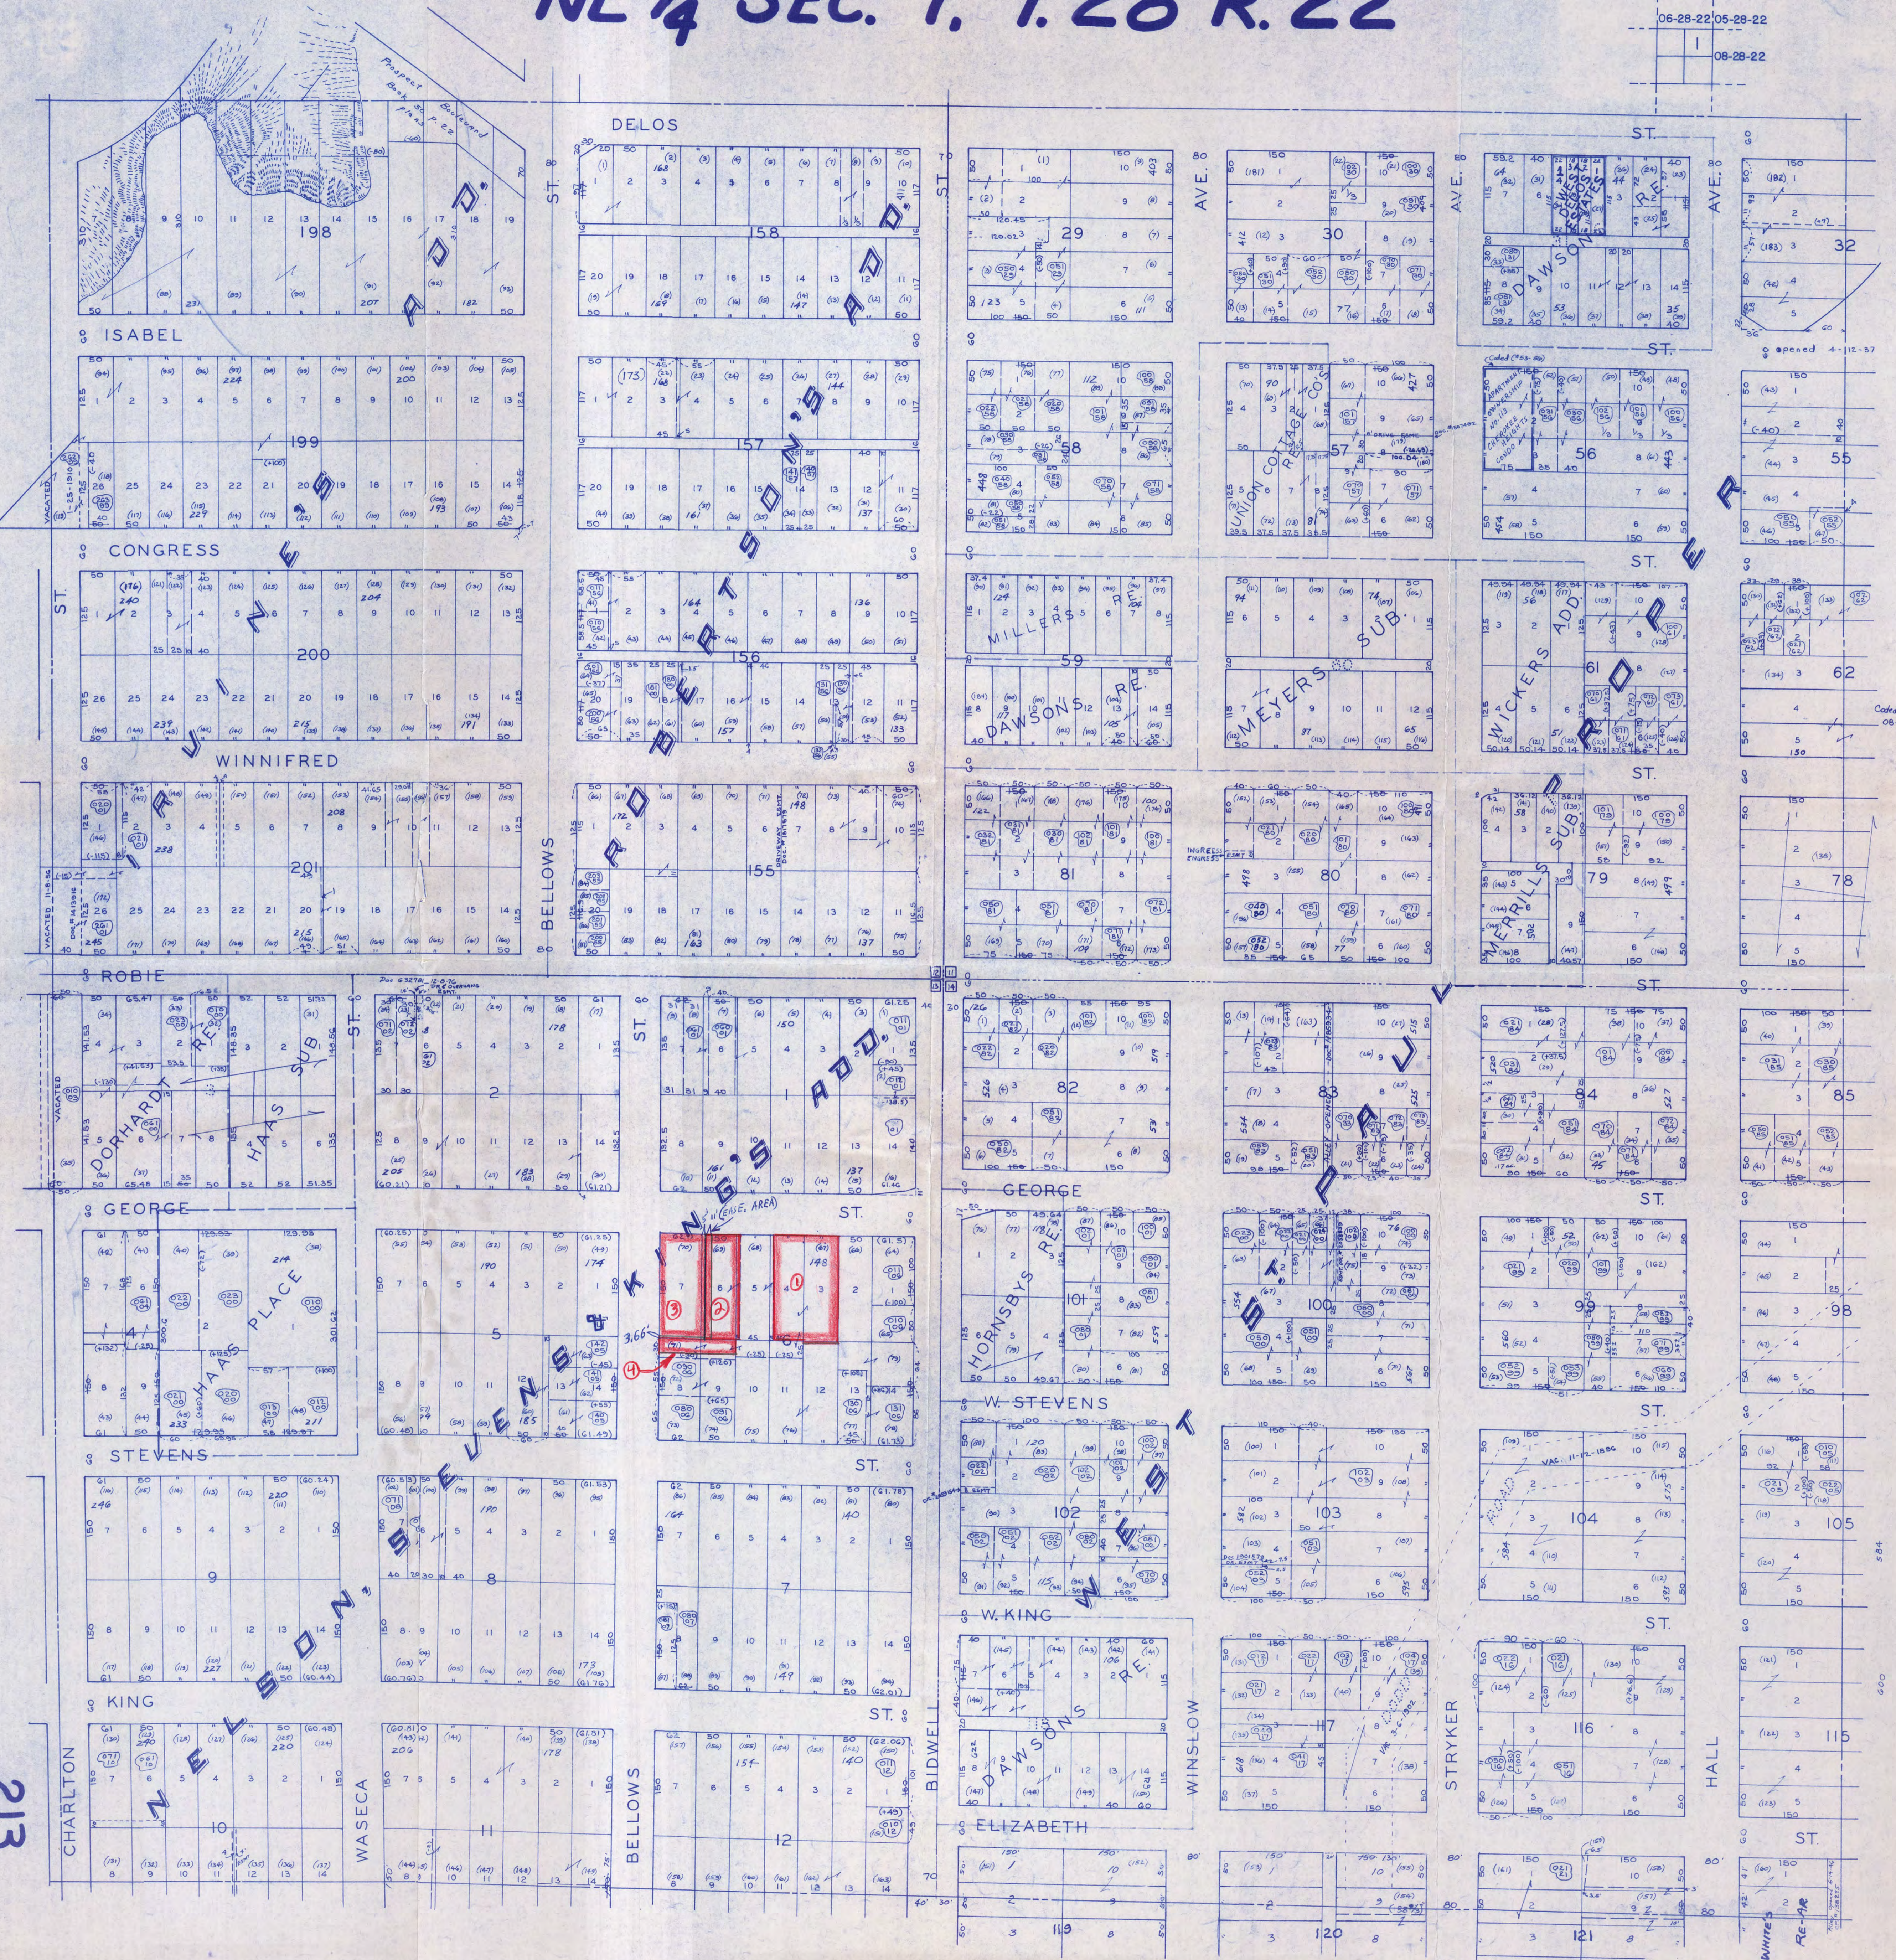

213

584

600

600