

DONALD H. CAMPBELL

Land Surveyor

Registered under Laws of the State of Minnesota

1315 FROST AVENUE — ST. PAUL 9, MINN.


Phone: SPring 7-6565

SURVEYOR'S CERTIFICATE

I hereby certify that the Apartment Building, as shown hereon, and under Construction at #200 South Mississippi River Boulevard was located by me this 7th day of January 1963 A.D.

Signed *Donald H. Campbell*
Minnesota Registration No. 5712

EAST MISSISSIPPI RIVER BLVD

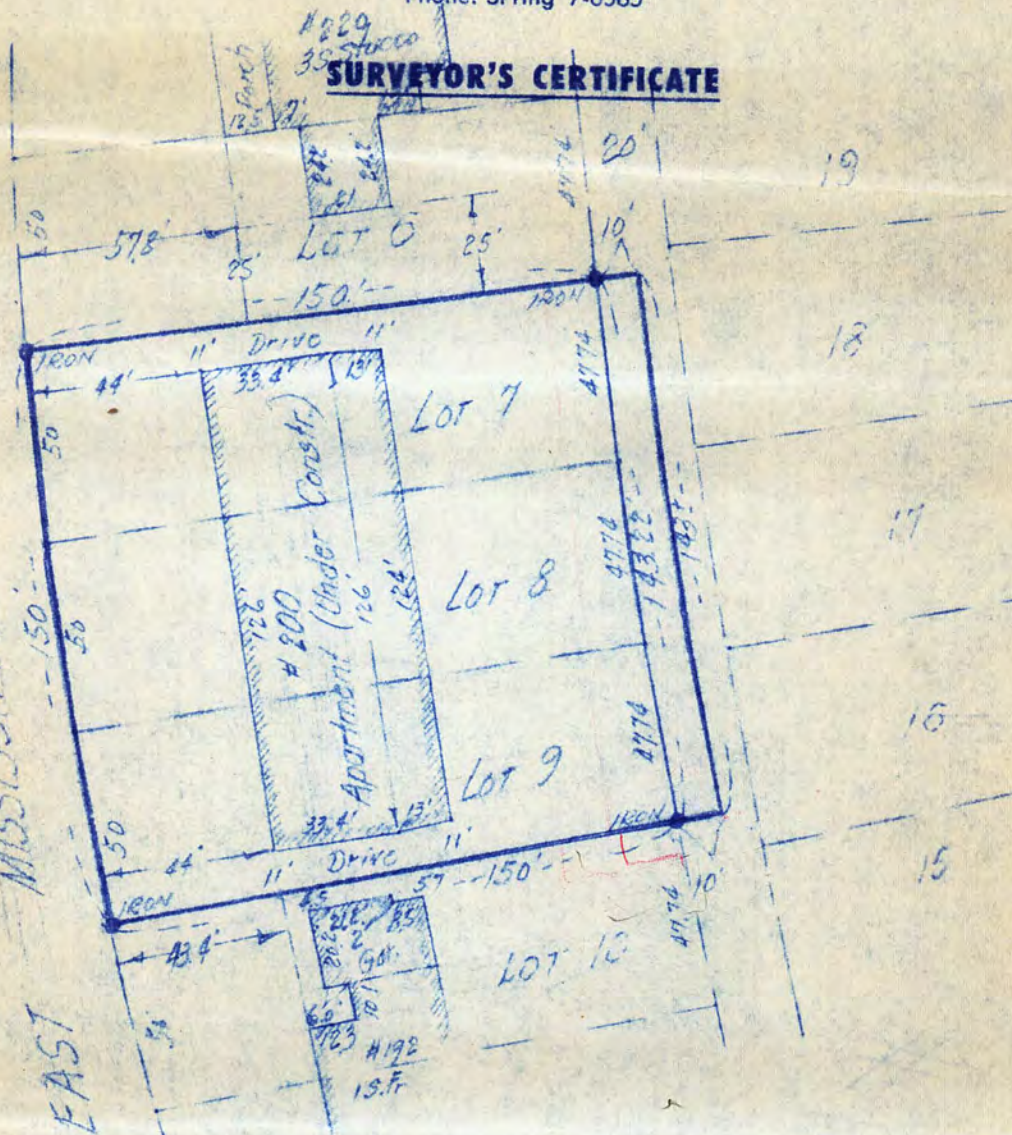

Scale: 1"=50'

I hereby certify that this is a true and correct representation of a survey of the boundaries of:

Lots 7, 8 and 9, Block 46, Desnoyer Park, City of St. Paul, Ramsey County, Minnesota together with the Westerly one-half of the alley accrued to said Lots by reason of the vacation of the alley; and of the location of all buildings, if any, thereon, and all visible encroachments, if any, from or on said land.

As surveyed by me this 23rd day of May 1962 A.D.

Survey for:
Andrews Allen
NW-5-28-23
Ramsey County

Signed: *Donald H. Campbell*
Minnesota Registration No. 5712