

SCALE: 1 INCH 20 FEET

THE JOHN J. RYAN CO.
1595 SELBY AVENUE, ST. PAUL 55104


TELEPHONE: 646-6858

PLAT OF SURVEY

OF PROPERTY OF Baillon Company

LOCATION 119-121 West 6th St. & 52, 54 and 56, W. 7th St, St. Paul

DESCRIBED AS FOLLOWS See attached for legal description.

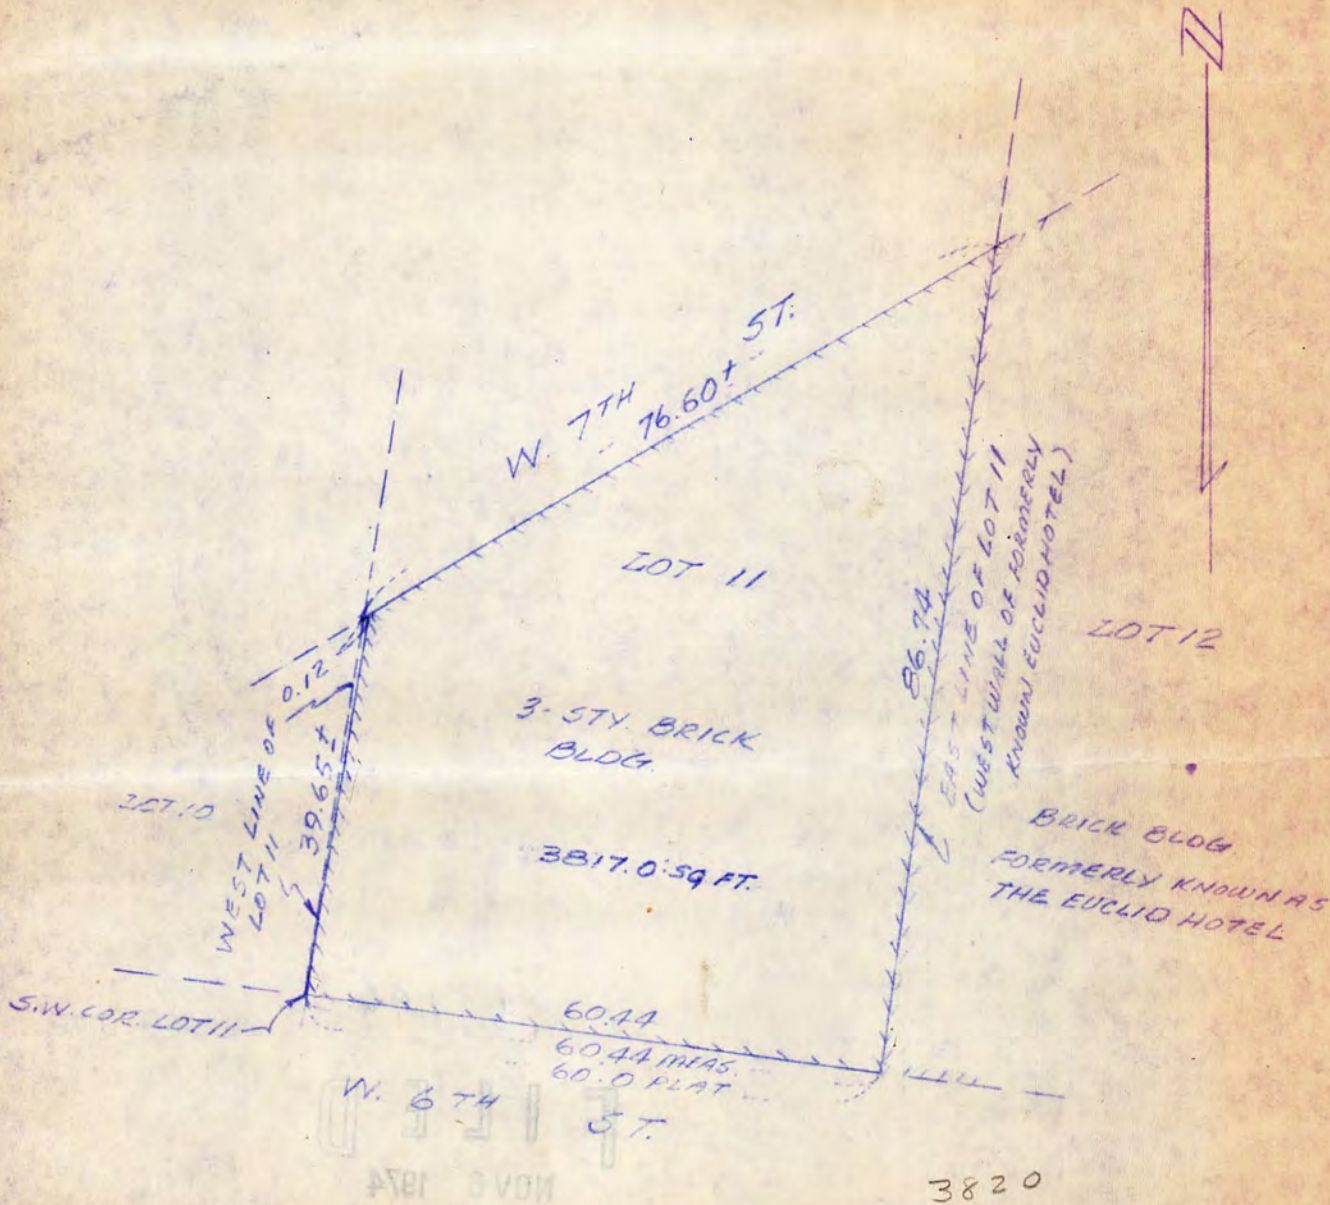

CERTIFICATE OF LOCATION OF BUILDING

I hereby certify that on 3-21 19 74
this survey, plan, or report was prepared by me or under
my direct supervision and that I am a duly Registered Land
Surveyor under the laws of the State of Minnesota.

Paul J. Ryan

JOHN J. RYAN, REGISTERED SURVEYOR, No. 4489
PAUL J. CRANE, REGISTERED SURVEYOR, No. 4449

CERTIFICATE OF SURVEY

I hereby certify that on _____ 19 ____
this survey, plan, or report was prepared by me or under
my direct supervision and that I am a duly Registered Land
Surveyor under the laws of the State of Minnesota.