



ST. PETER

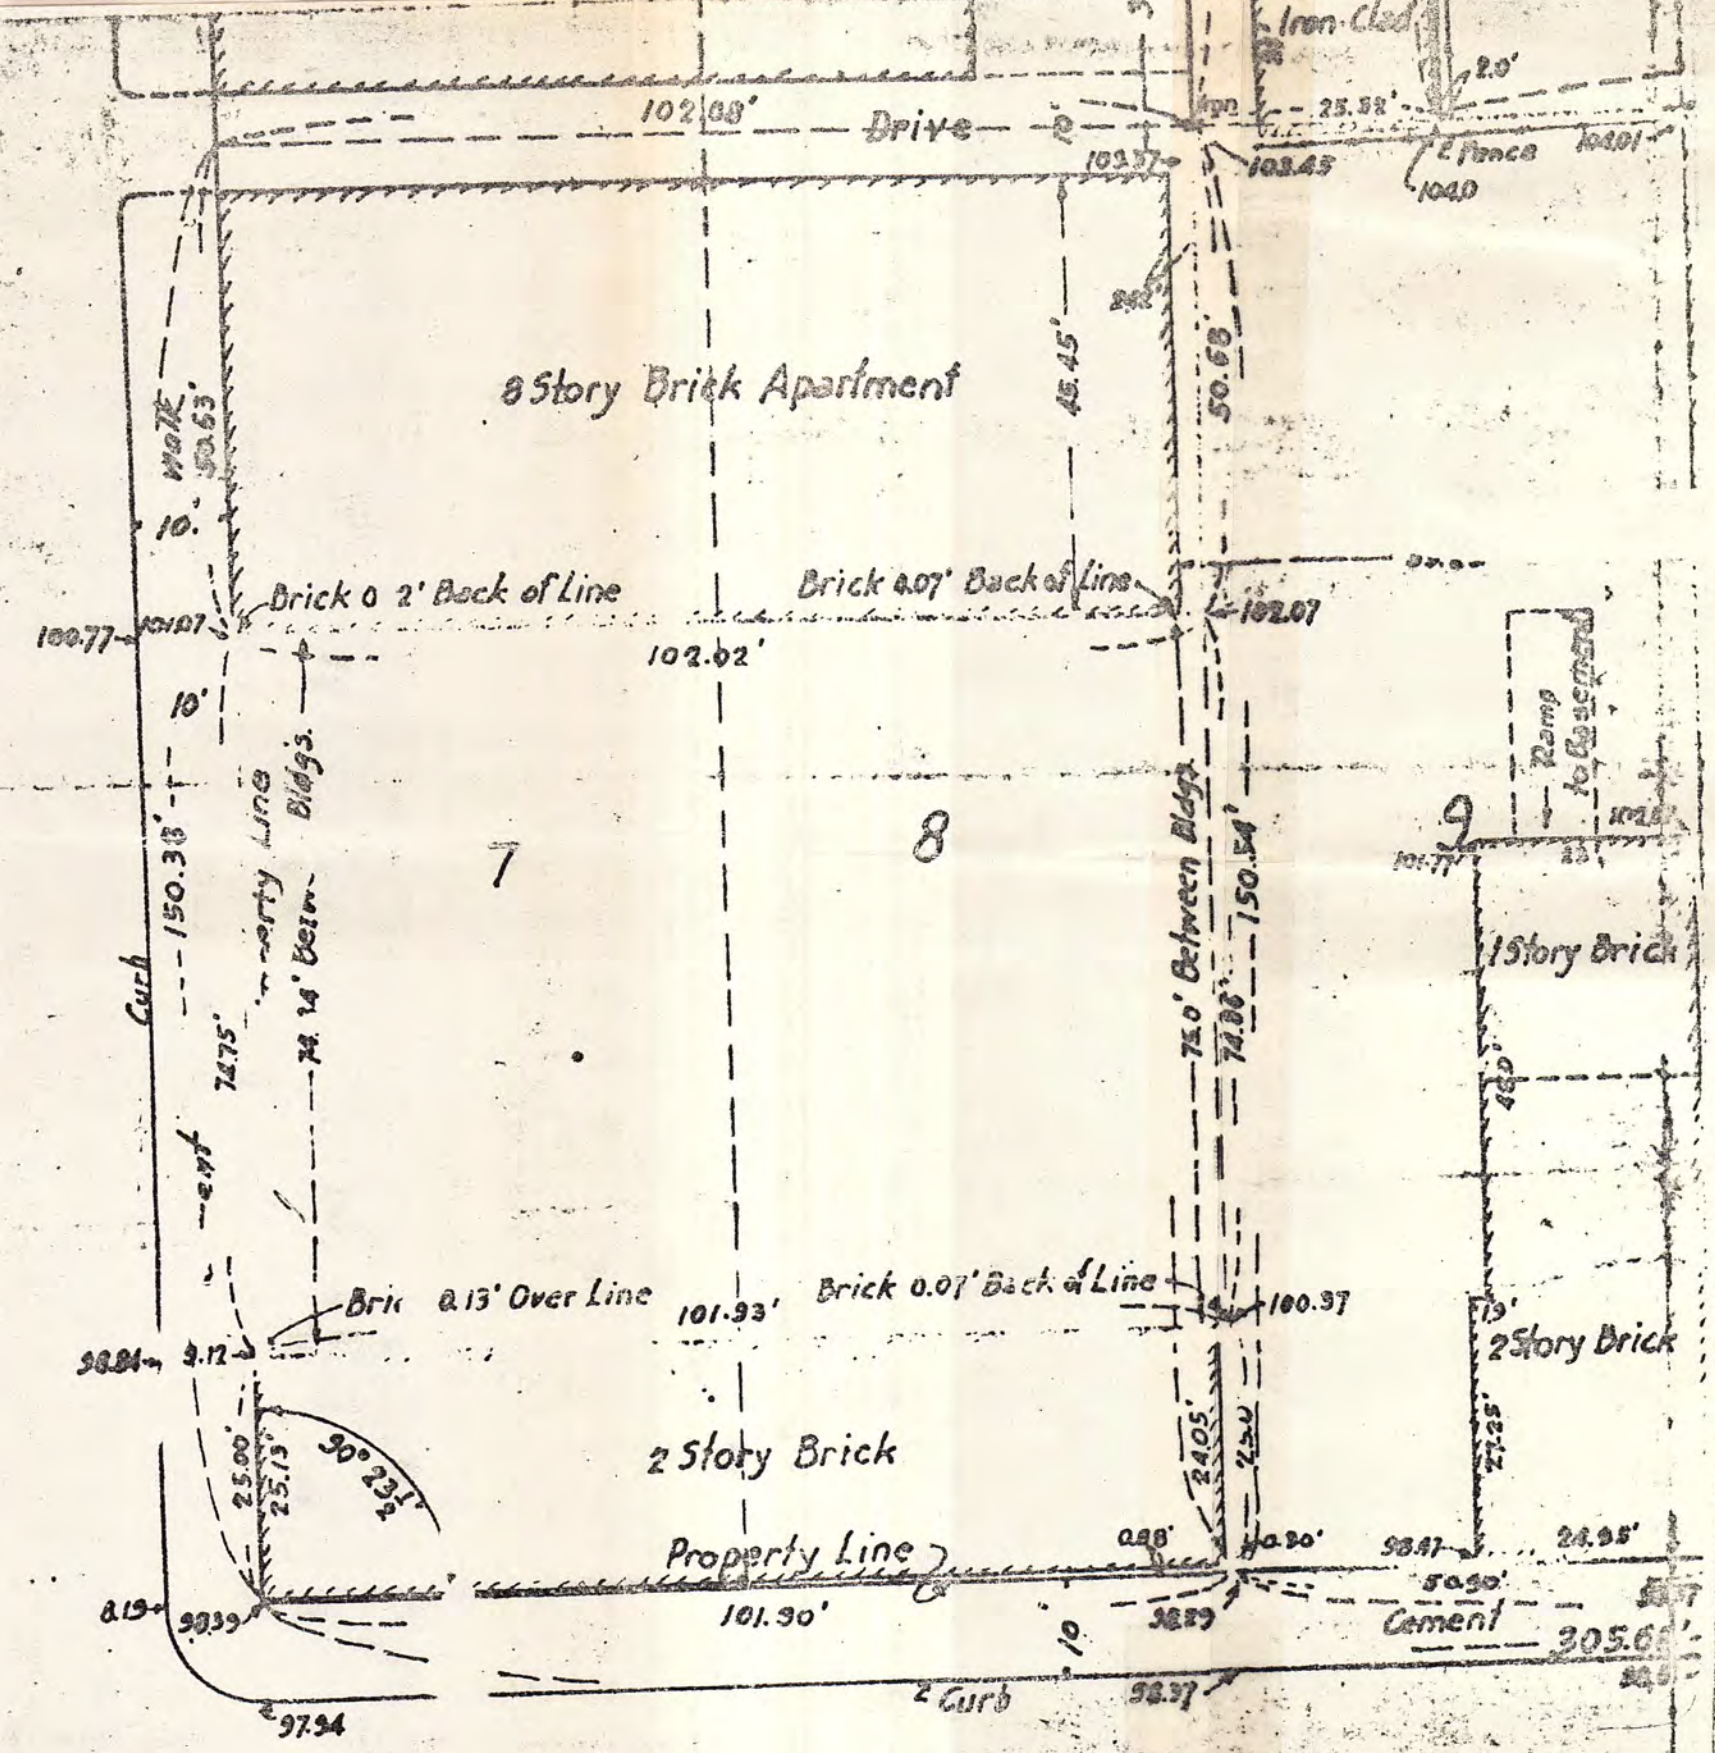

EXCHANGE

EXHIBIT "A"

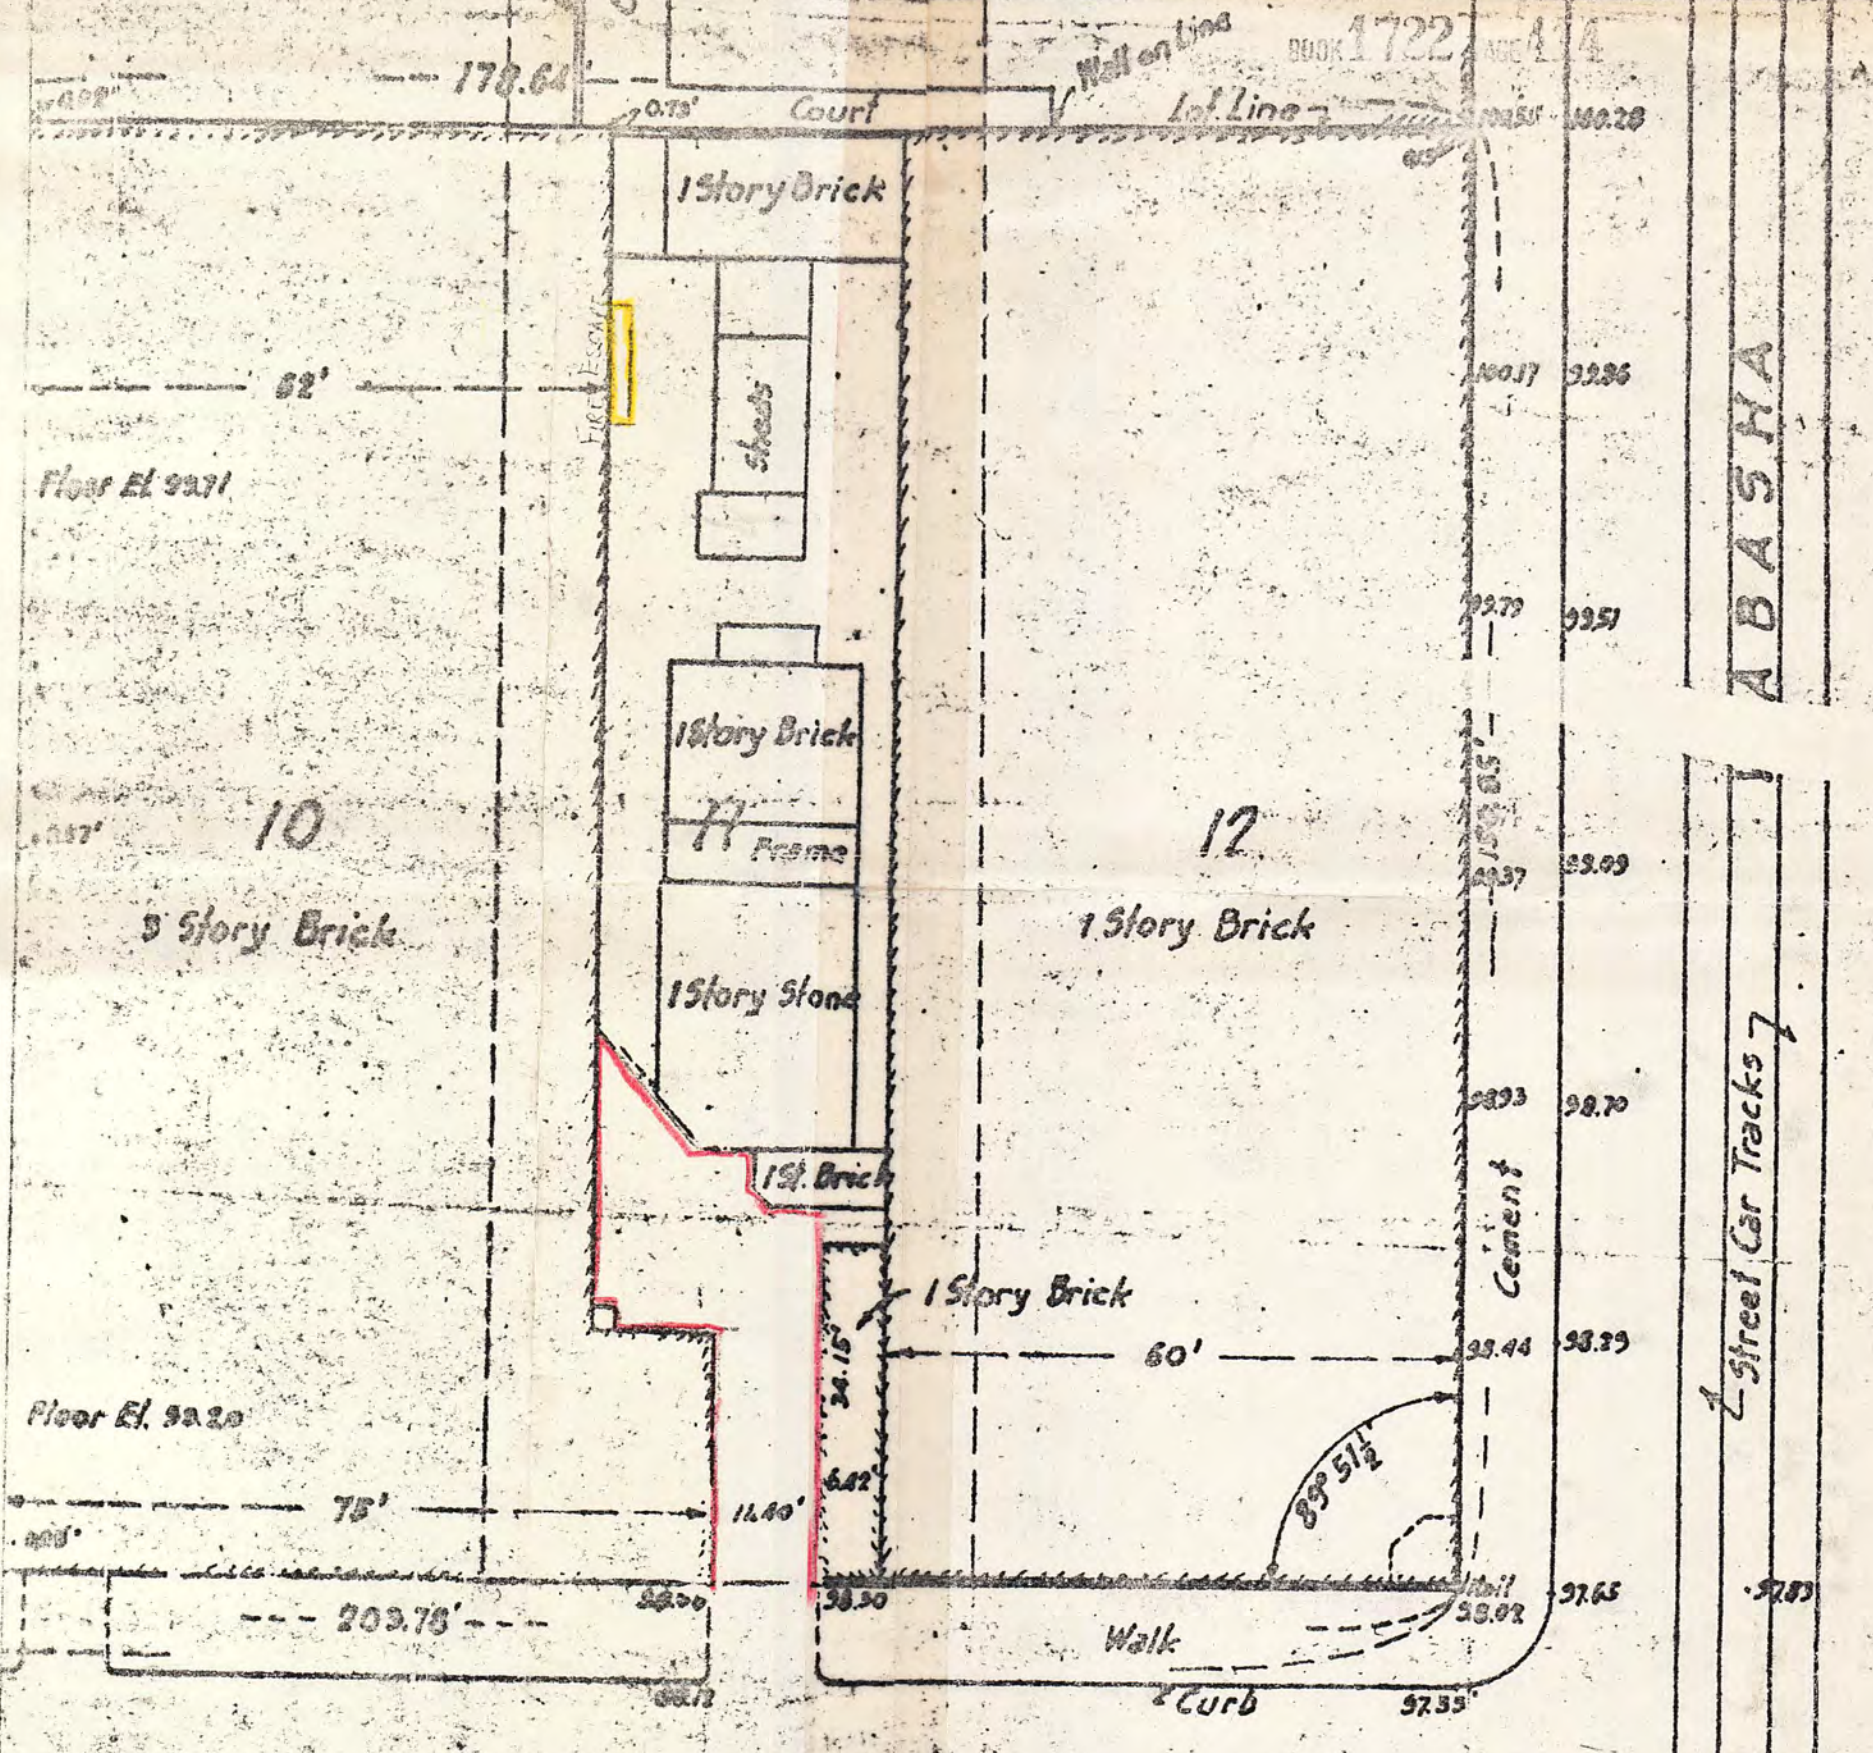

ST.

ABASHA

2 Street Car Tracks

PLAT OF SURVEY OF BLOCK 5
 BAZILLE GUERIN'S ADDN
 ST. PAUL, MINN.

Sept. 19th 1945
 F. J. [Name] Civil Engr.