


HOUSING & REDEVELOPMENT AUTHORITY OF THE CITY OF ST. PAUL

LAKE & LAND SURVEYING COMPANY

WARREN I. FORSBERG, Registered Land Surveyor

2141 E. 5th Street
St. Paul, Minn.
55119

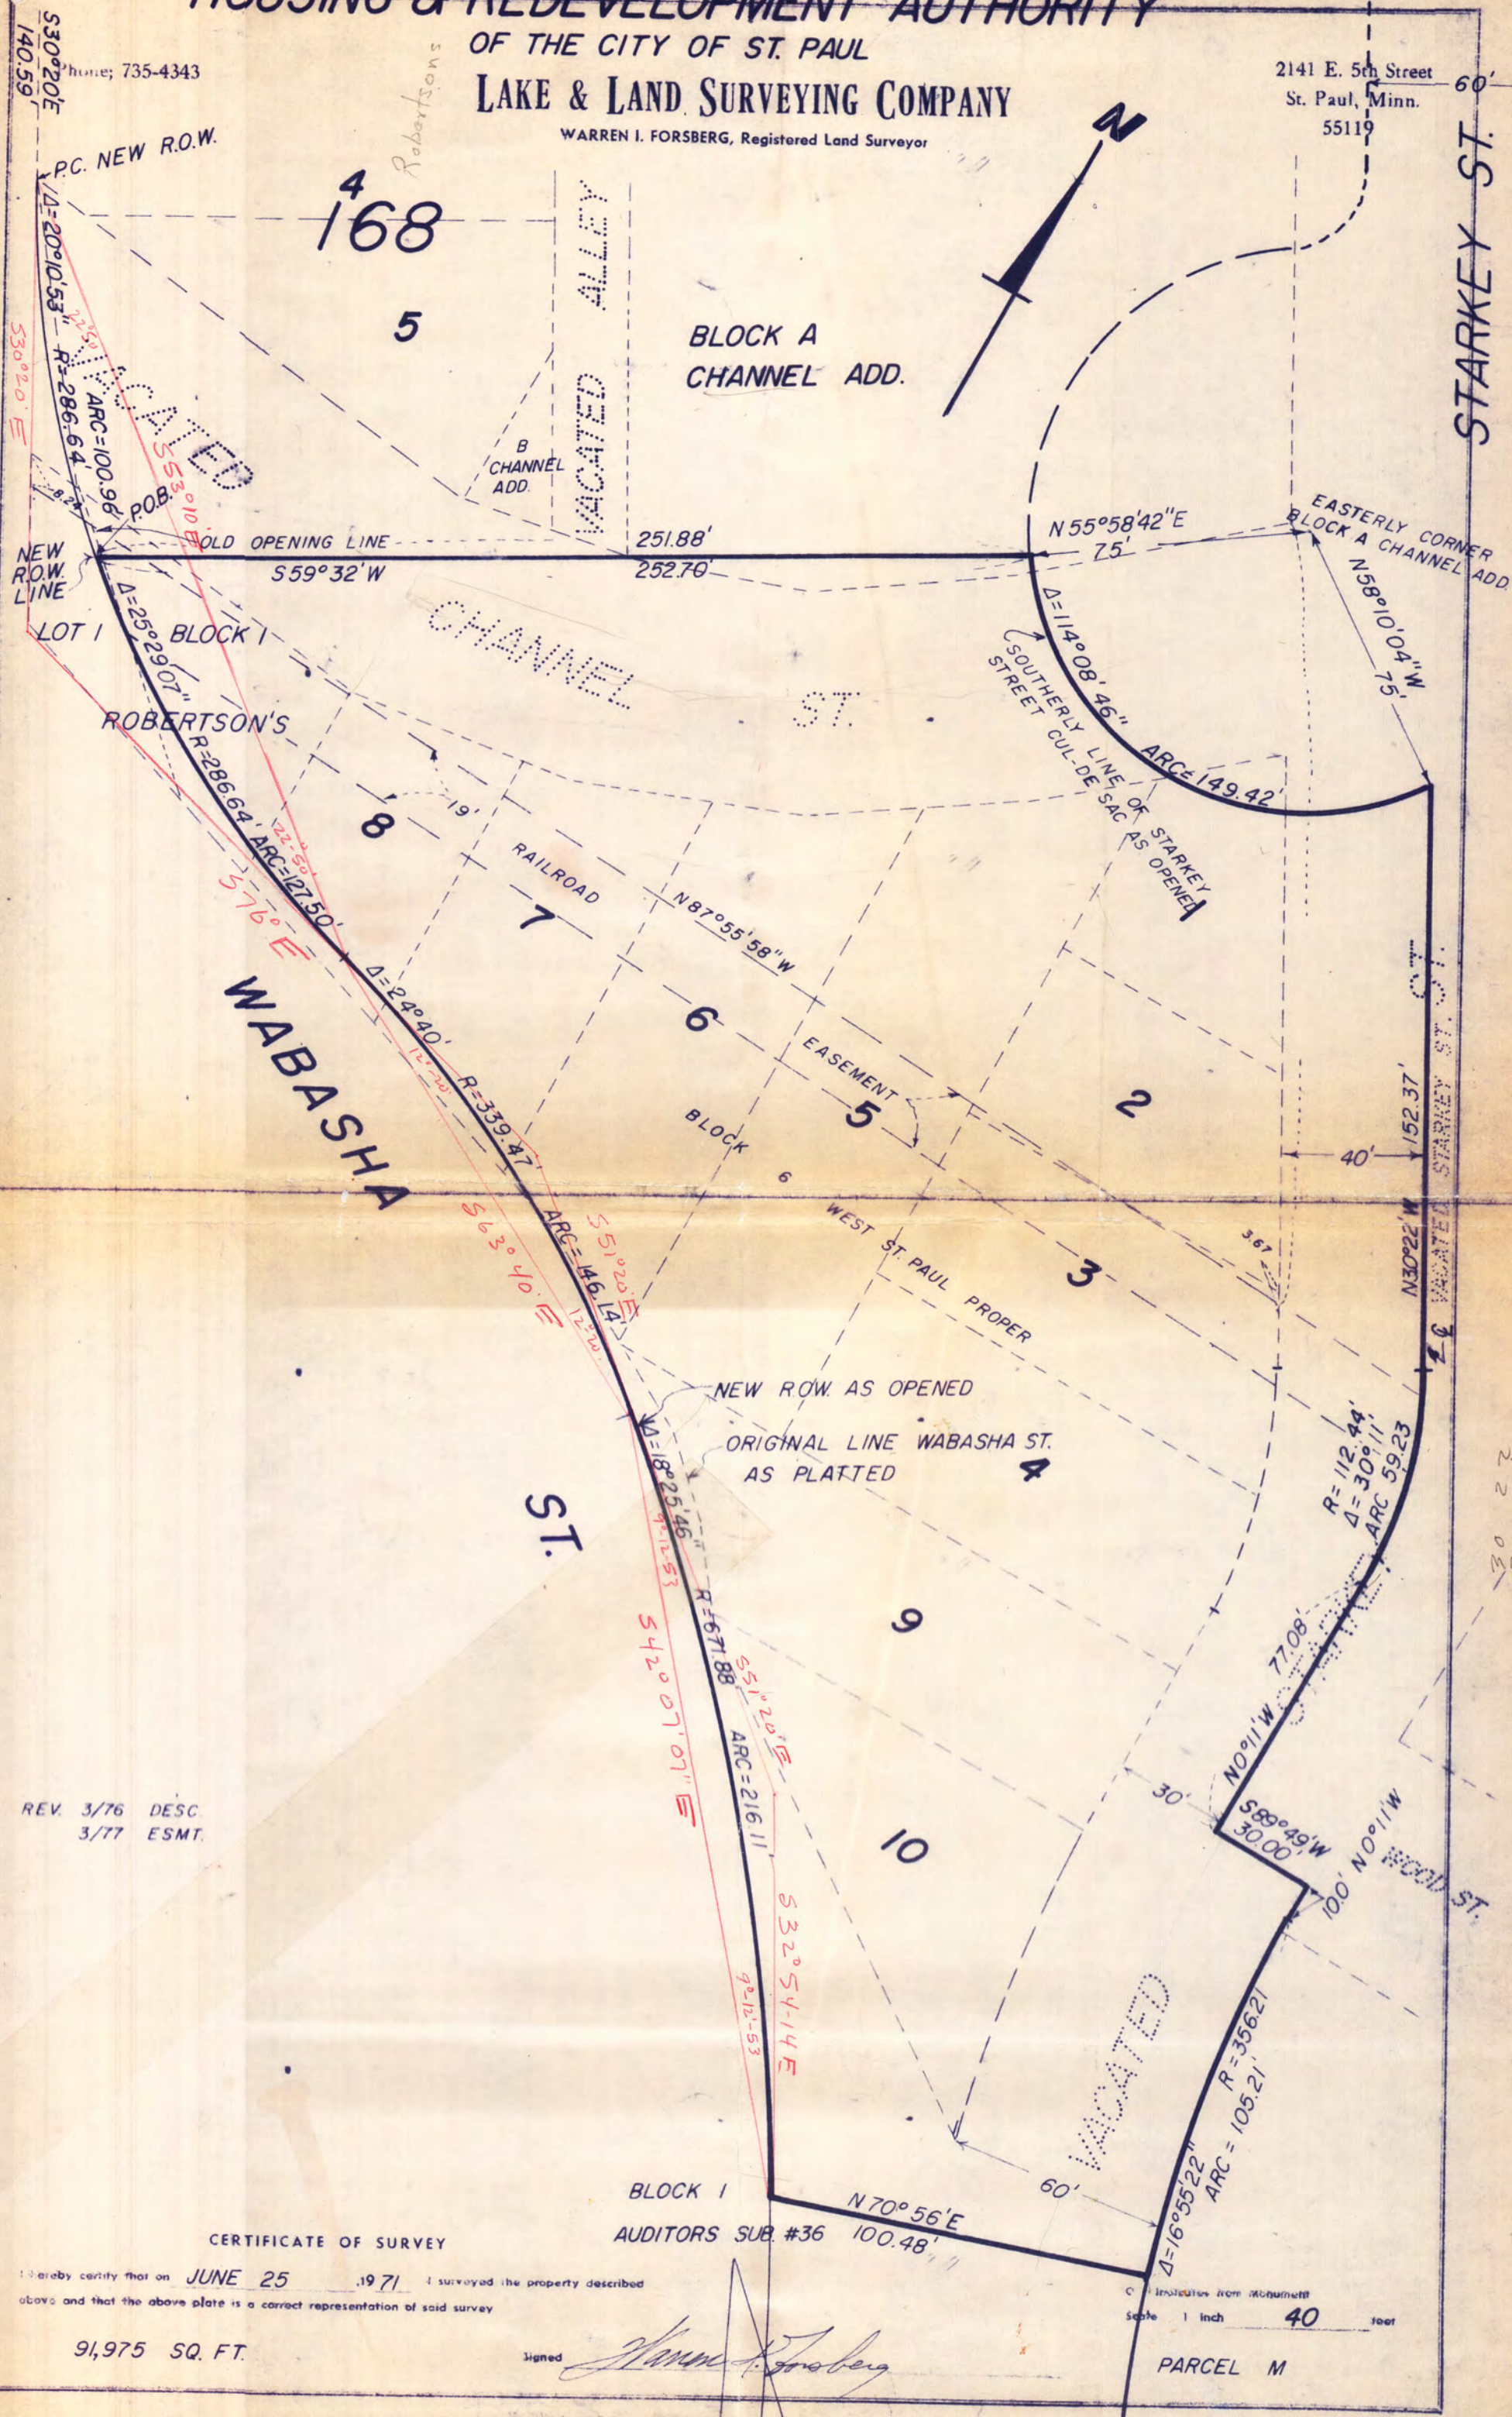

REV. 3/76 DESC.
3/77 ESMT.

CERTIFICATE OF SURVEY

AUDITORS SUB. #36

I hereby certify that on JUNE 25, 1971, I surveyed the property described above and that the above plat is a correct representation of said survey

91,975 SQ. FT.

Signed *Warren I. Forsberg*

Scale 1 inch = 40 feet

PARCEL M