CERTIFICATE OF SURVEY

FOR

CENTURY FENCE COMPANY

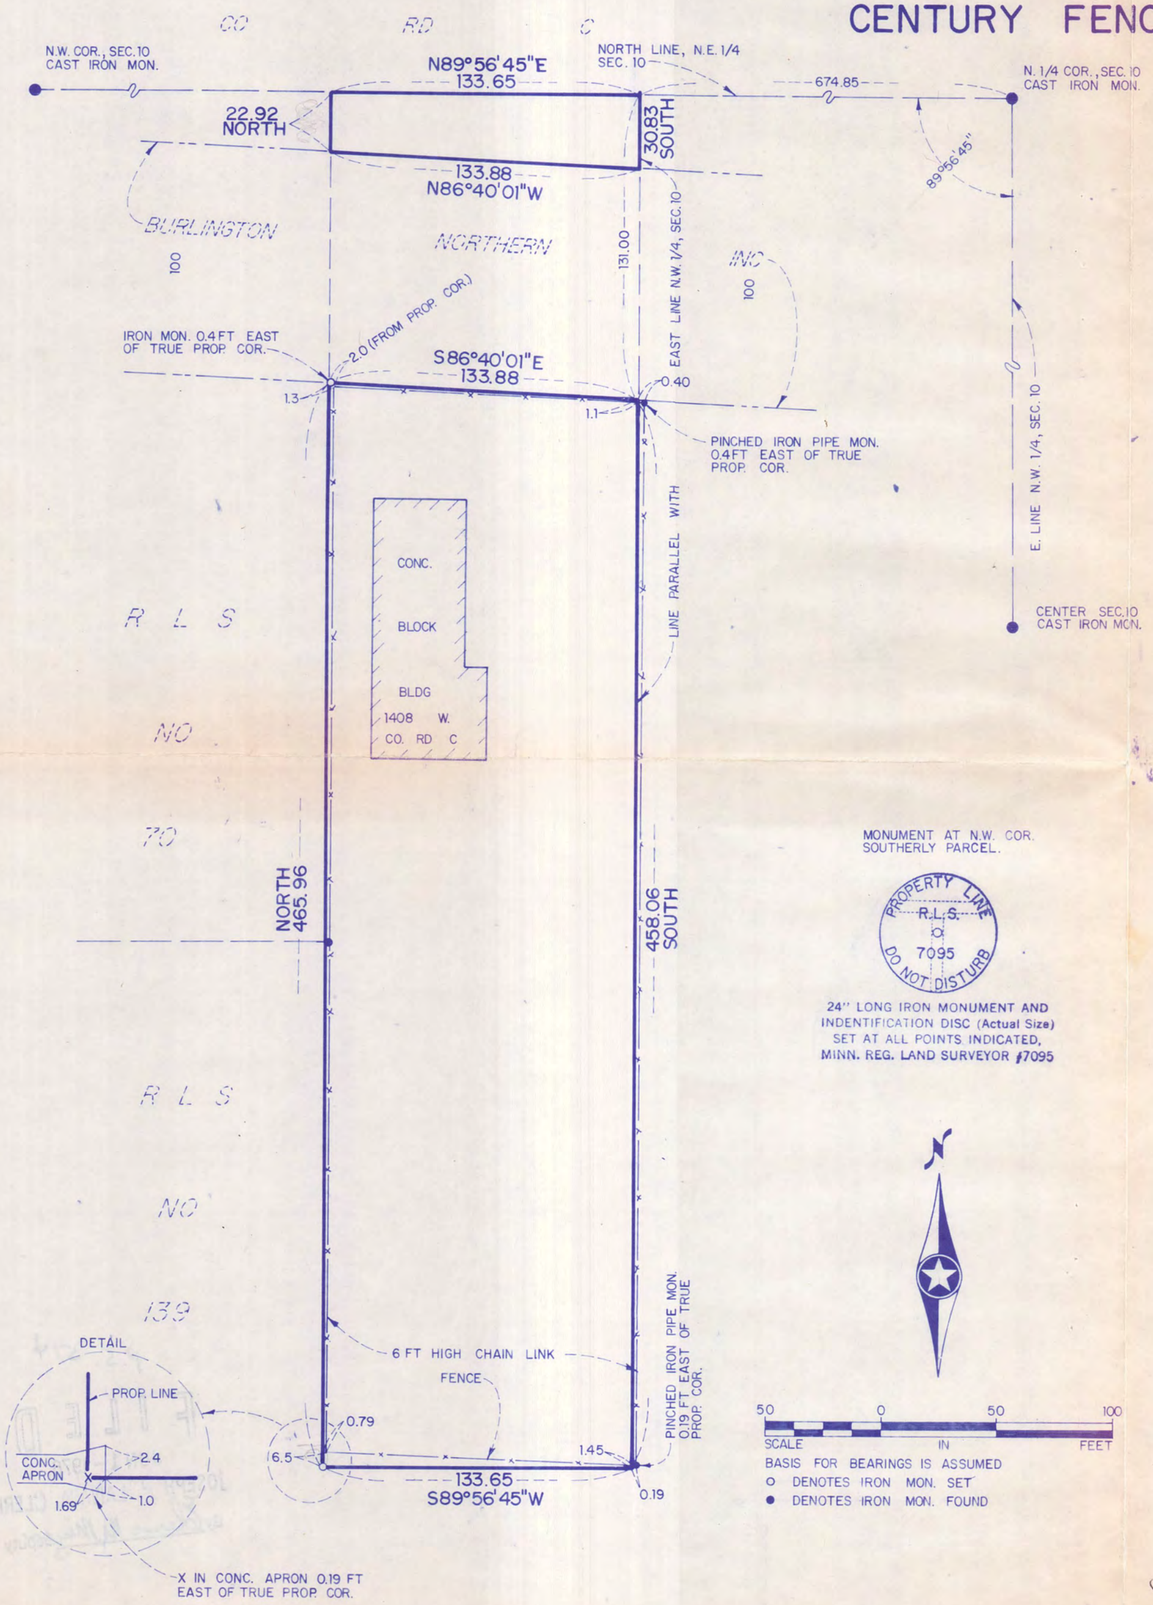

MONUMENT AT N.W. COR.
SOUTHERLY PARCEL.

PROPERTY LINE
R.L.S.
7095
DO NOT DISTURB

24" LONG IRON MONUMENT AND
INDENTIFICATION DISC (Actual Size)
SET AT ALL POINTS INDICATED,
MINN. REG. LAND SURVEYOR #7095

50 0 50 100
SCALE IN FEET

BASIS FOR BEARINGS IS ASSUMED
O DENOTES IRON MON. SET
● DENOTES IRON MON. FOUND

DESCRIPTION OF PROPERTY

That part of the North Half of the Northwest Quarter of Section 10, Township 29, Range 23 described as follows:

Beginning at a point on the north line of said section, distant 674.85 feet West of the northeast corner of the Northwest Quarter of said section; thence on an assumed bearing of South parallel with the east line of said Northwest Quarter 30.83 feet; thence North 86 degrees 40 minutes 01 seconds West 133.88 feet; thence on a bearing of North to the north line of said section; thence easterly to the point of beginning.

and

That part of the North Half of the Northwest Quarter of Section 10, Township 29, Range 23 described as follows:

Commencing at a point on the north line of said section, distant 674.85 feet West of the northeast corner of the Northwest Quarter of said section; thence on a bearing of South parallel with the east line of said Northwest Quarter 131.00 feet to the actual point of beginning of the land to be described; thence on a bearing of South 458.06 feet; thence South 89 degrees 56 minutes 45 seconds West 133.65 feet; thence on a bearing of North 465.96 feet; thence Southeasterly to the actual point of beginning.

514

I hereby certify that this survey was prepared by me, or under my direct supervision, and that I am a duly Registered Land Surveyor under the laws of the State of Minnesota.

James E. Bardsane

Date 5-25-76 Reg. No. 7095

BRW
PLANNING TRANSPORTATION / ENGINEERING ARCHITECTURE

BATHER RINGROSE WOLSFELD INC.
7101 YORK AVENUE S. EDINA, MINNESOTA 55435 612/831-2300

5-7540