


LAKE & LAND SURVEYING COMPANY

WARREN I. FORSBERG, Registered Land Surveyor

HOUSING AUTHORITY OF THE CITY OF SAINT PAUL, MINNESOTA

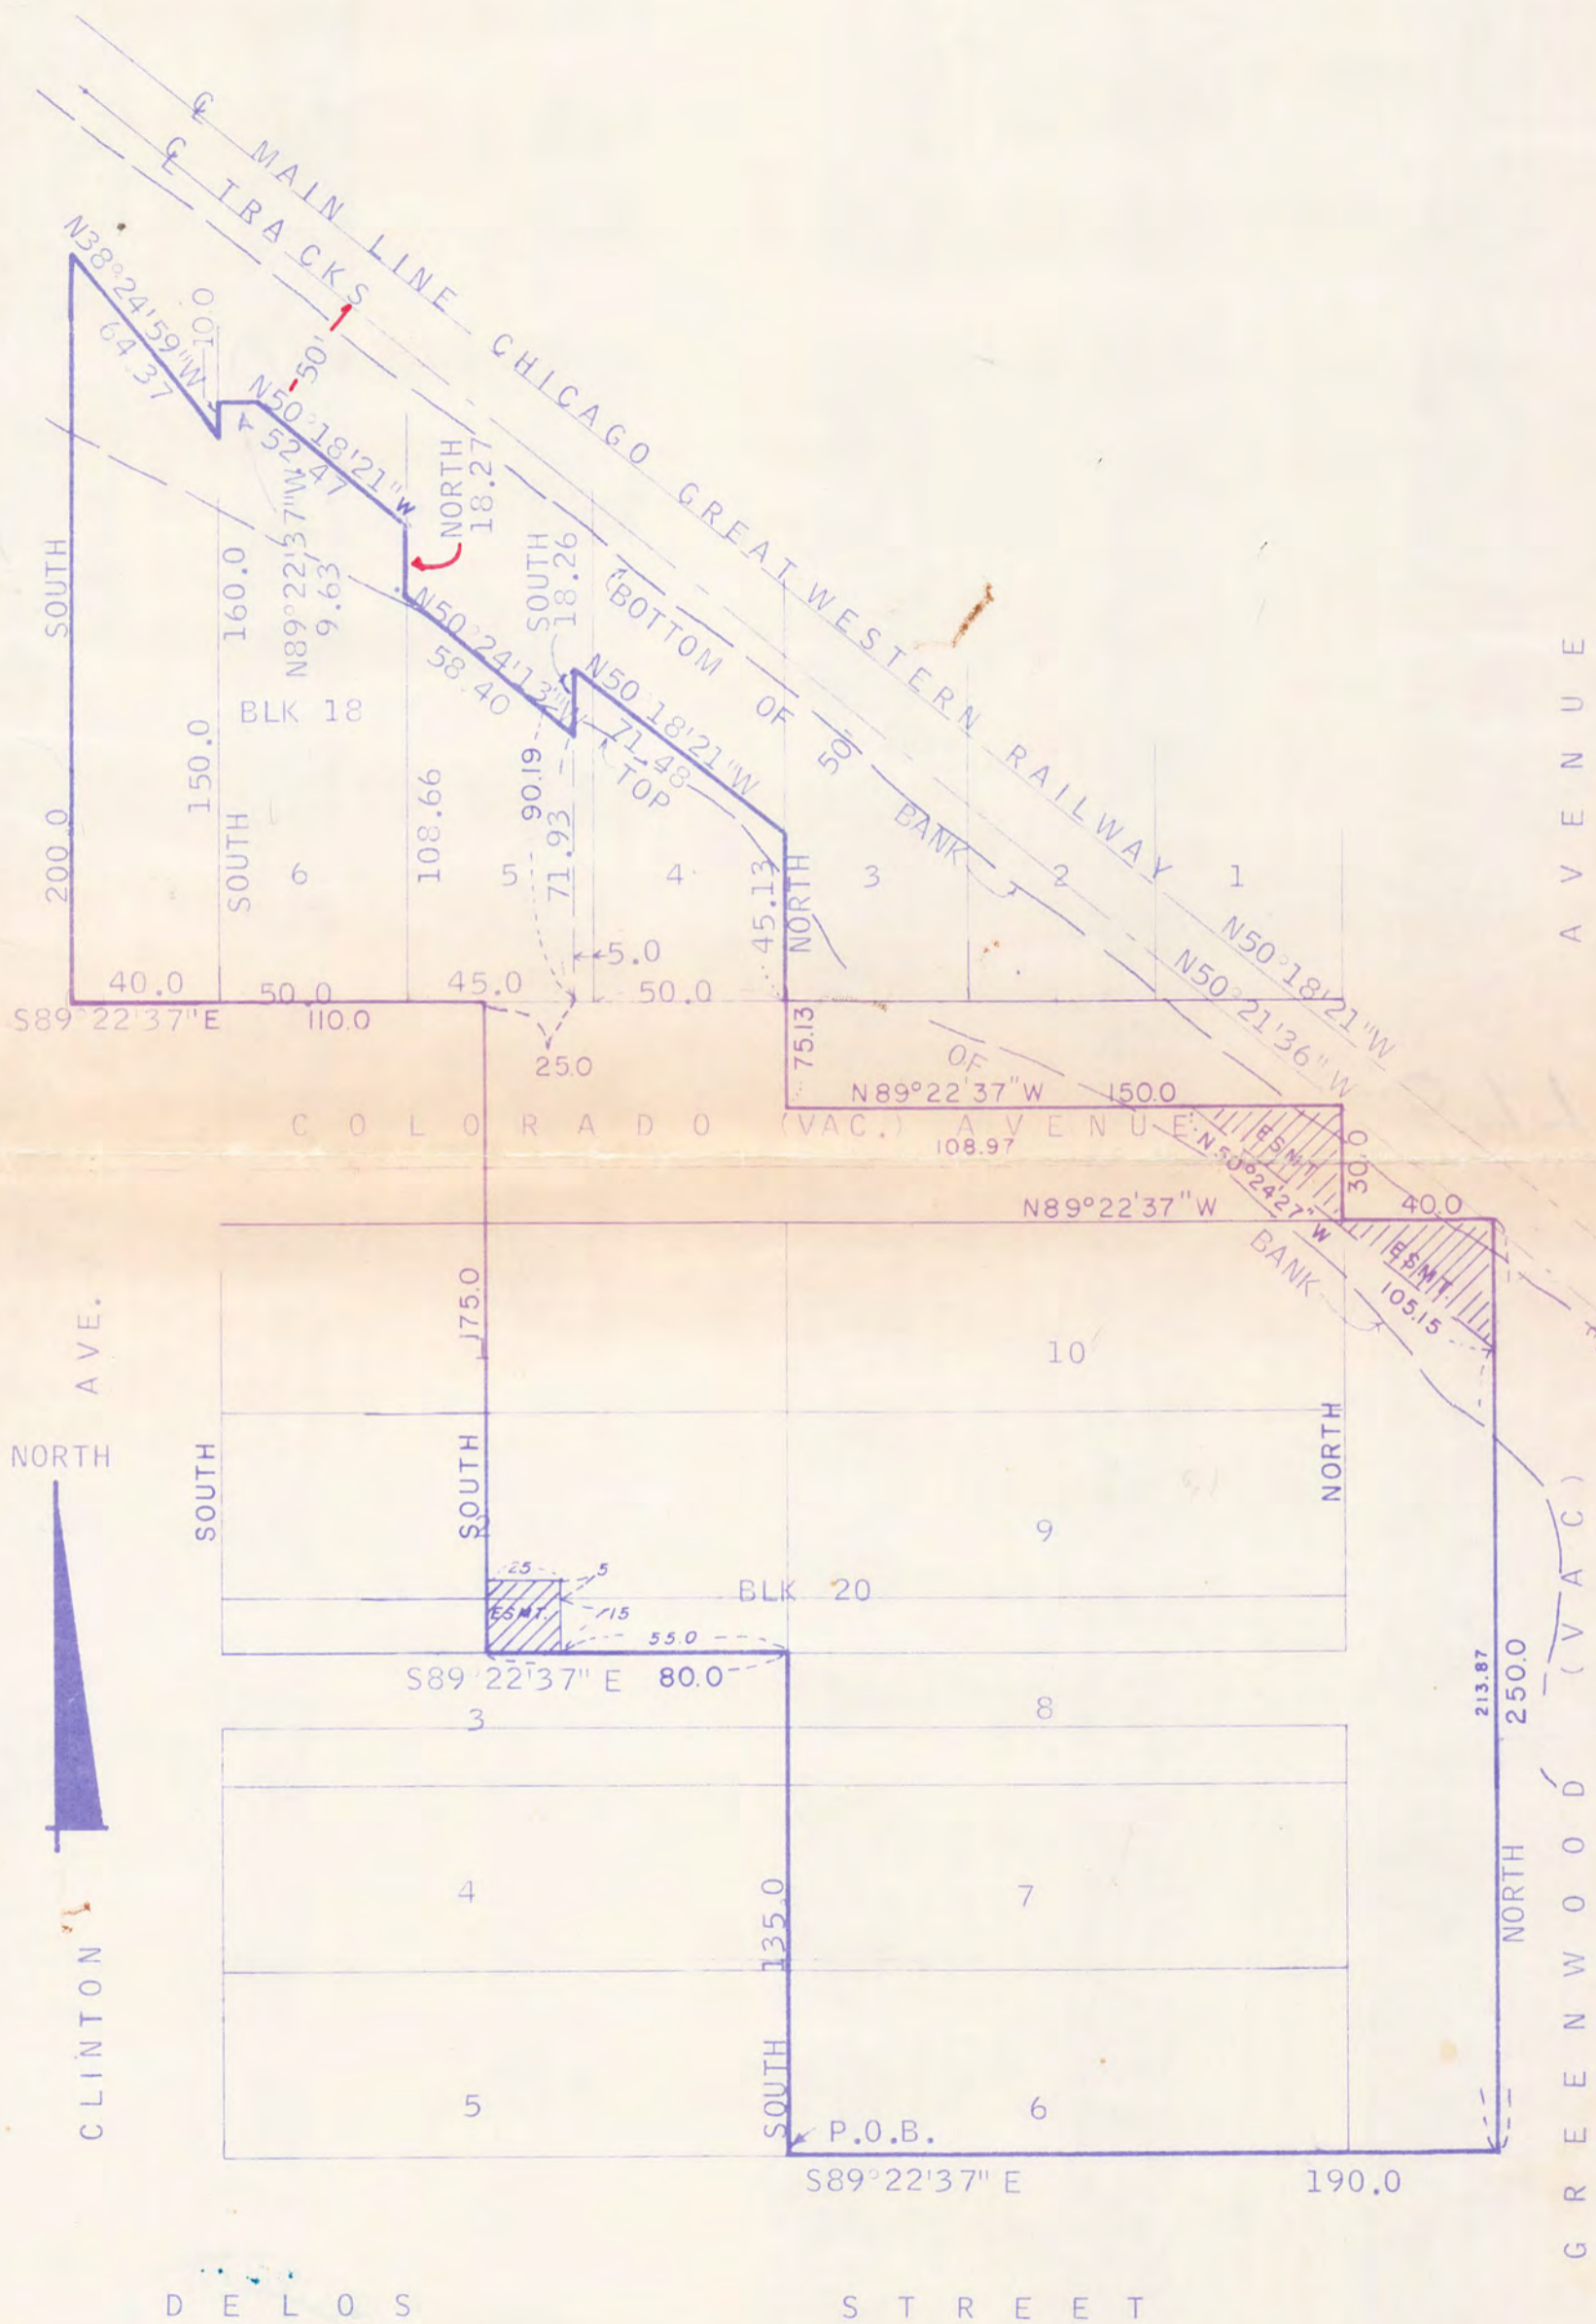

CERTIFICATE OF SURVEY

DEC. 19 1975
~~April 27~~ 1973

I hereby certify that on ~~April 27~~ 1973 I surveyed the property described above and that the above plate is a correct representation of said survey.

Scale: 1 inch = 50 feet
C indicates non monument

REV. 9/5/74 DISTANCE
R37/99,950 Sq. Ft. / =103

signed

Warren I. Forsberg

Sheet 1 of 2