

WARREN I. FORSBERG


Registered Land Surveyor

2141 E. 5th Street
St. Paul, Minn.
55119

SURVEY FOR: **HOUSING AND REDEVELOPMENT AUTHORITY.**


SEE SHEET 2 of 3 FOR DESCRIPTION

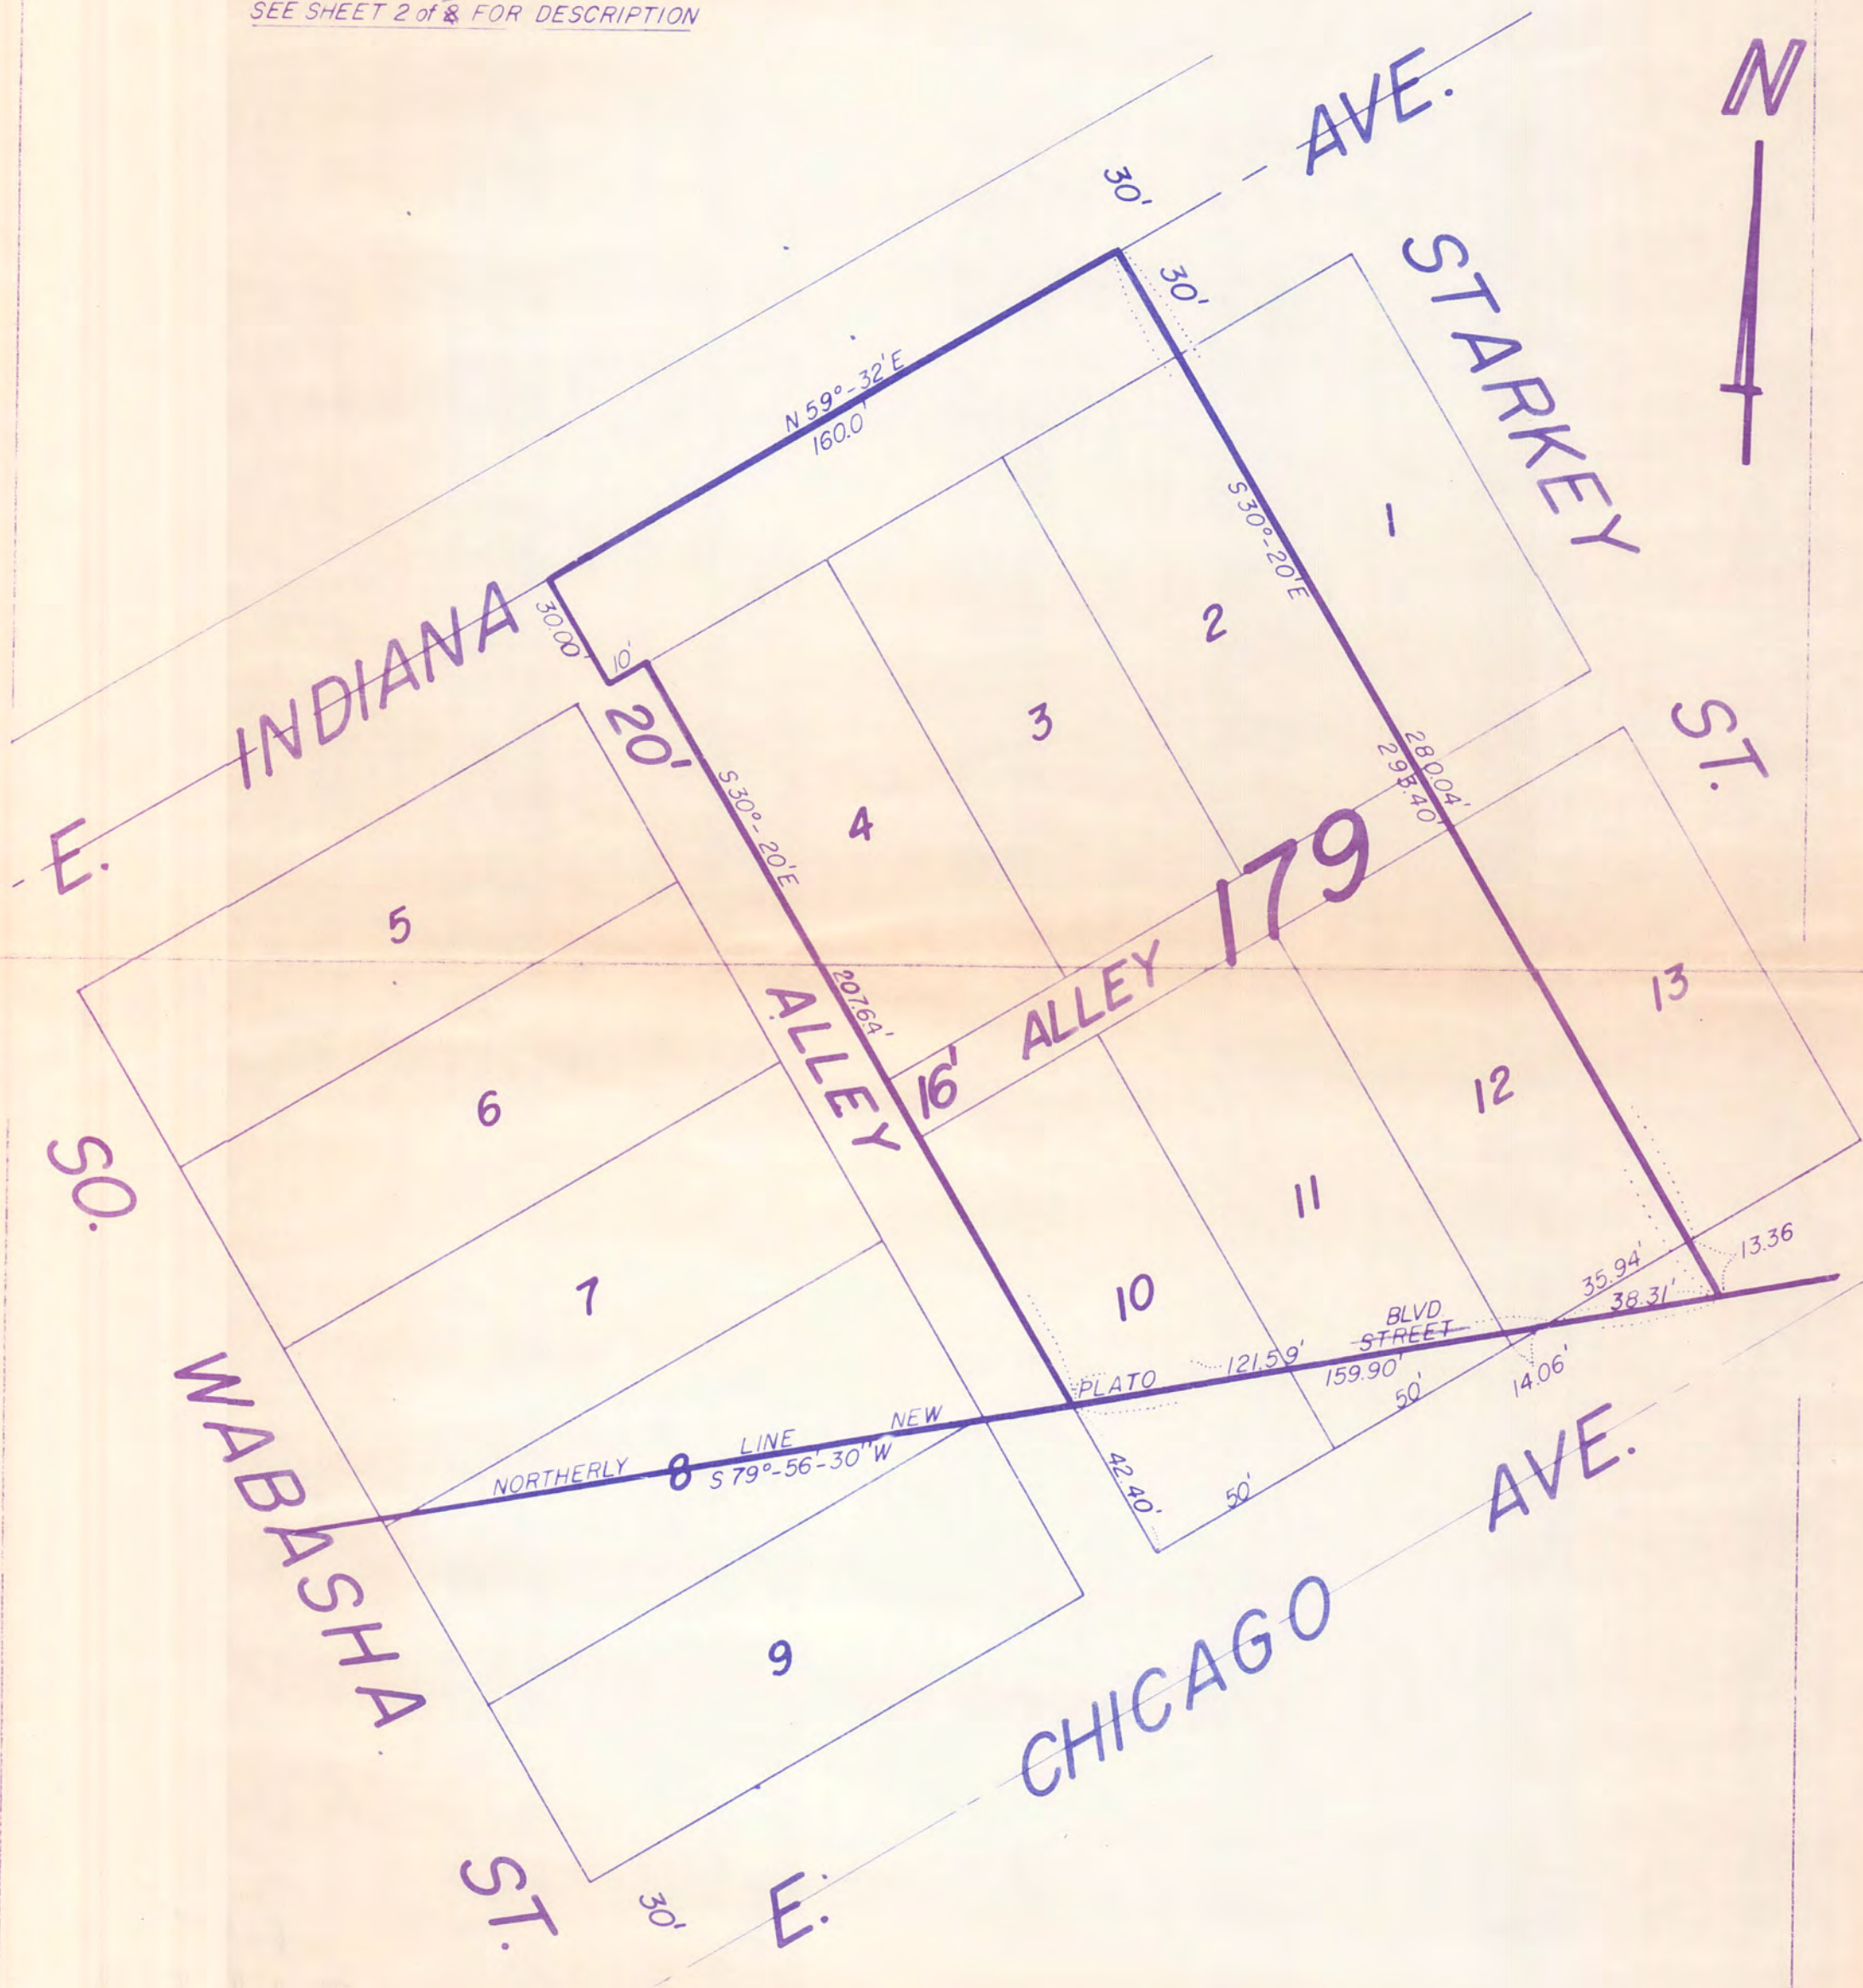

CERTIFICATE OF SURVEY

I hereby certify that on JAN. 28, 1966 I surveyed the property described above and that the above plat is a correct representation of said survey.

Scale: 1 inch = 40 feet.

O - Indicates Iron Monument.

40,126
39,826 SQ. FT.

SHEET 1 OF 3 R-26/4-12659.FT/0-3

Signed *Warren I. Forsberg*

9