


Phone; 735-4343

LAKE & LAND SURVEYING COMPANY

WARREN I. FORSBERG, Registered Land Surveyor

1903 E. Minnehaha Ave.
St. Paul, Minn.
55119

Survey for: Aurther Mueller
Described as: Show the East 56.0 feet of Lot 1, Block 3, Como, along with the street and avenue adjacent thereto.

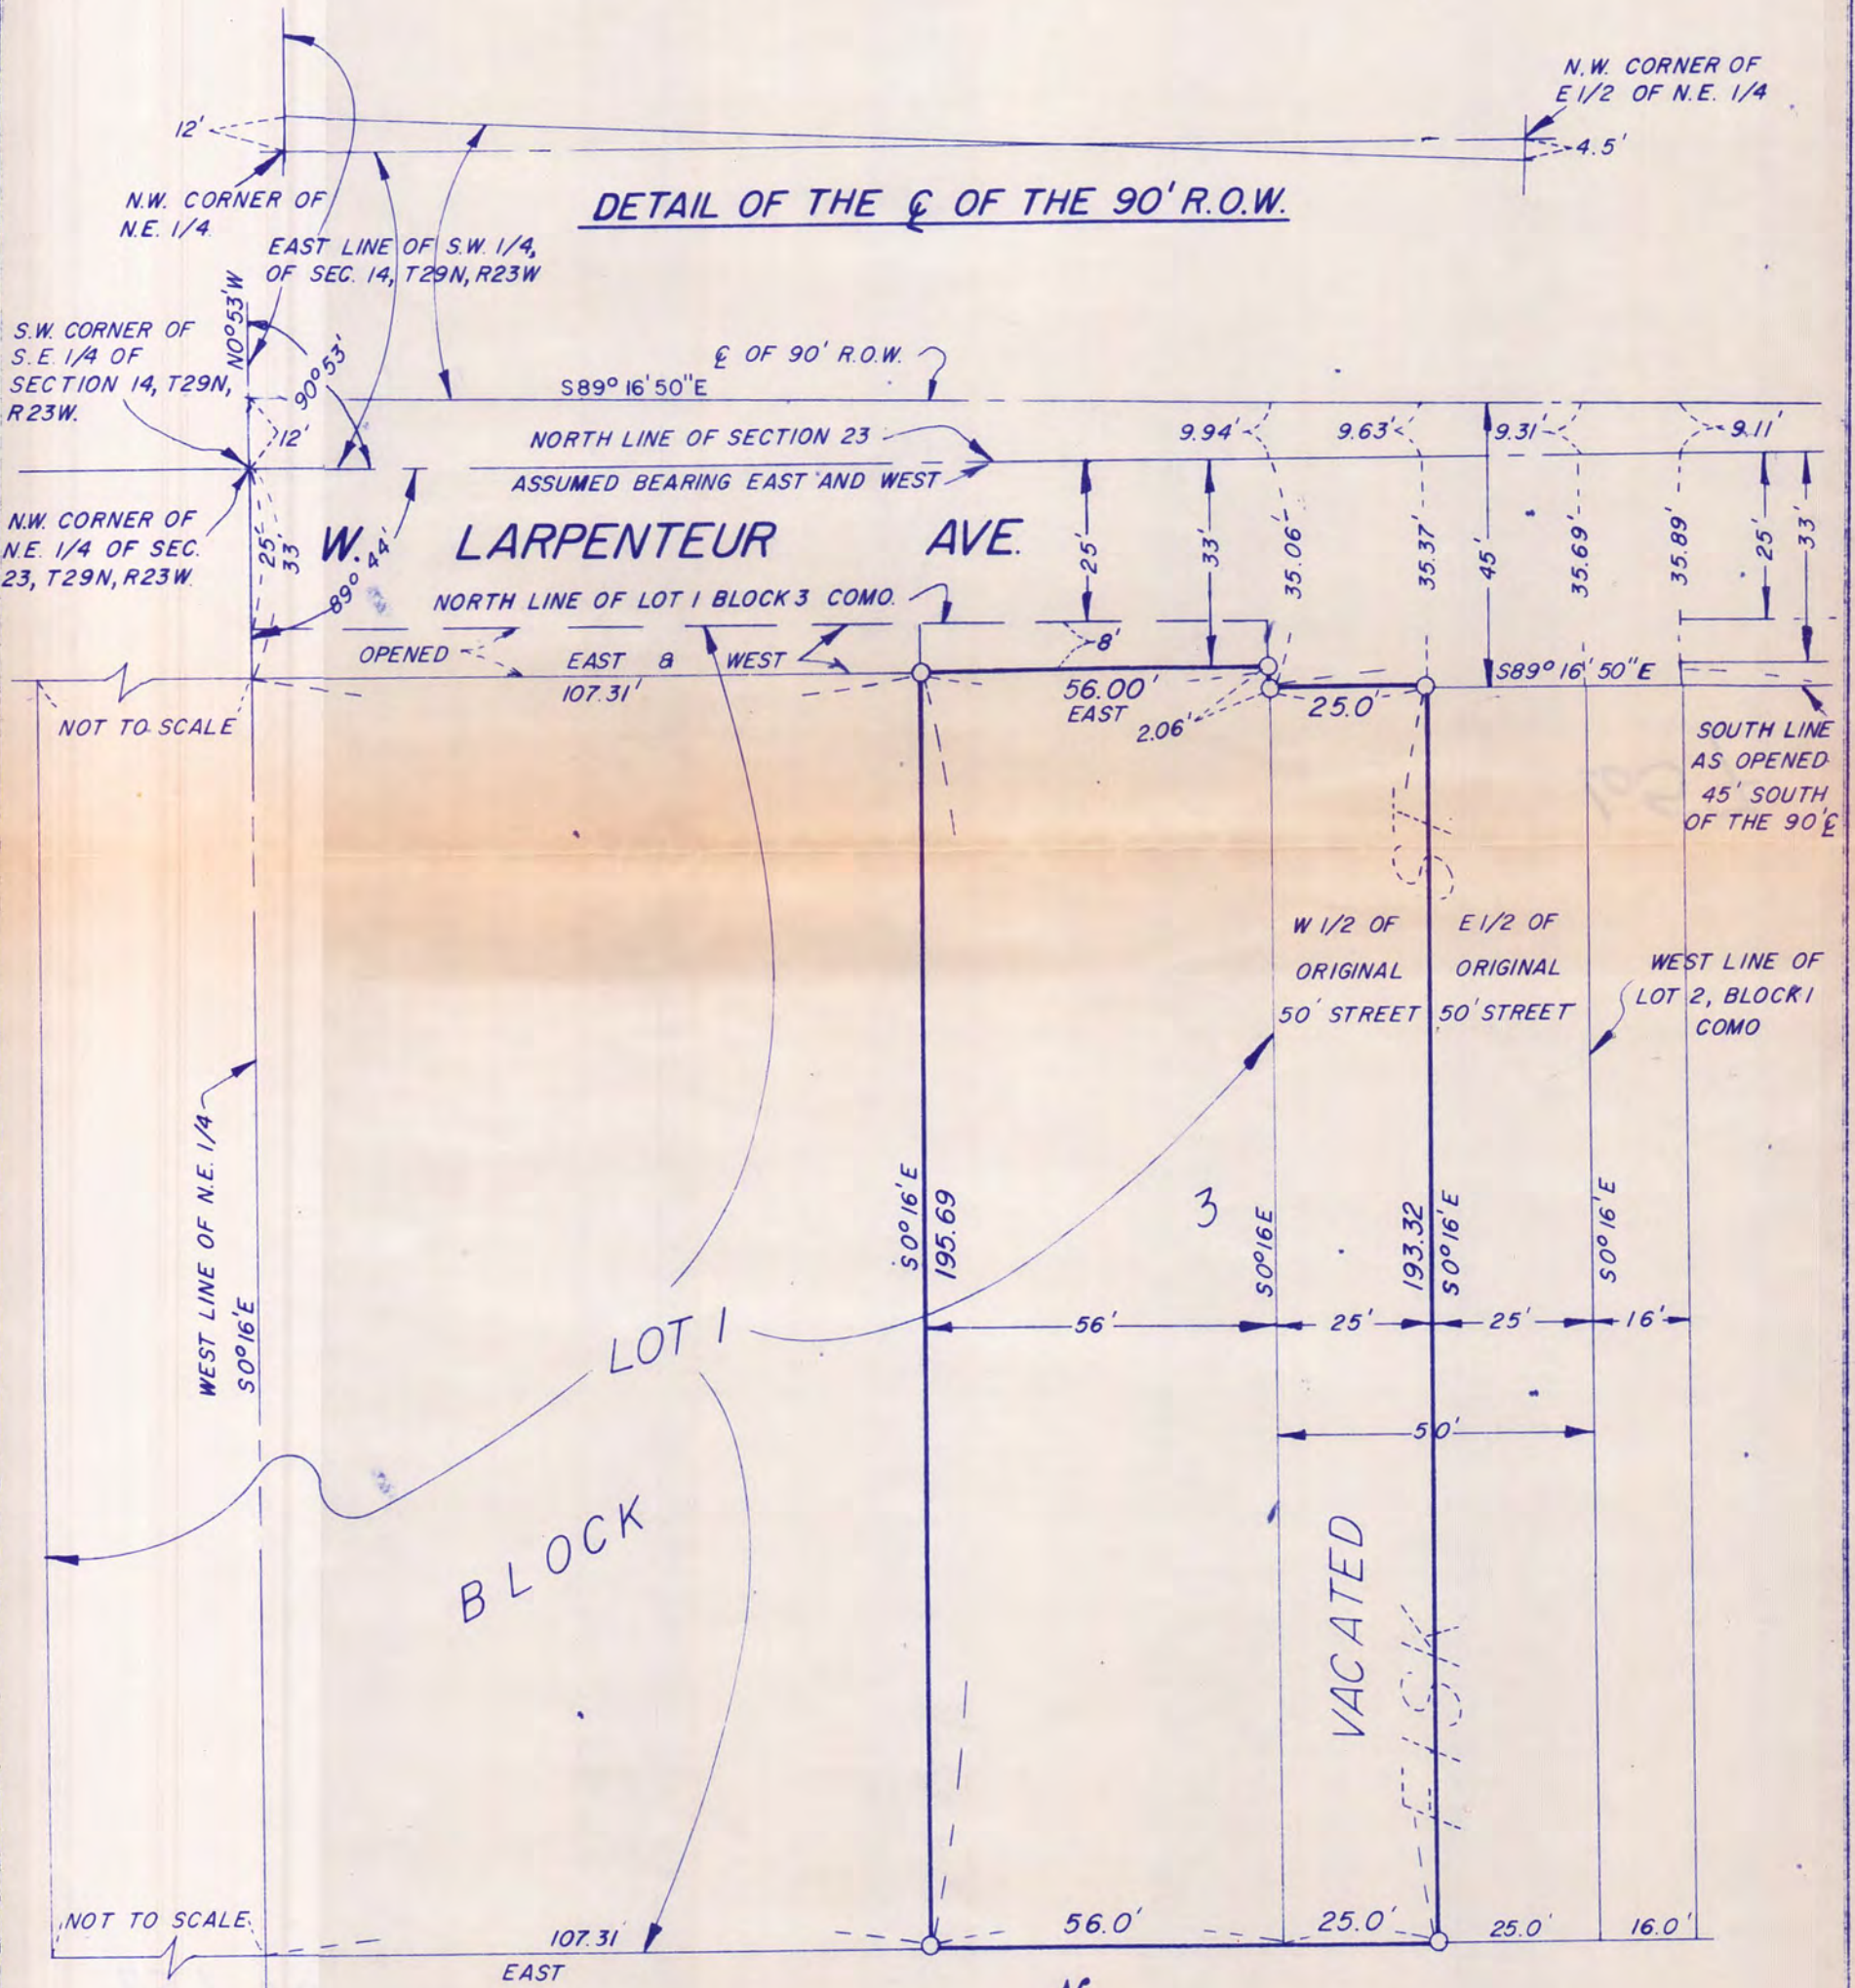

CERTIFICATE OF SURVEY

I hereby certify that on AUG. 16, 1977 I surveyed the property described above and that the above plate is a correct representation of said survey



O indicates Axis Monument
Scale 1 inch = 30 feet

Signed *Warren I. Forsberg*