

TOPOGRAPHY SURVEY



KELLER LAKE
Water Elev 858.00 9/15/08



KELLER LAKE
Water Elev 858.00 9/15/08

DESCRIPTION

Part of the SE 1/4 of the SW 1/4 of Section 9, T29, R22, Ramsey County, Minnesota, lying in Keller Lake.

NOTES

This is not a boundary survey. No field work has been done to establish the boundary of this property.
Subsurface and environmental conditions were not searched or considered during the process of this survey. No statement is made concerning the existence of underground facilities that may affect the use of the surveyed premises.

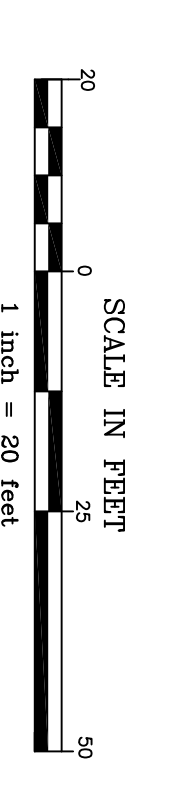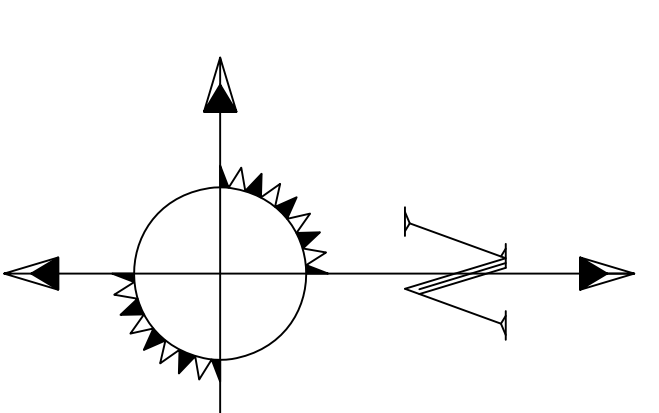

LEGEND:

- Denotes 1/2" x 1/4" Iron Monument to be set and marked by NLS 17785
- ⊙ Denotes Electric Meter
- ⊠ Denotes Picnic Table on Concrete Slab
- ⊞ Denotes Bar-B-Que Grill
- ⊕ Denotes Sign

DATE	REVISIONS

I hereby certify that this survey, plan or report was prepared by me or under my direct supervision and that I am a duly Licensed Land Surveyor under the laws of the state of Minnesota.
 Ronald P. Alwin
 DATE _____ LIC. NO. 17785

KELLER REGIONAL PARK
MAPLEWOOD, MN
 TOPOGRAPHY SURVEY
KELLER ISLAND

RAMSEY COUNTY
PARKS & RECREATION DEPT.
2015 NORTH VAN DYKE STREET
MAPLEWOOD, MN 55109-3796

DRAWN	SCALE
2180.0010	A:1
10/15/08	
5/5	