


CERTIFICATE OF SURVEY
OPEN SPACE PROJECT NO. 72-6
LILLYDALE
PARCEL NO. 11

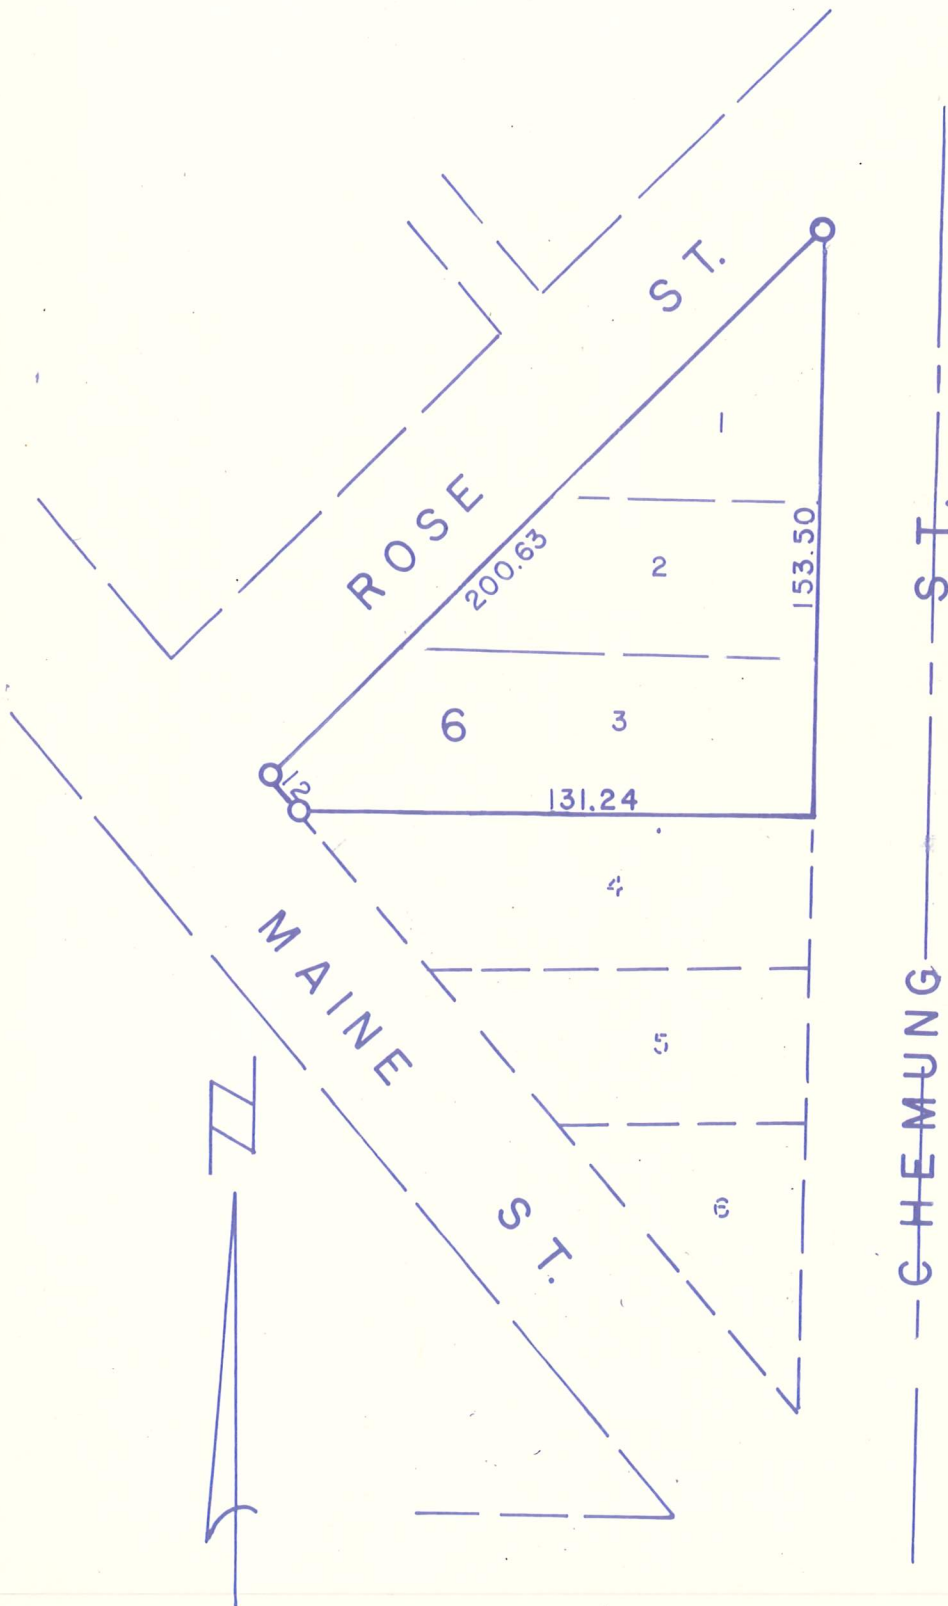

Lots 1, 2, and 3, Block 6,
 Lillydale Addition, Dakota
 County Minnesota.

○ Denotes Iron Monument
 Placed.

I hereby certify that
 this survey was done by
 me and that I am a duly
 Registered Land Surveyor
 under the laws of the State
 of Minnesota.

Ronald F. Meyer
 Reg. No. 9051

Dated: 3-5-79

AREA = 11268± Sq. Ft.

SCALE: 1" = 50'