


CERTIFICATE OF SURVEY
OPEN SPACE PROJECT NO. 72-6
LILLYDALE
PARCEL NO. 38

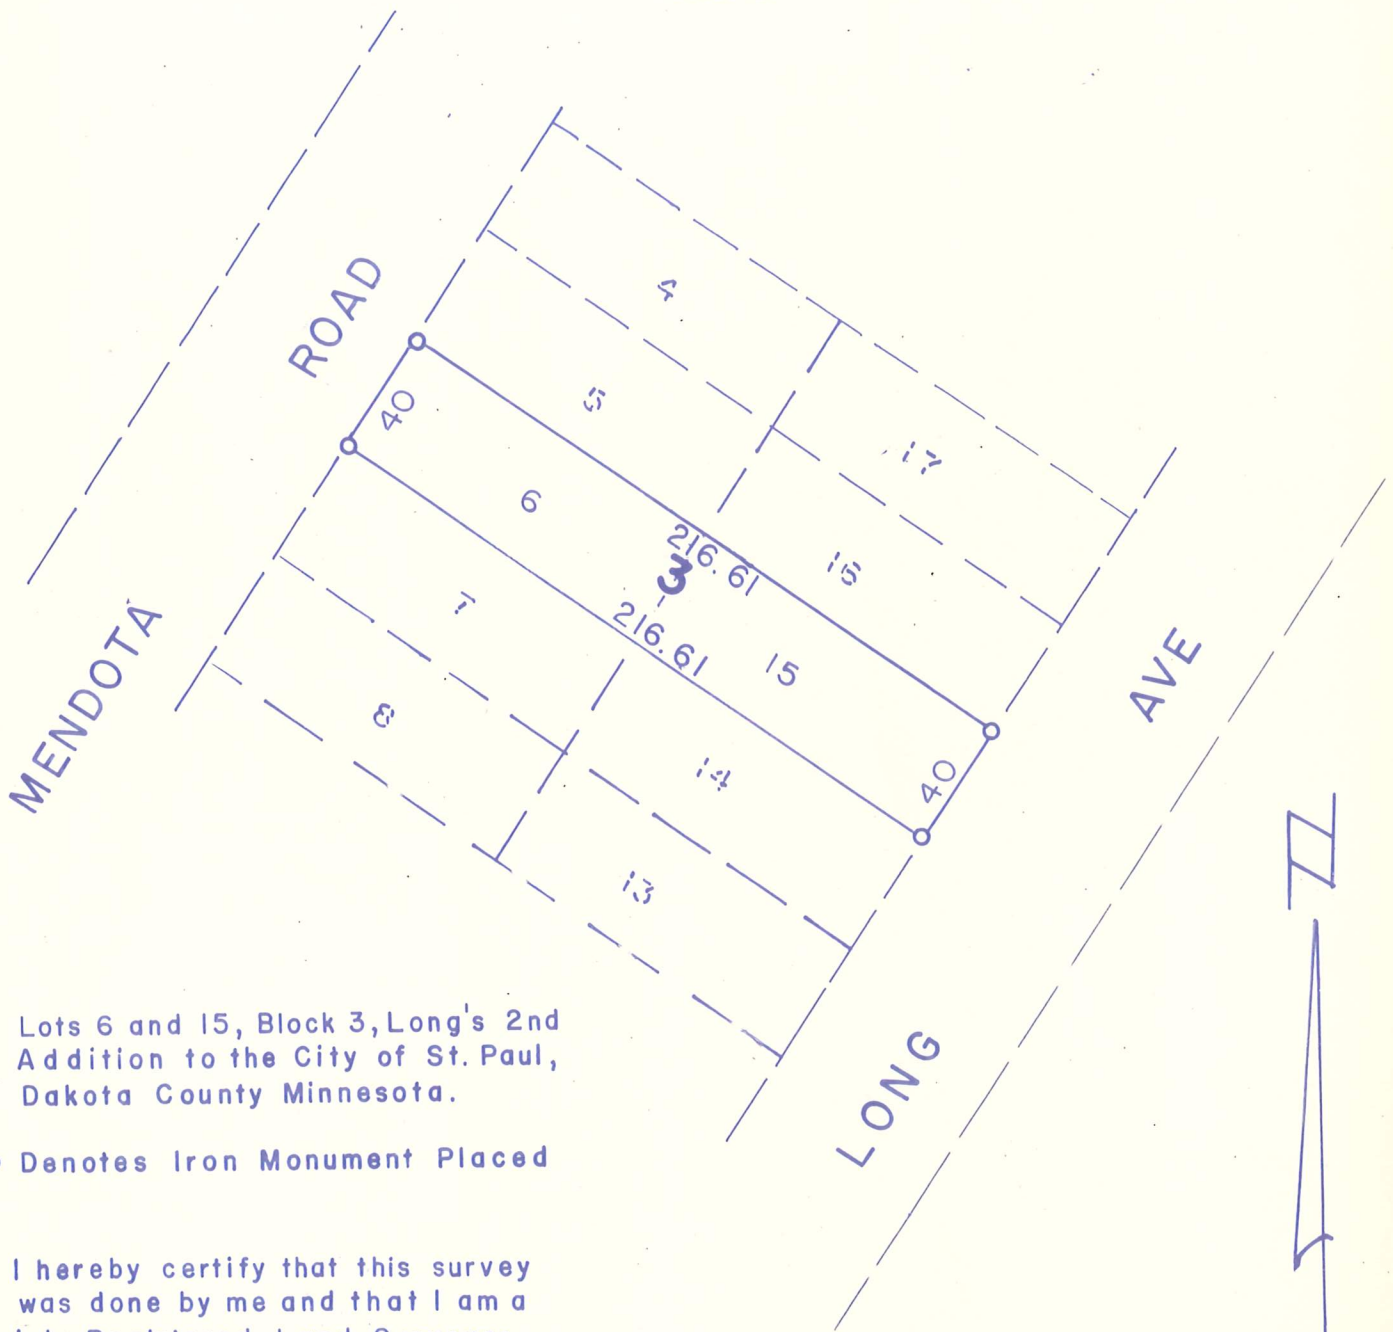

Lots 6 and 15, Block 3, Long's 2nd Addition to the City of St. Paul, Dakota County Minnesota.

○ Denotes Iron Monument Placed

I hereby certify that this survey was done by me and that I am a duly Registered Land Surveyor under the laws of the State of Minnesota.

Ronald F. Meyer
 Reg. No. 9051

Date: 3-5-79



SCALE: 1" = 60'