CERTIFICATE OF SURVEY

DEPARTMENT OF PUBLIC WORKS
OF RAMSEY COUNTY

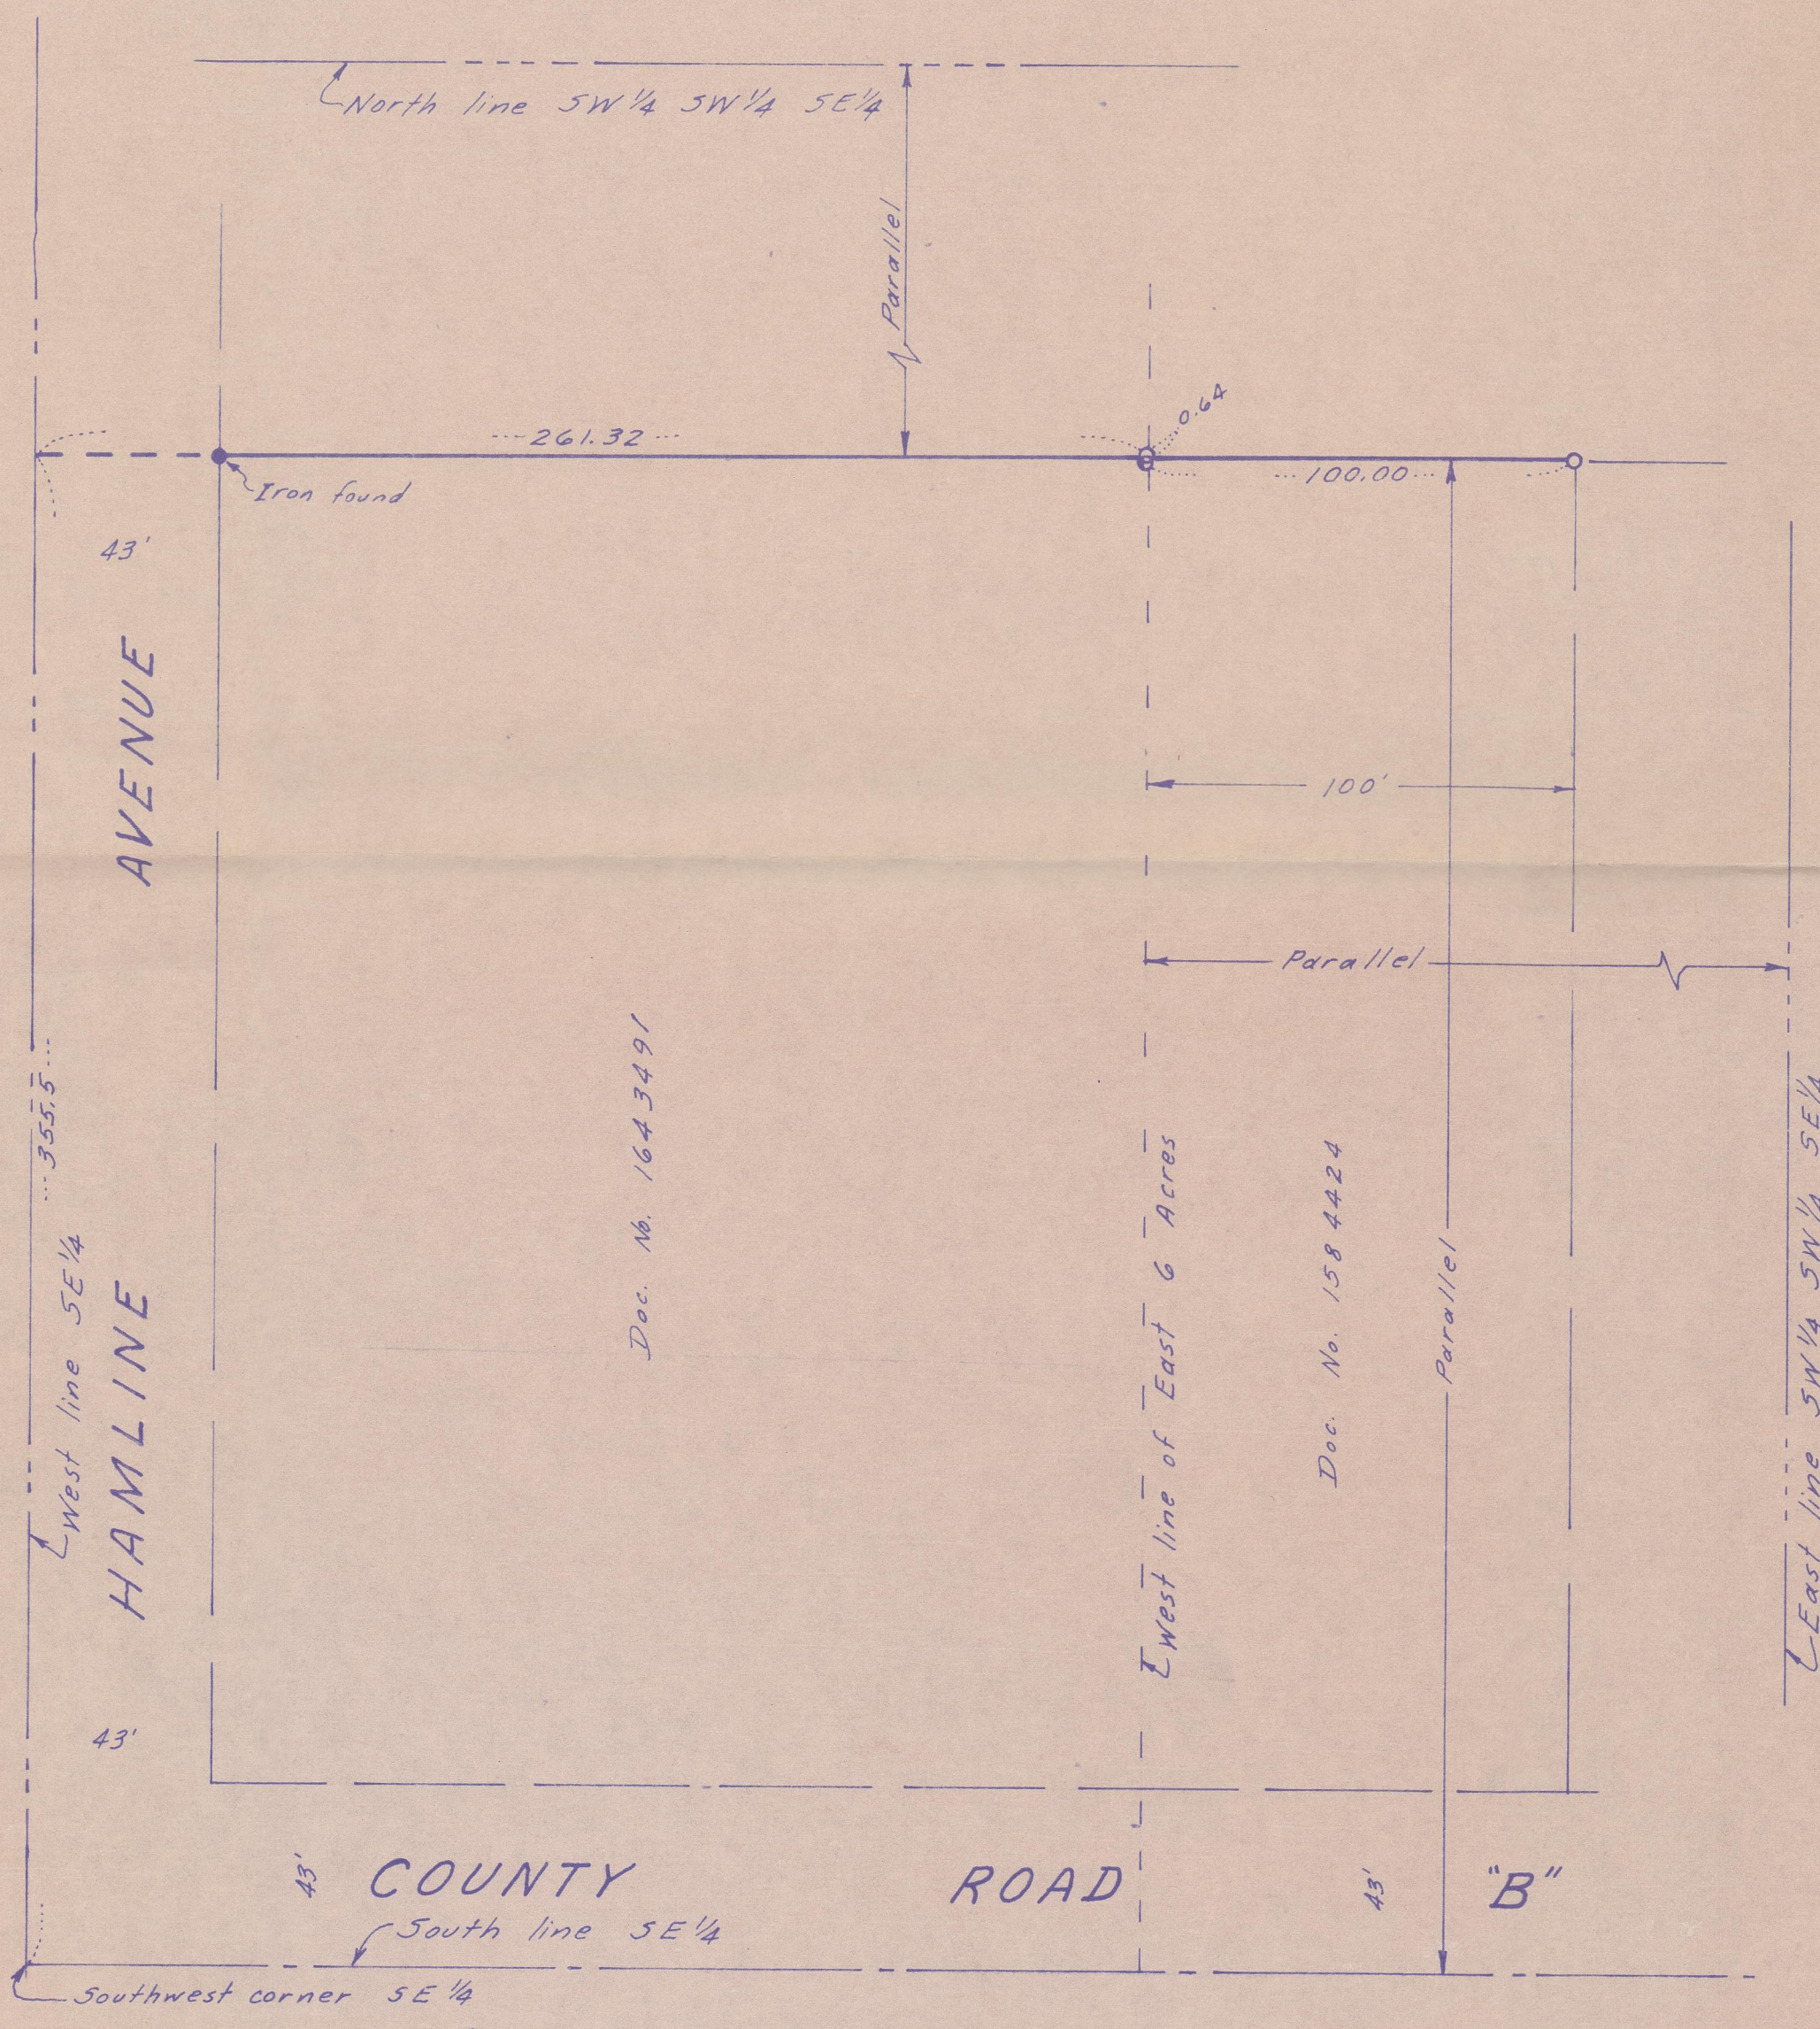

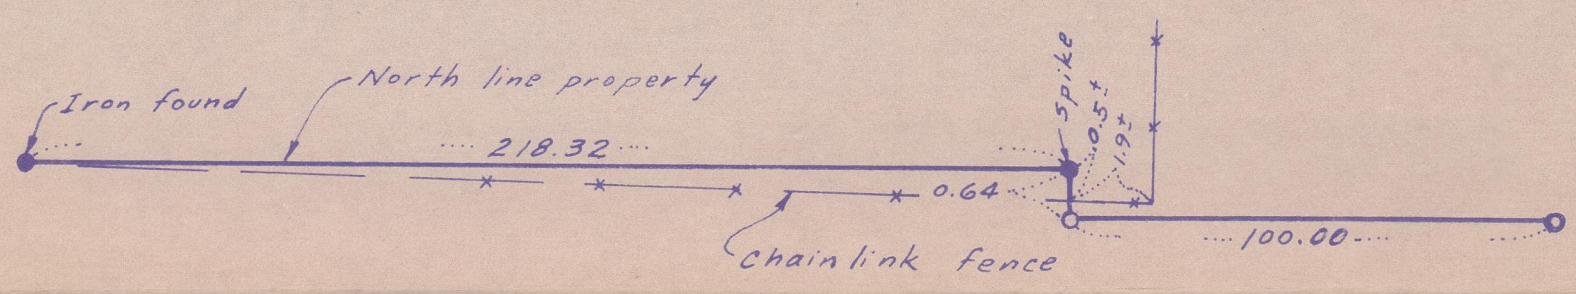

FENCE ENCROACHMENT
(not to scale)

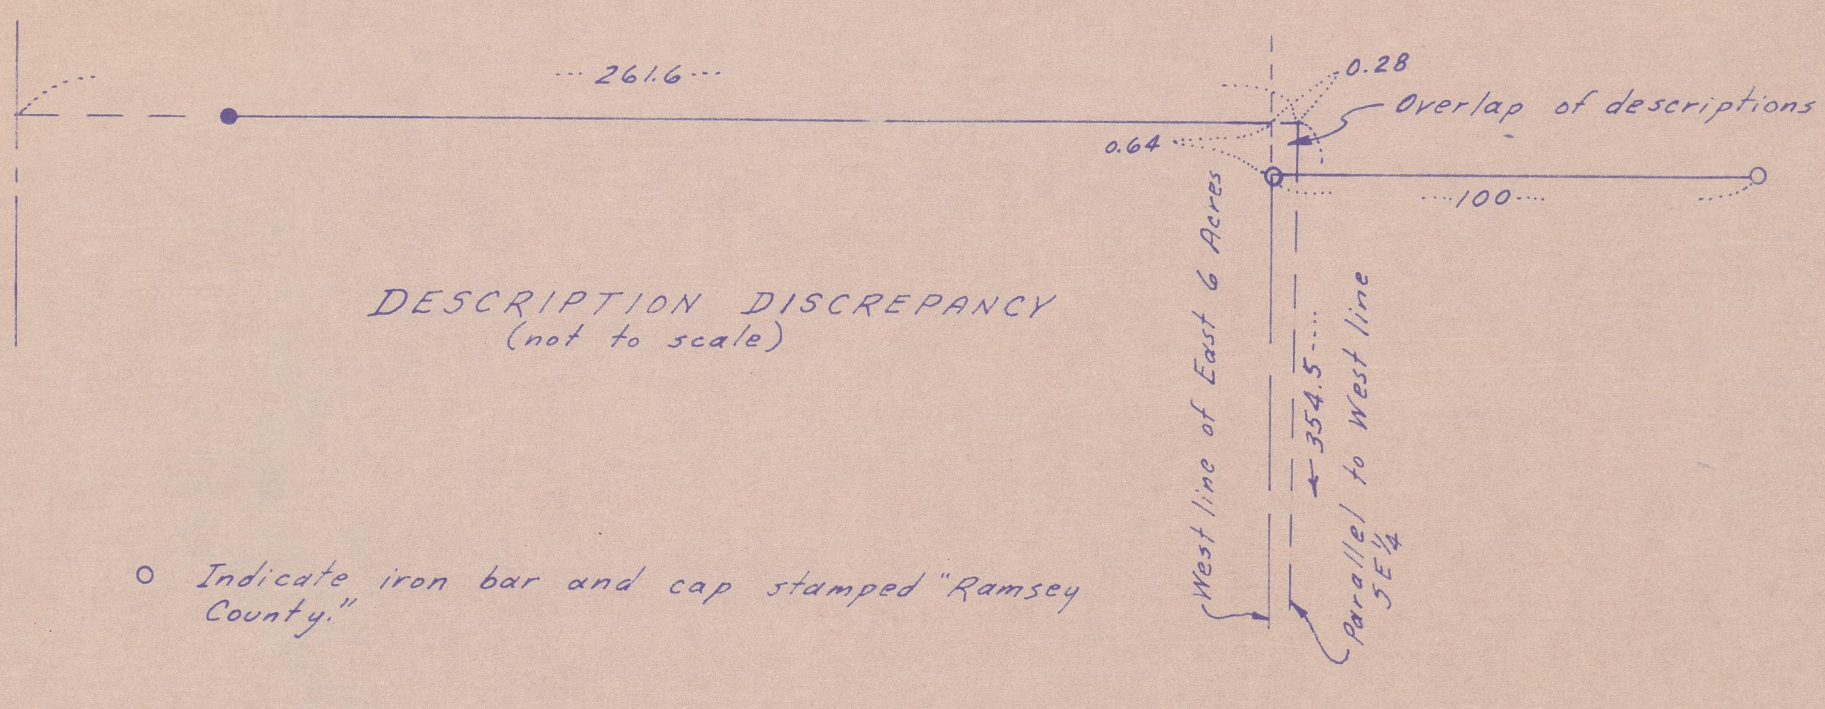

DESCRIPTION DISCREPANCY
(not to scale)

○ Indicate iron bar and cap stamped "Ramsey County."

Scale: 1" = 40'

I hereby certify that this survey was prepared by me and that I am a duly Registered Land Surveyor under the laws of the State of Minnesota.

Ronald F. Meyer Reg. No. 9051 Date: June 6, 1984