
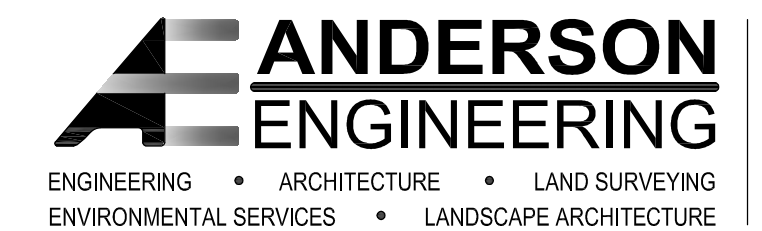
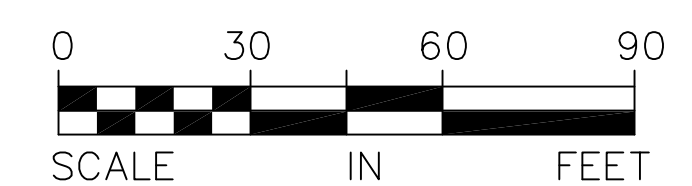


LEGEND

- AUTO SPRINKLER
- CATCH BASIN
- CATCH BASIN
- CLEAN OUT
- COMMUNICATION JUNCTION BOX
- CONTROL POINT
- CULVERT
- ELECTRIC BOX
- ELECTRIC OUTLET POST
- ELECTRIC METER
- FLAG POLE
- GAS VALVE
- GUARD POST
- HANDICAP PARKING
- HANDHOLE
- HANDHOLE ELECTRIC
- HYDRANT
- IRRIGATION CONTROL VALVE
- LIGHT POLE
- POWER POLE
- POWER POLE ANCHOR
- ROOF DRAIN
- SANITARY MANHOLE
- SIGN
- STORM MANHOLE
- STOP BOX
- WATER VALVE
- CONIFEROUS TREE
- DECIDUOUS TREE
- SHRUB
- FENCE
- GAS MAIN
- OVERHEAD WIRES
- SANITARY SEWER
- STORM SEWER
- UNDERGROUND ELECTRIC
- WATER MAIN
- GUARD RAIL

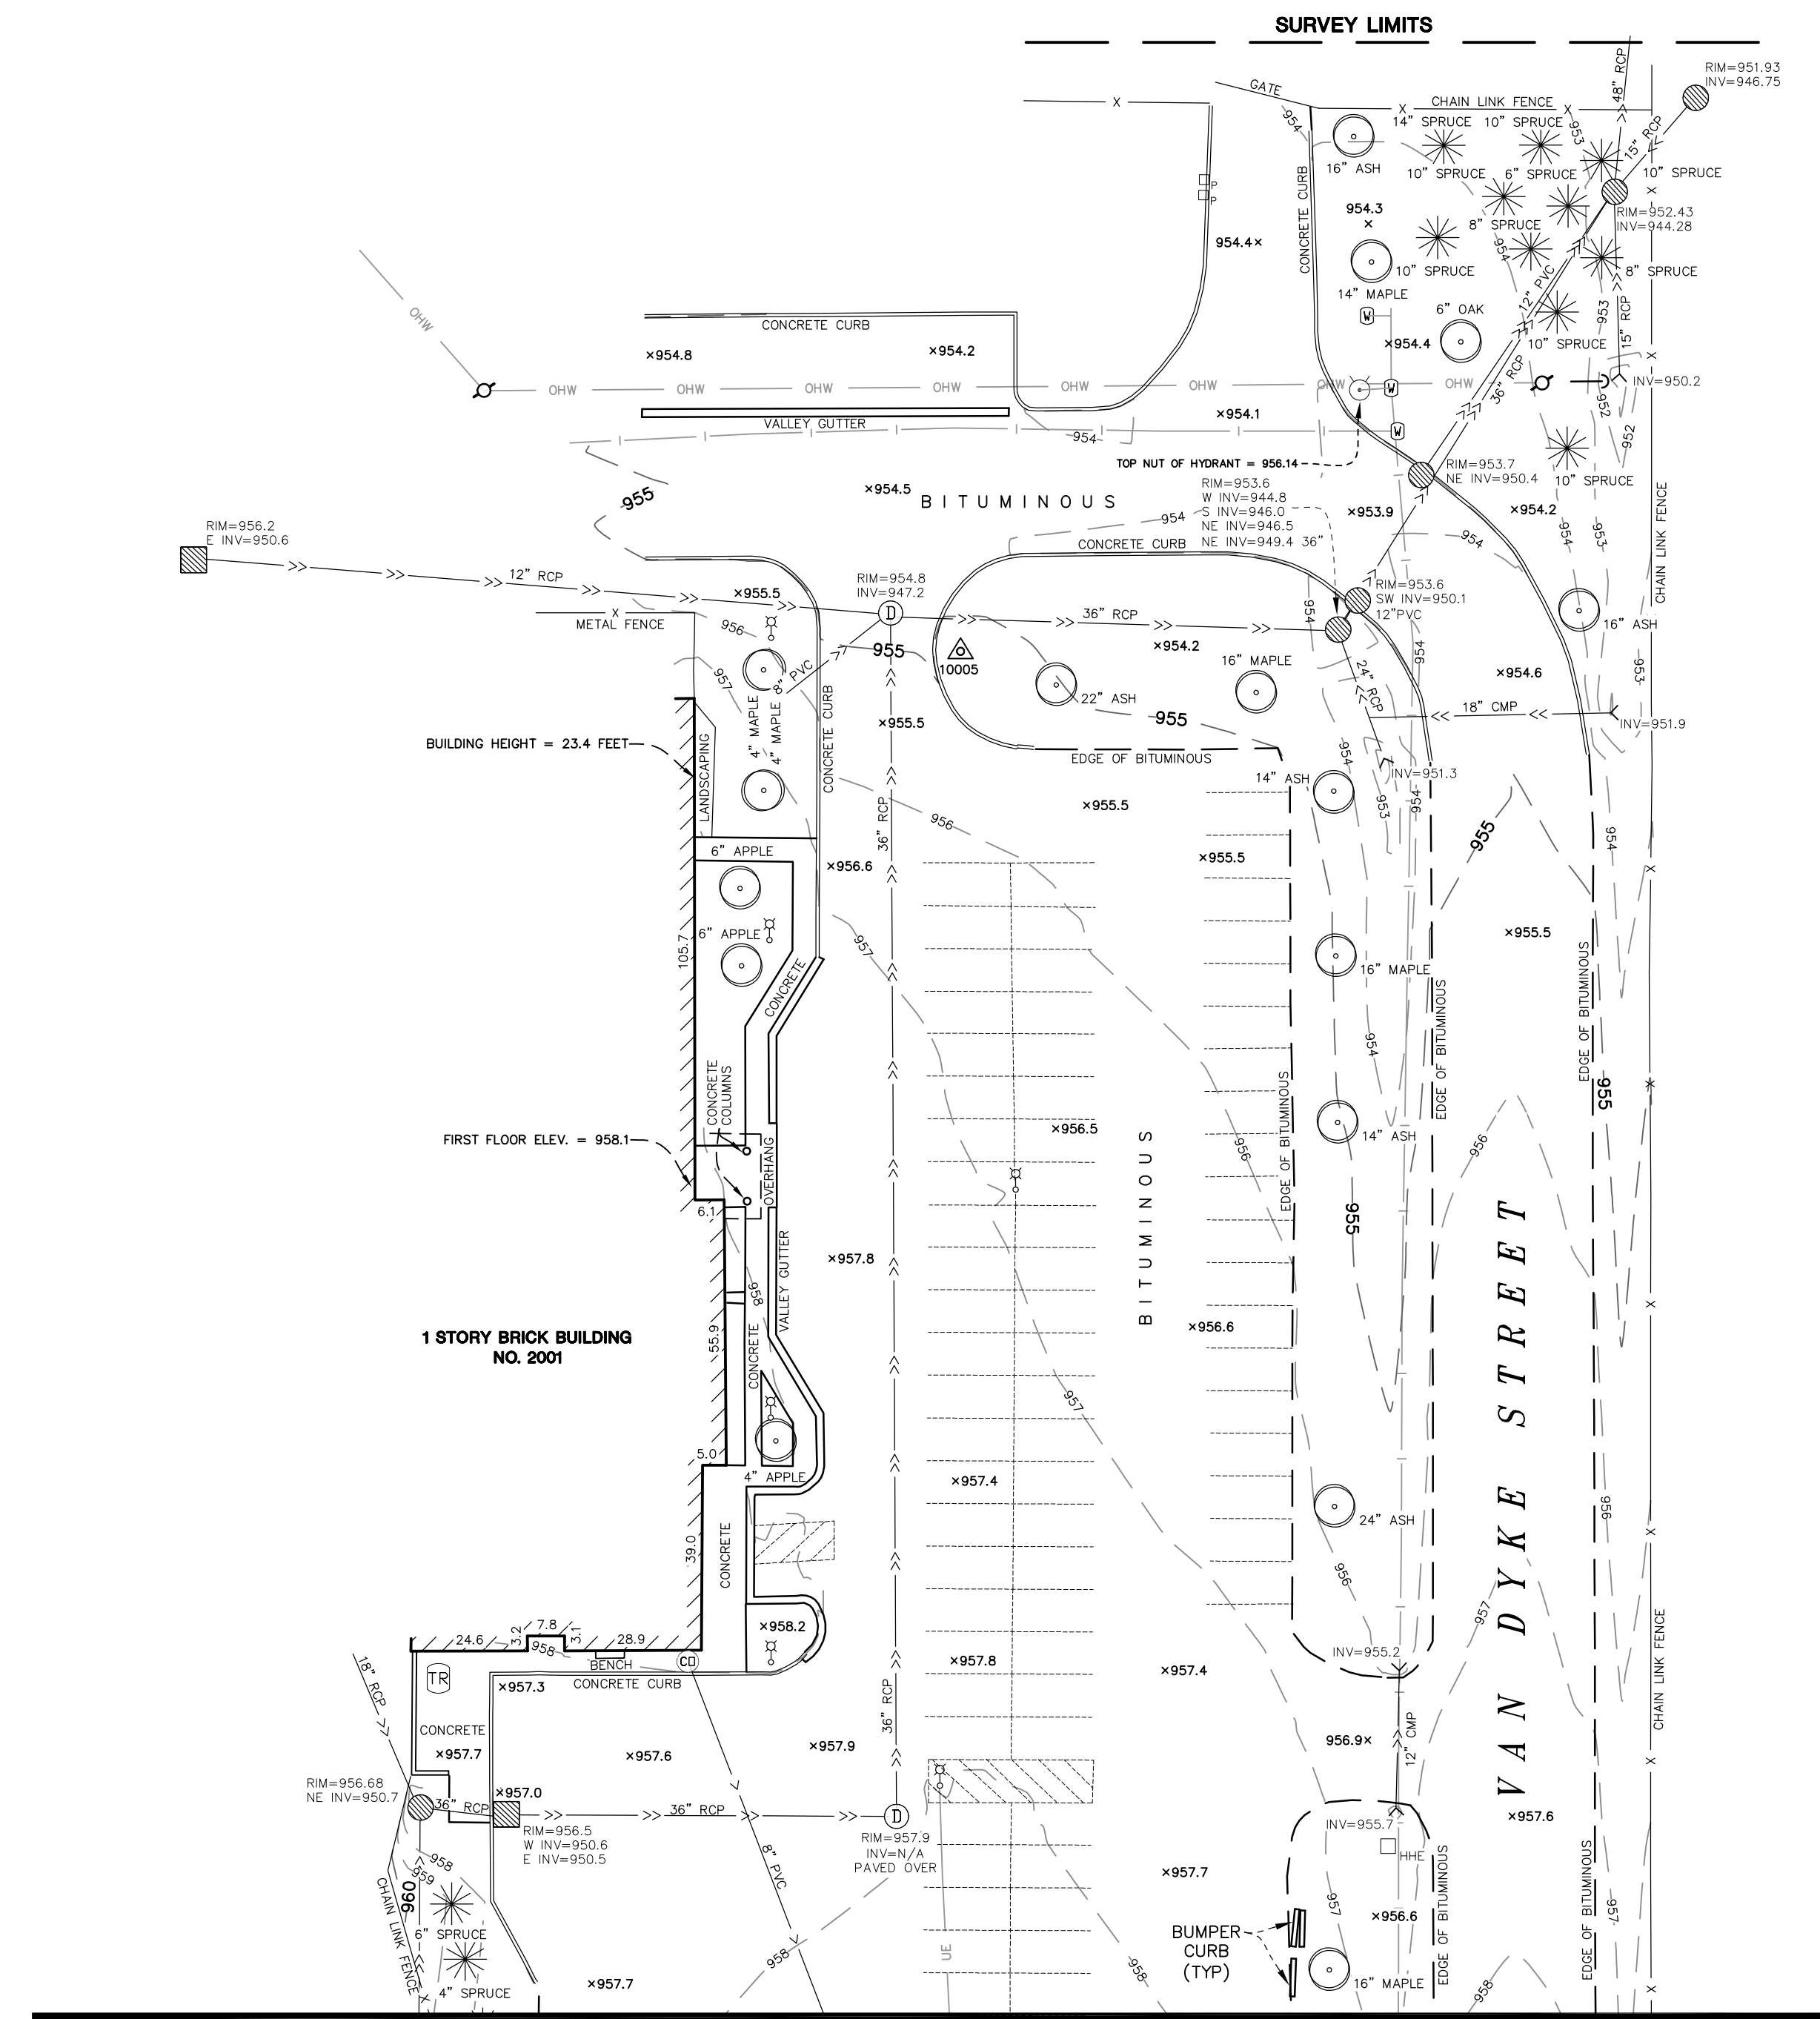

Anderson Engineering of Minnesota, LLC
 13605 1st Avenue North
 Suite 100
 Plymouth, MN 55441
 763-412-4000 (c) 763-412-4090 (f)
 www.ae-mn.com